


60
58
59

70 80 84 86 80 76 74
81 83 81 79 75 73

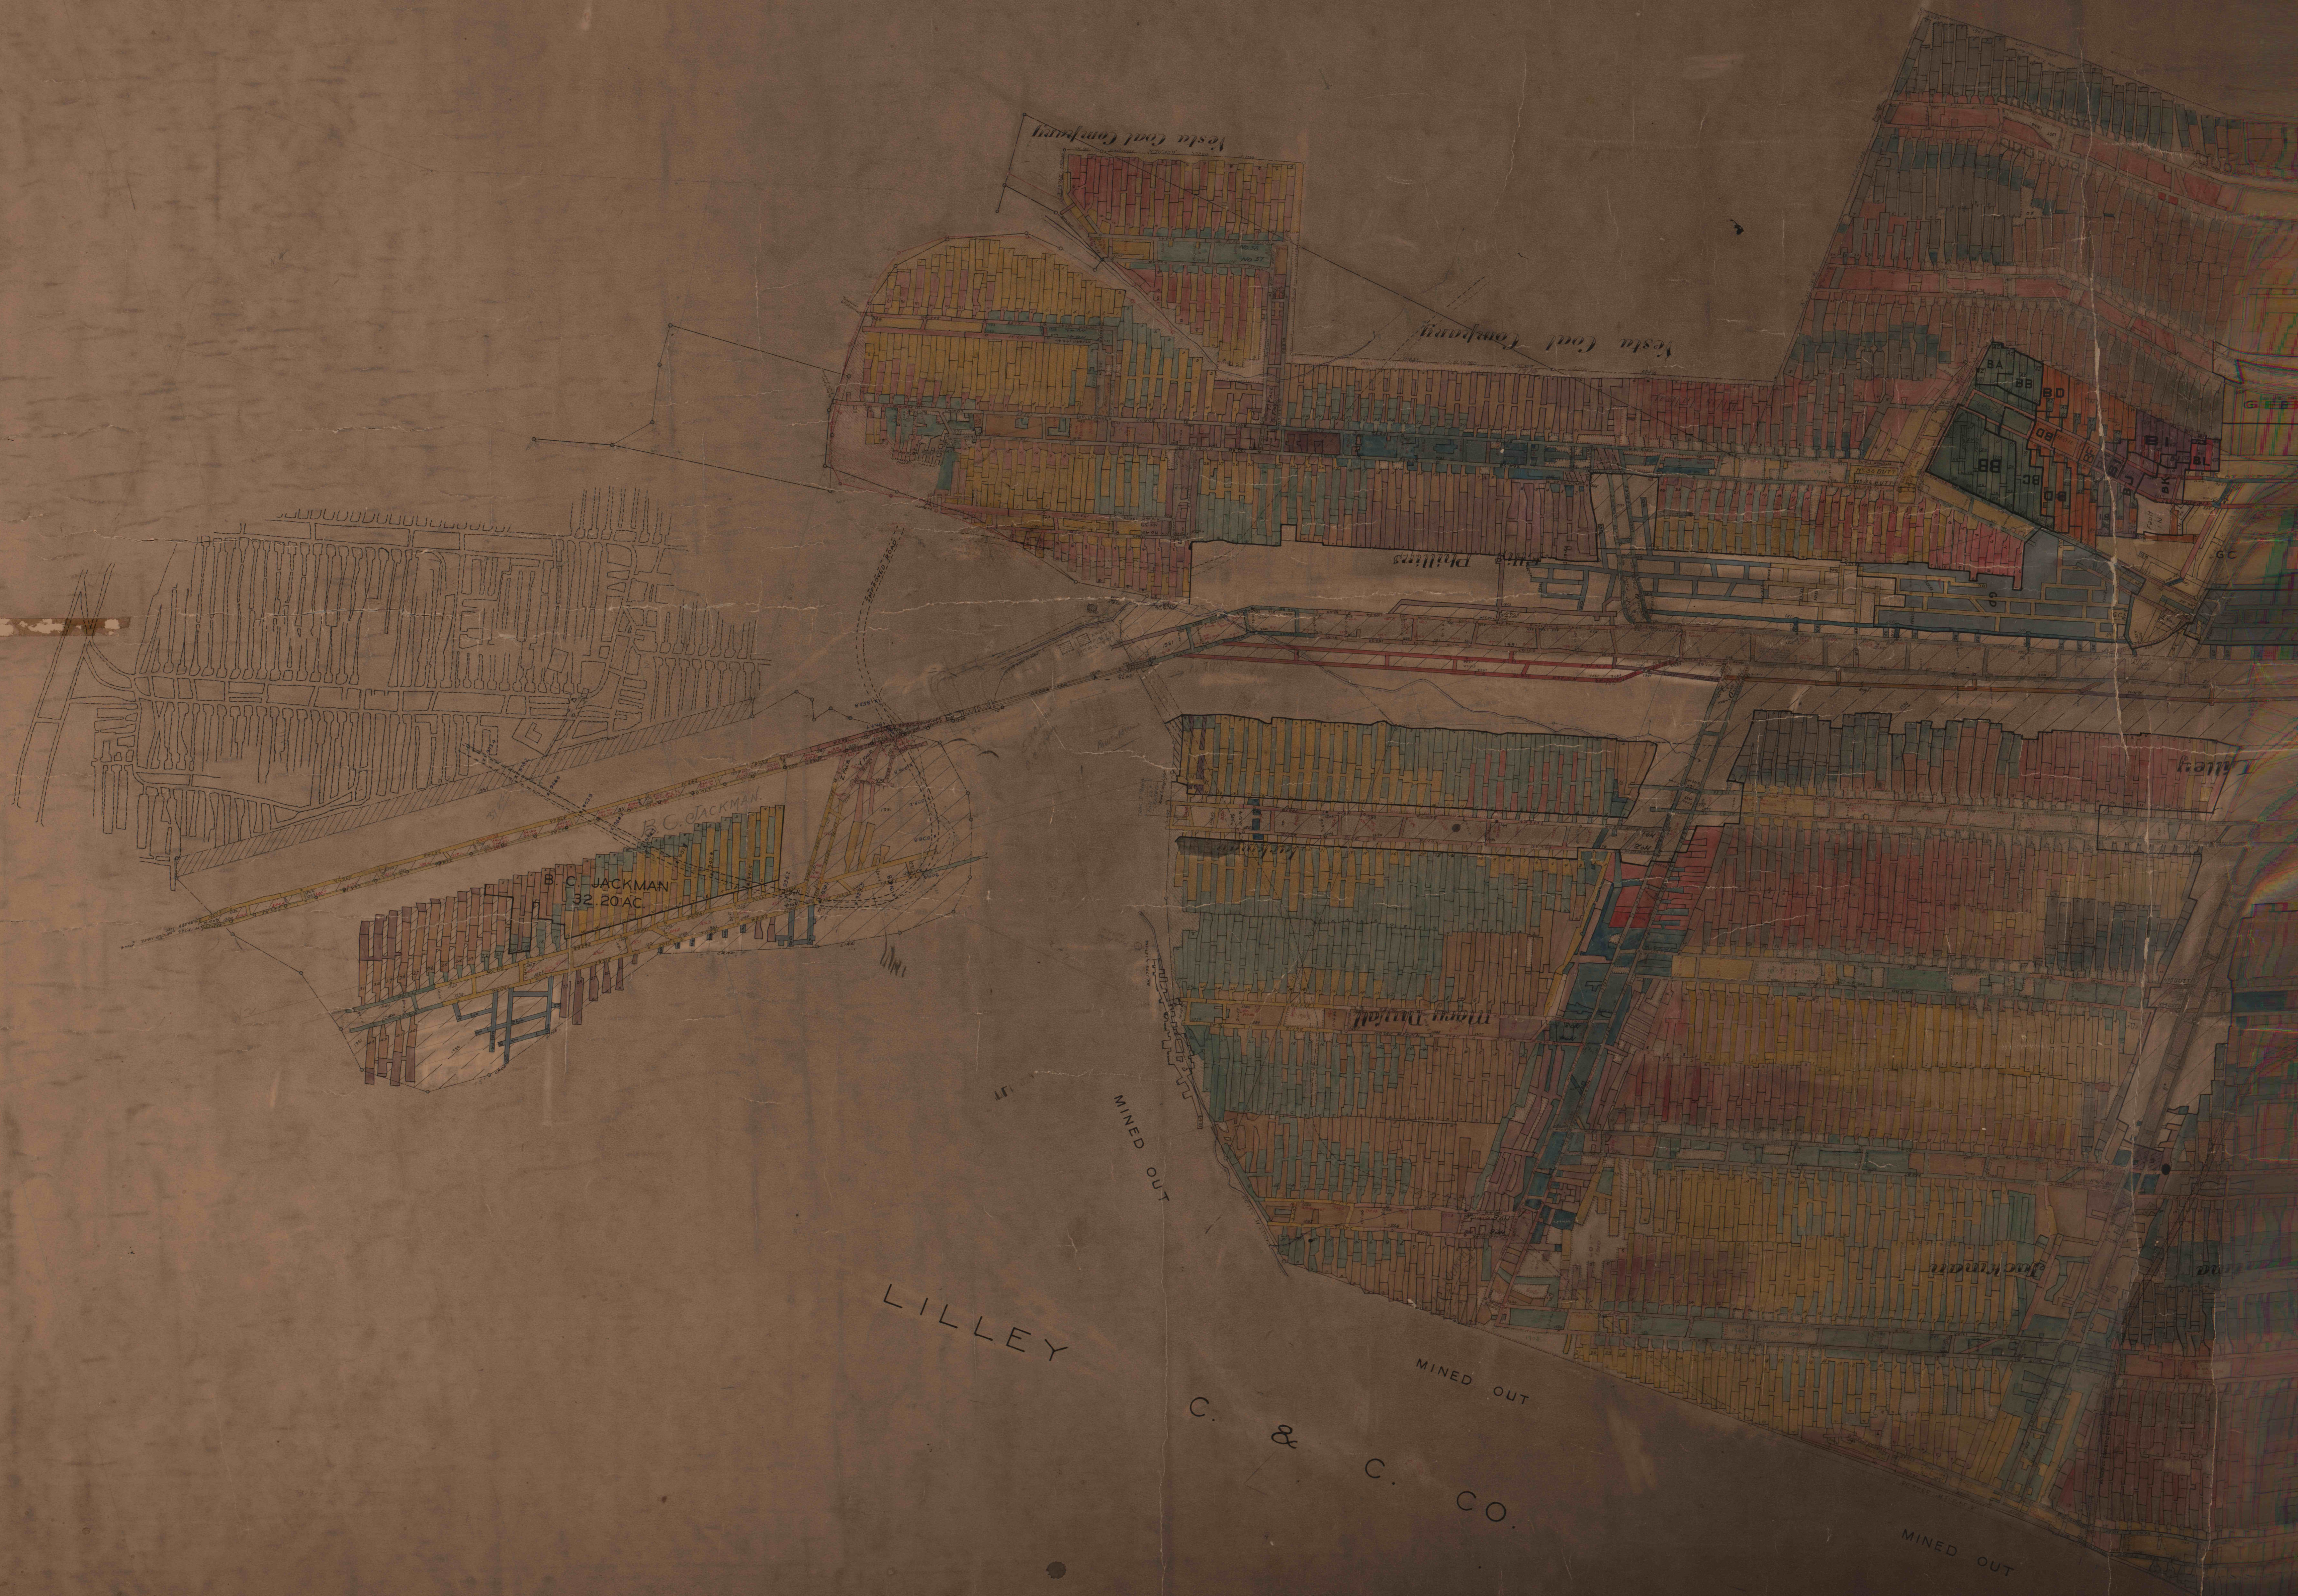

58
60
59
61