
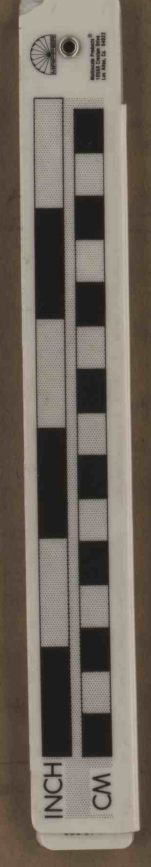


See 480-0-3 For adjoining map

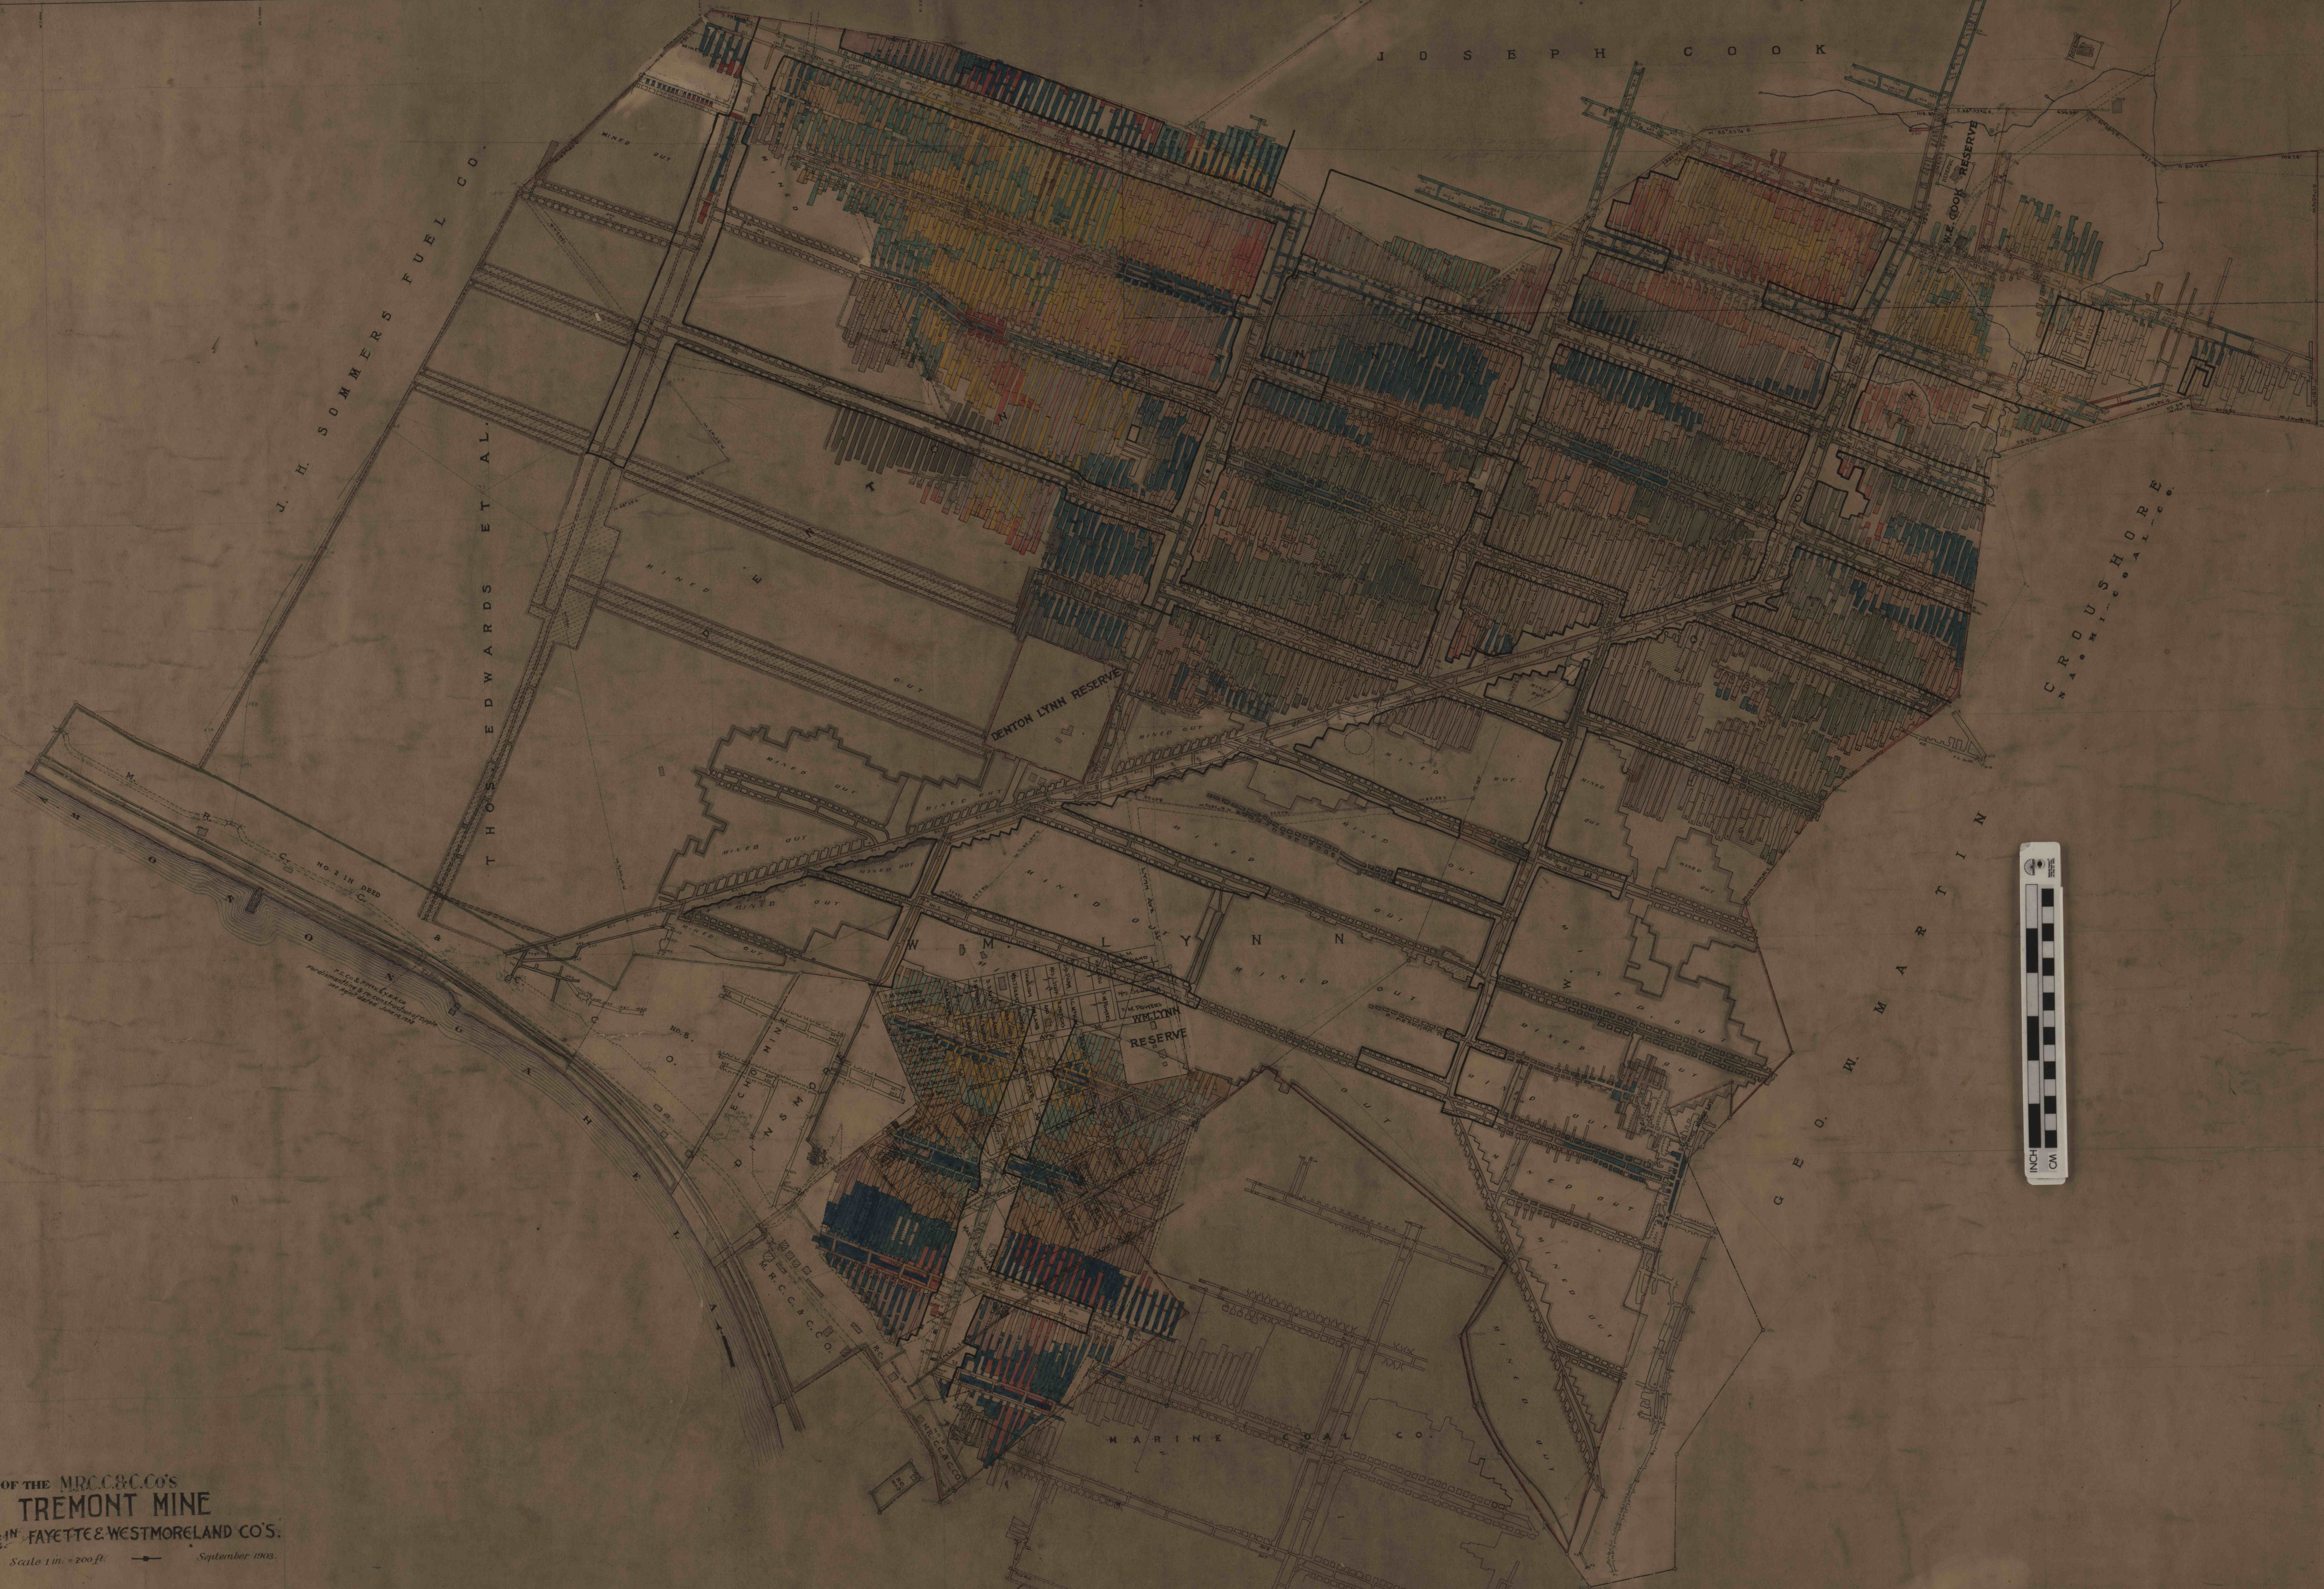

PLAN OF THE MRC.C.&C.'S
TREMONT MINE
 SITUATE IN FAYETTE & WESTMORELAND CO'S.
 Scale 1 in. = 200 ft. September 1905.