

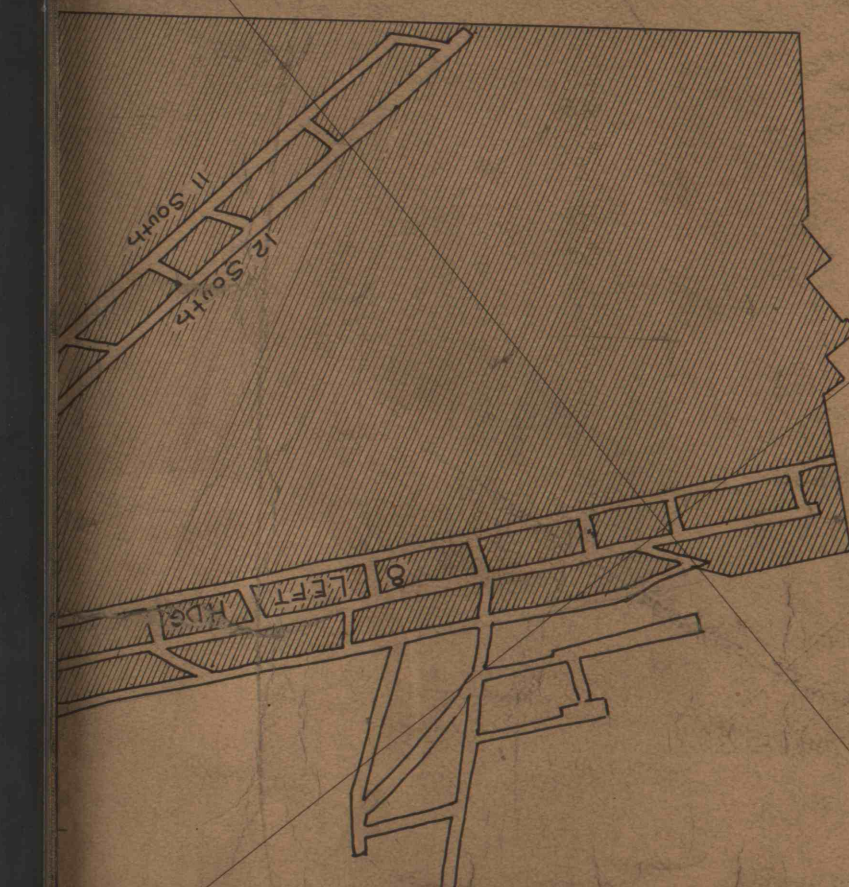


1580  
1570  
1560  
1550  
1540  
1530  
1520  
1510  
1500  
1490  
1480  
1470  
1460  
1450  
1440  
1430  
1420  
1410  
1400  
1390  
1380  
1370

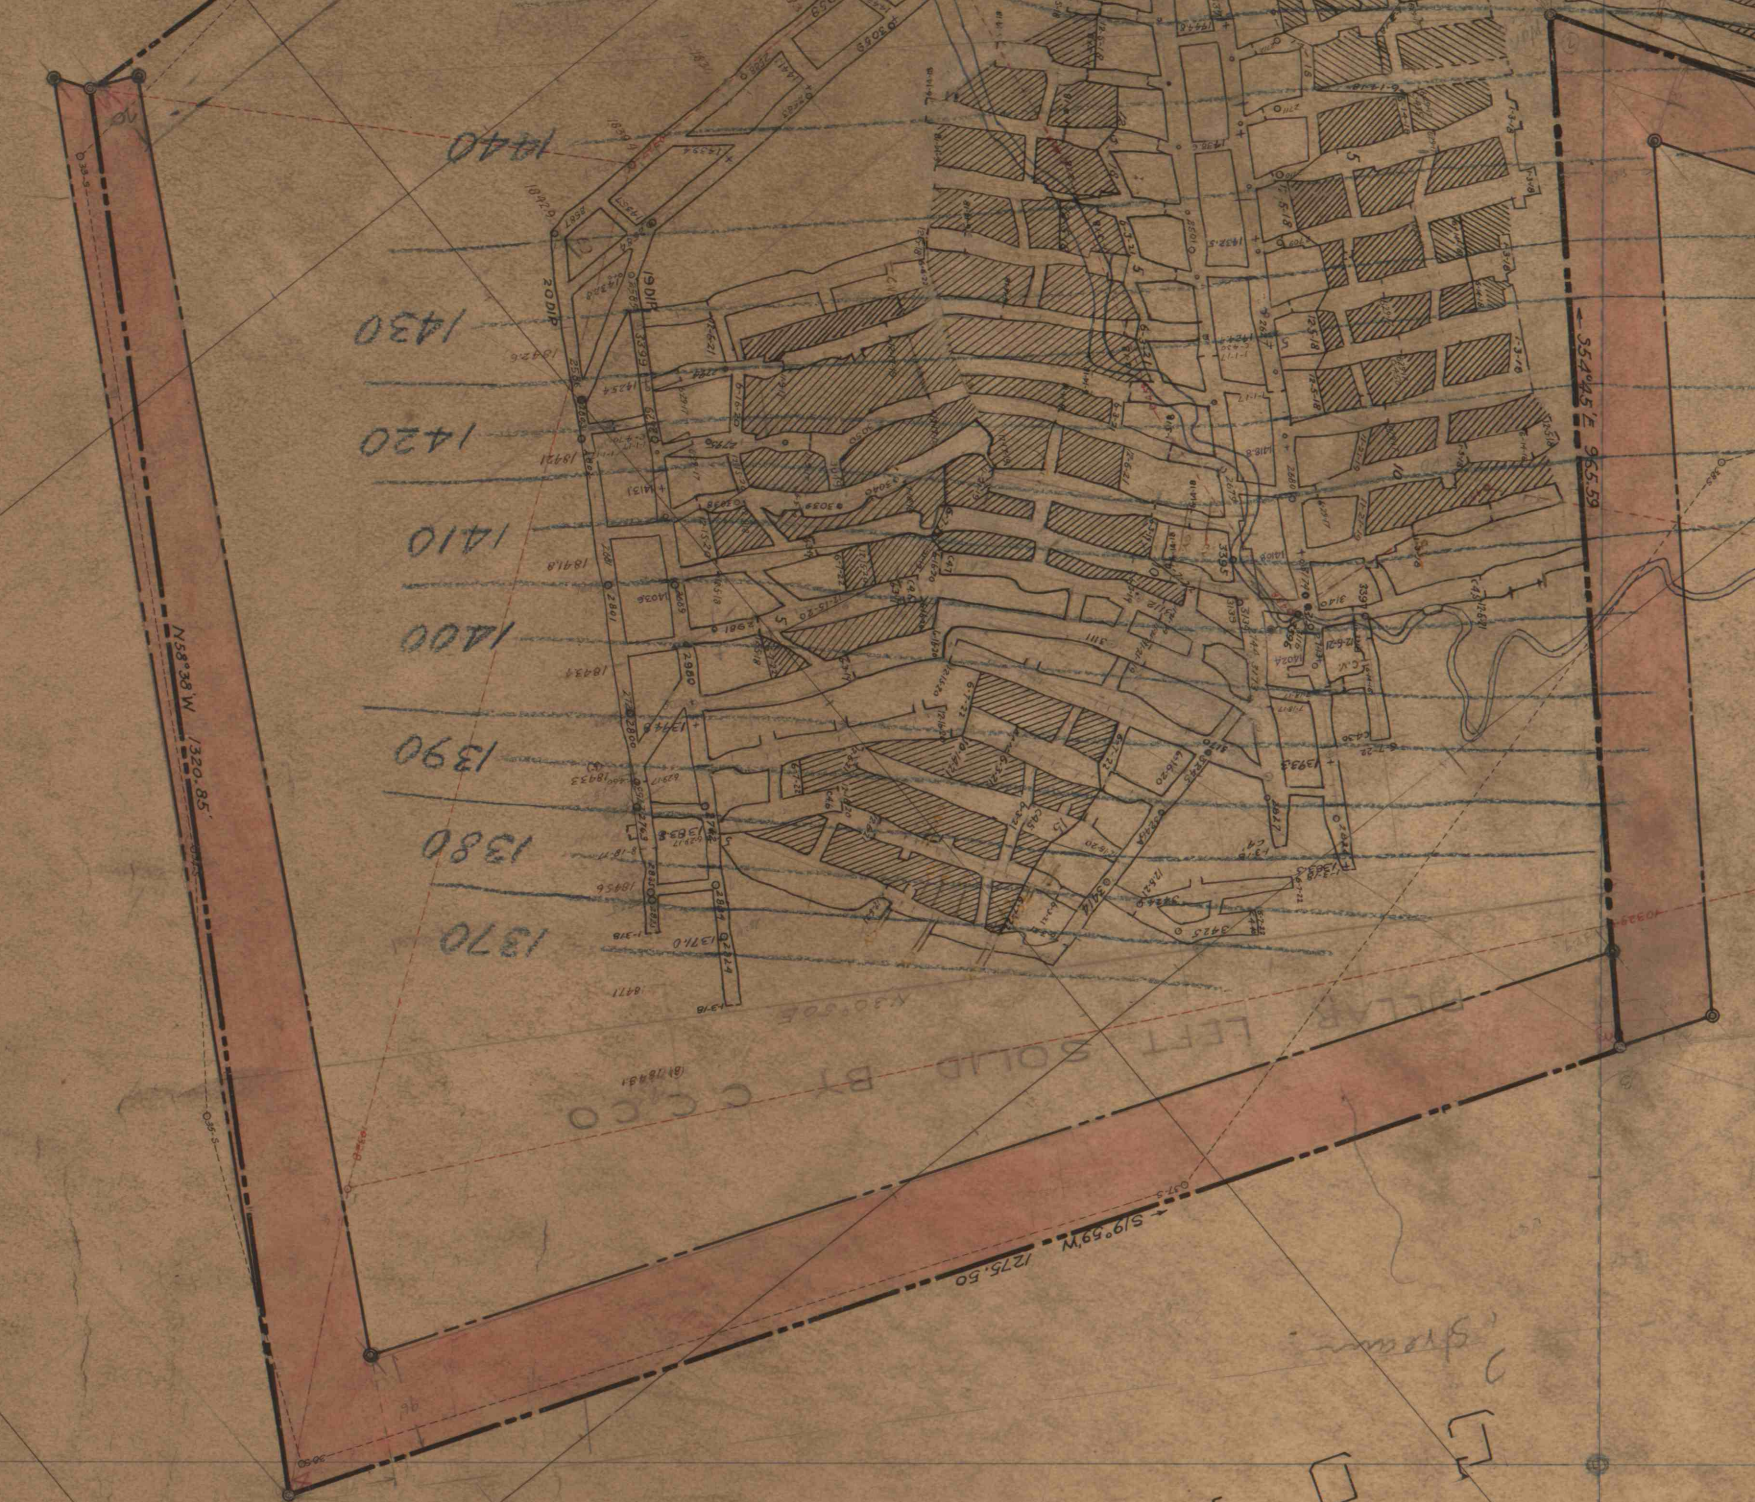

2  
3  
4  
5  
6  
7  
8  
9  
10  
11  
12


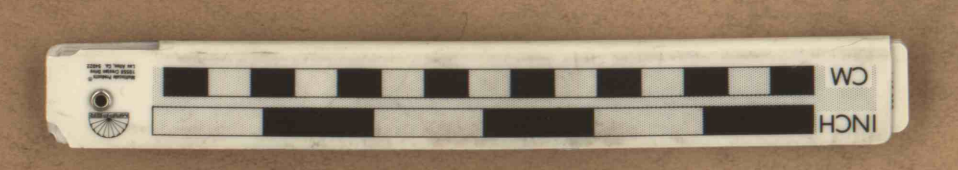

G. R. MAYER

B. LYON  
MAYER

A. B. J. J. SK

G. FRIEDLIN

GED. M. FREIDLIN

ED. P. SIFE

H. W. MAUER NO. 1

H. C. SHAFER NO. 2

JOHN RINK

A. R. YOUNG

S. J. NEED

J. RABCH