


60-1-61

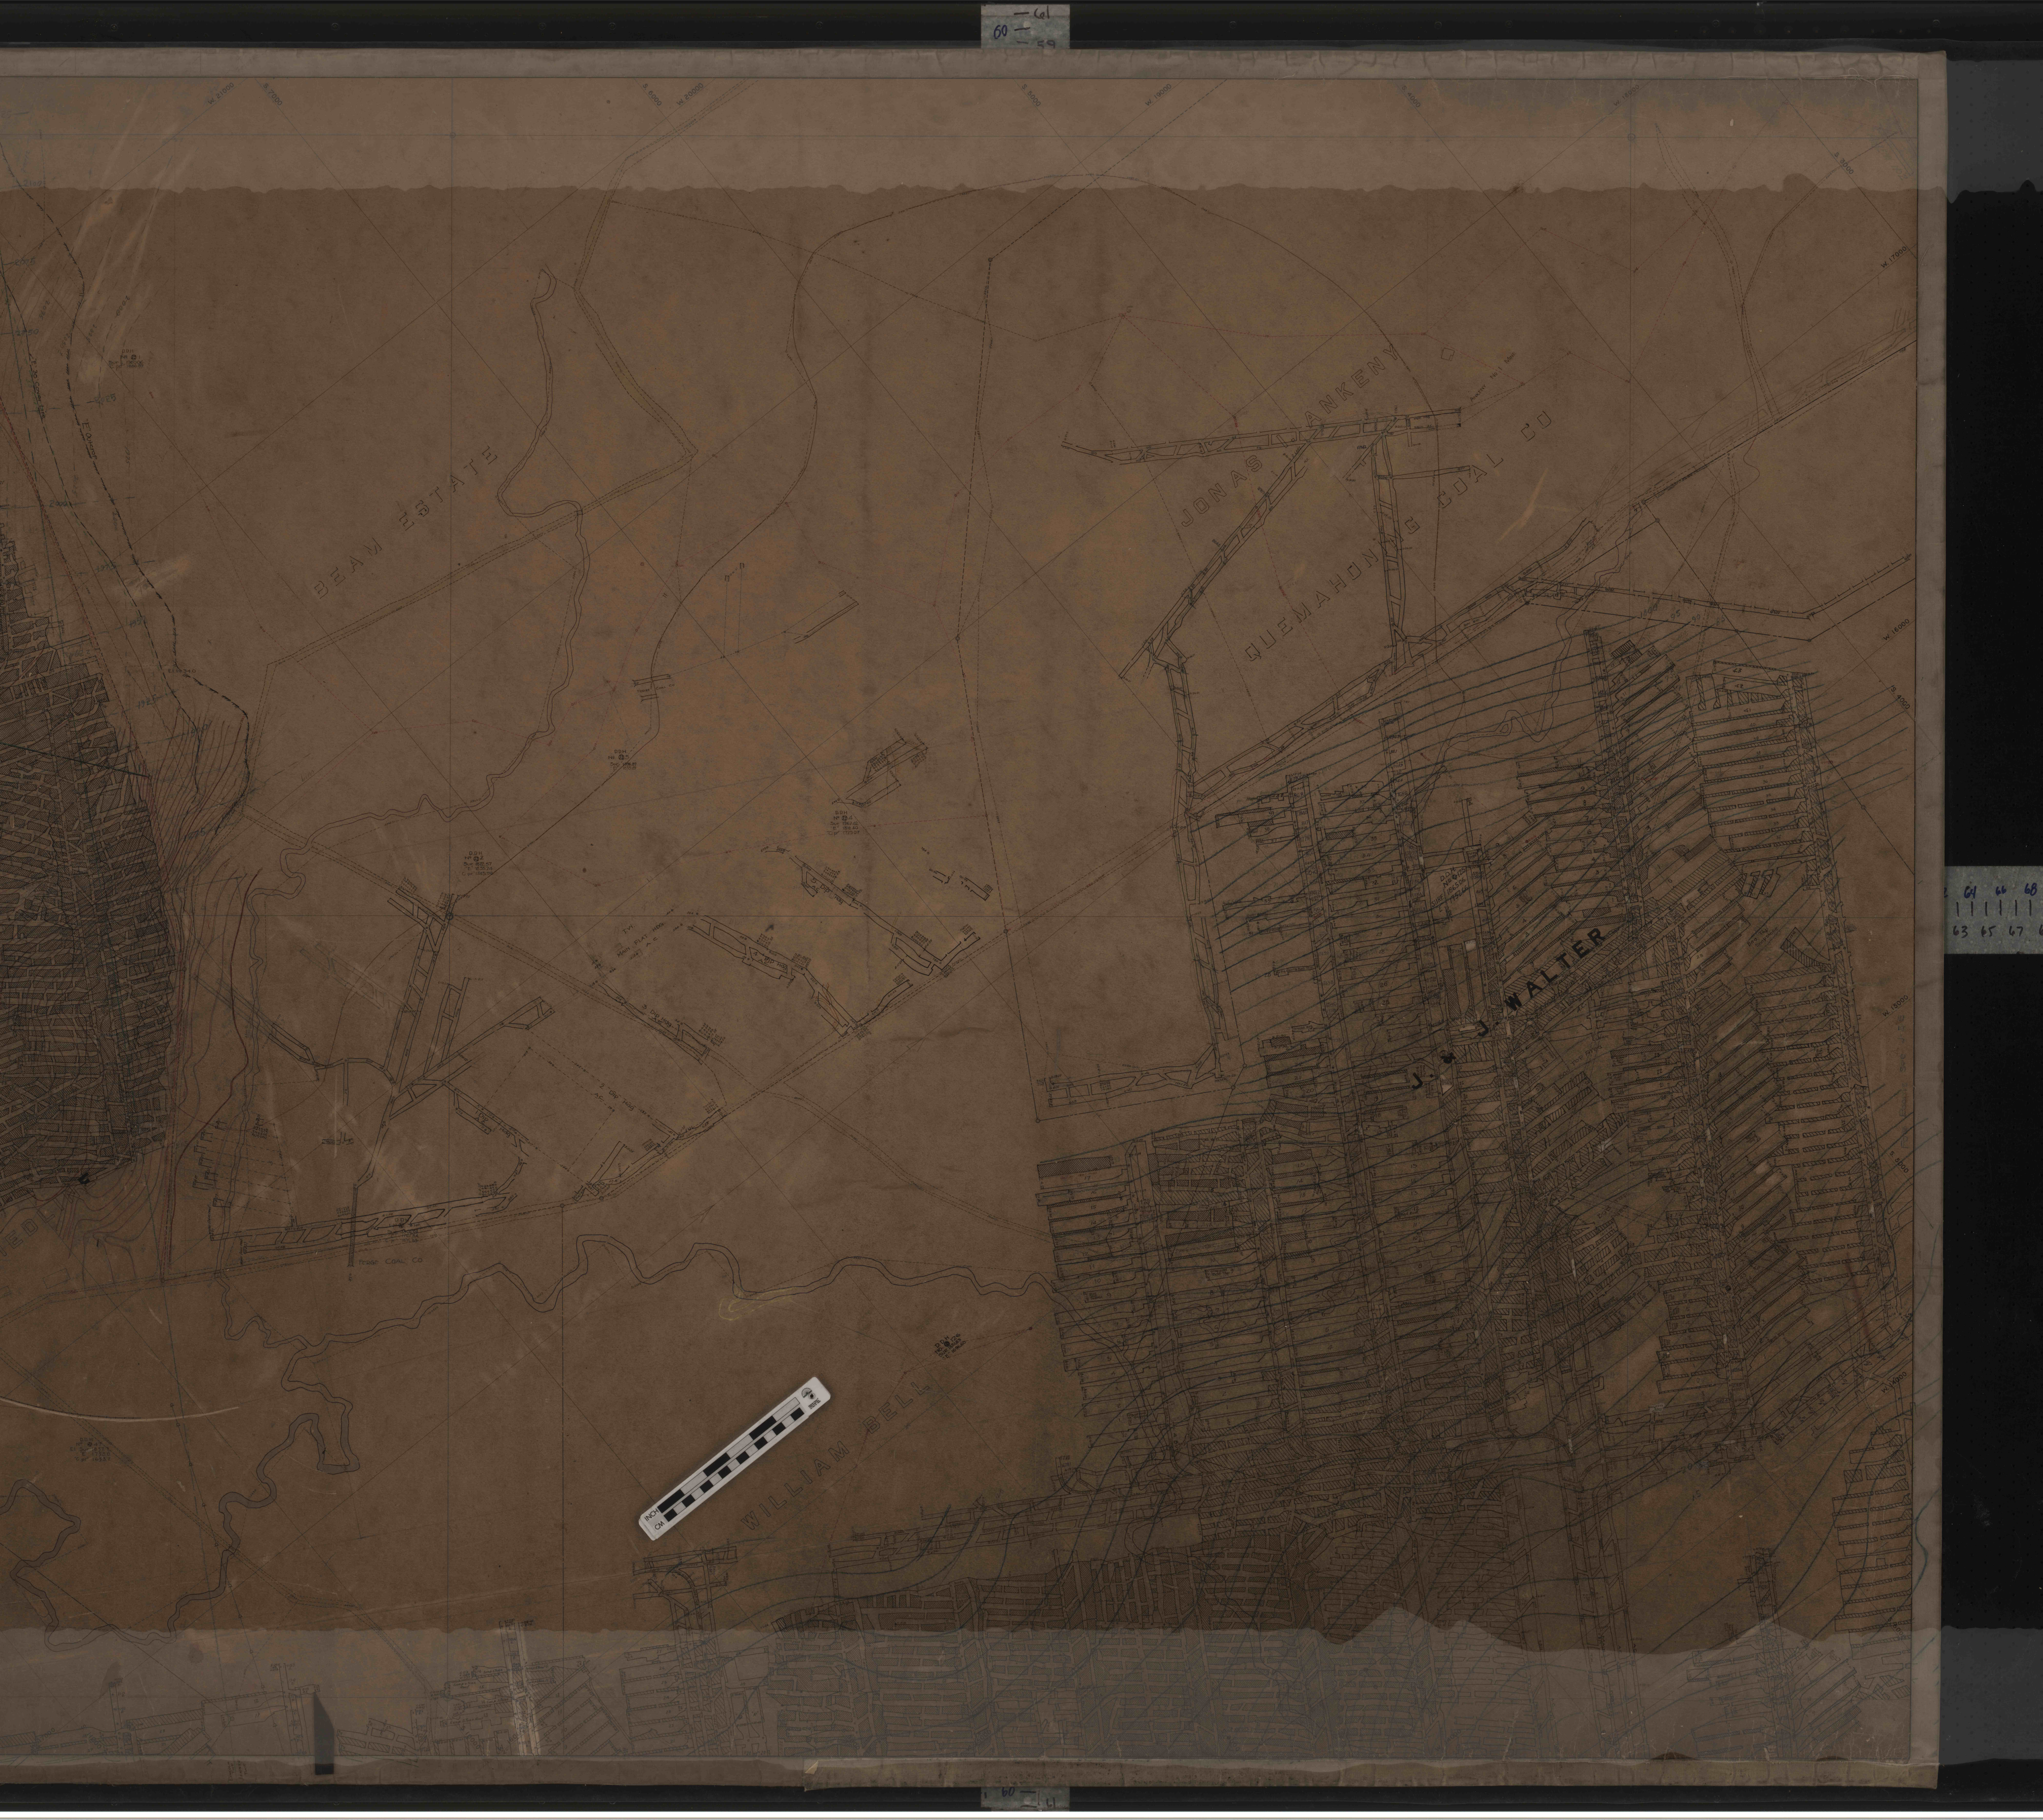

61 62 63
64 65 66 67