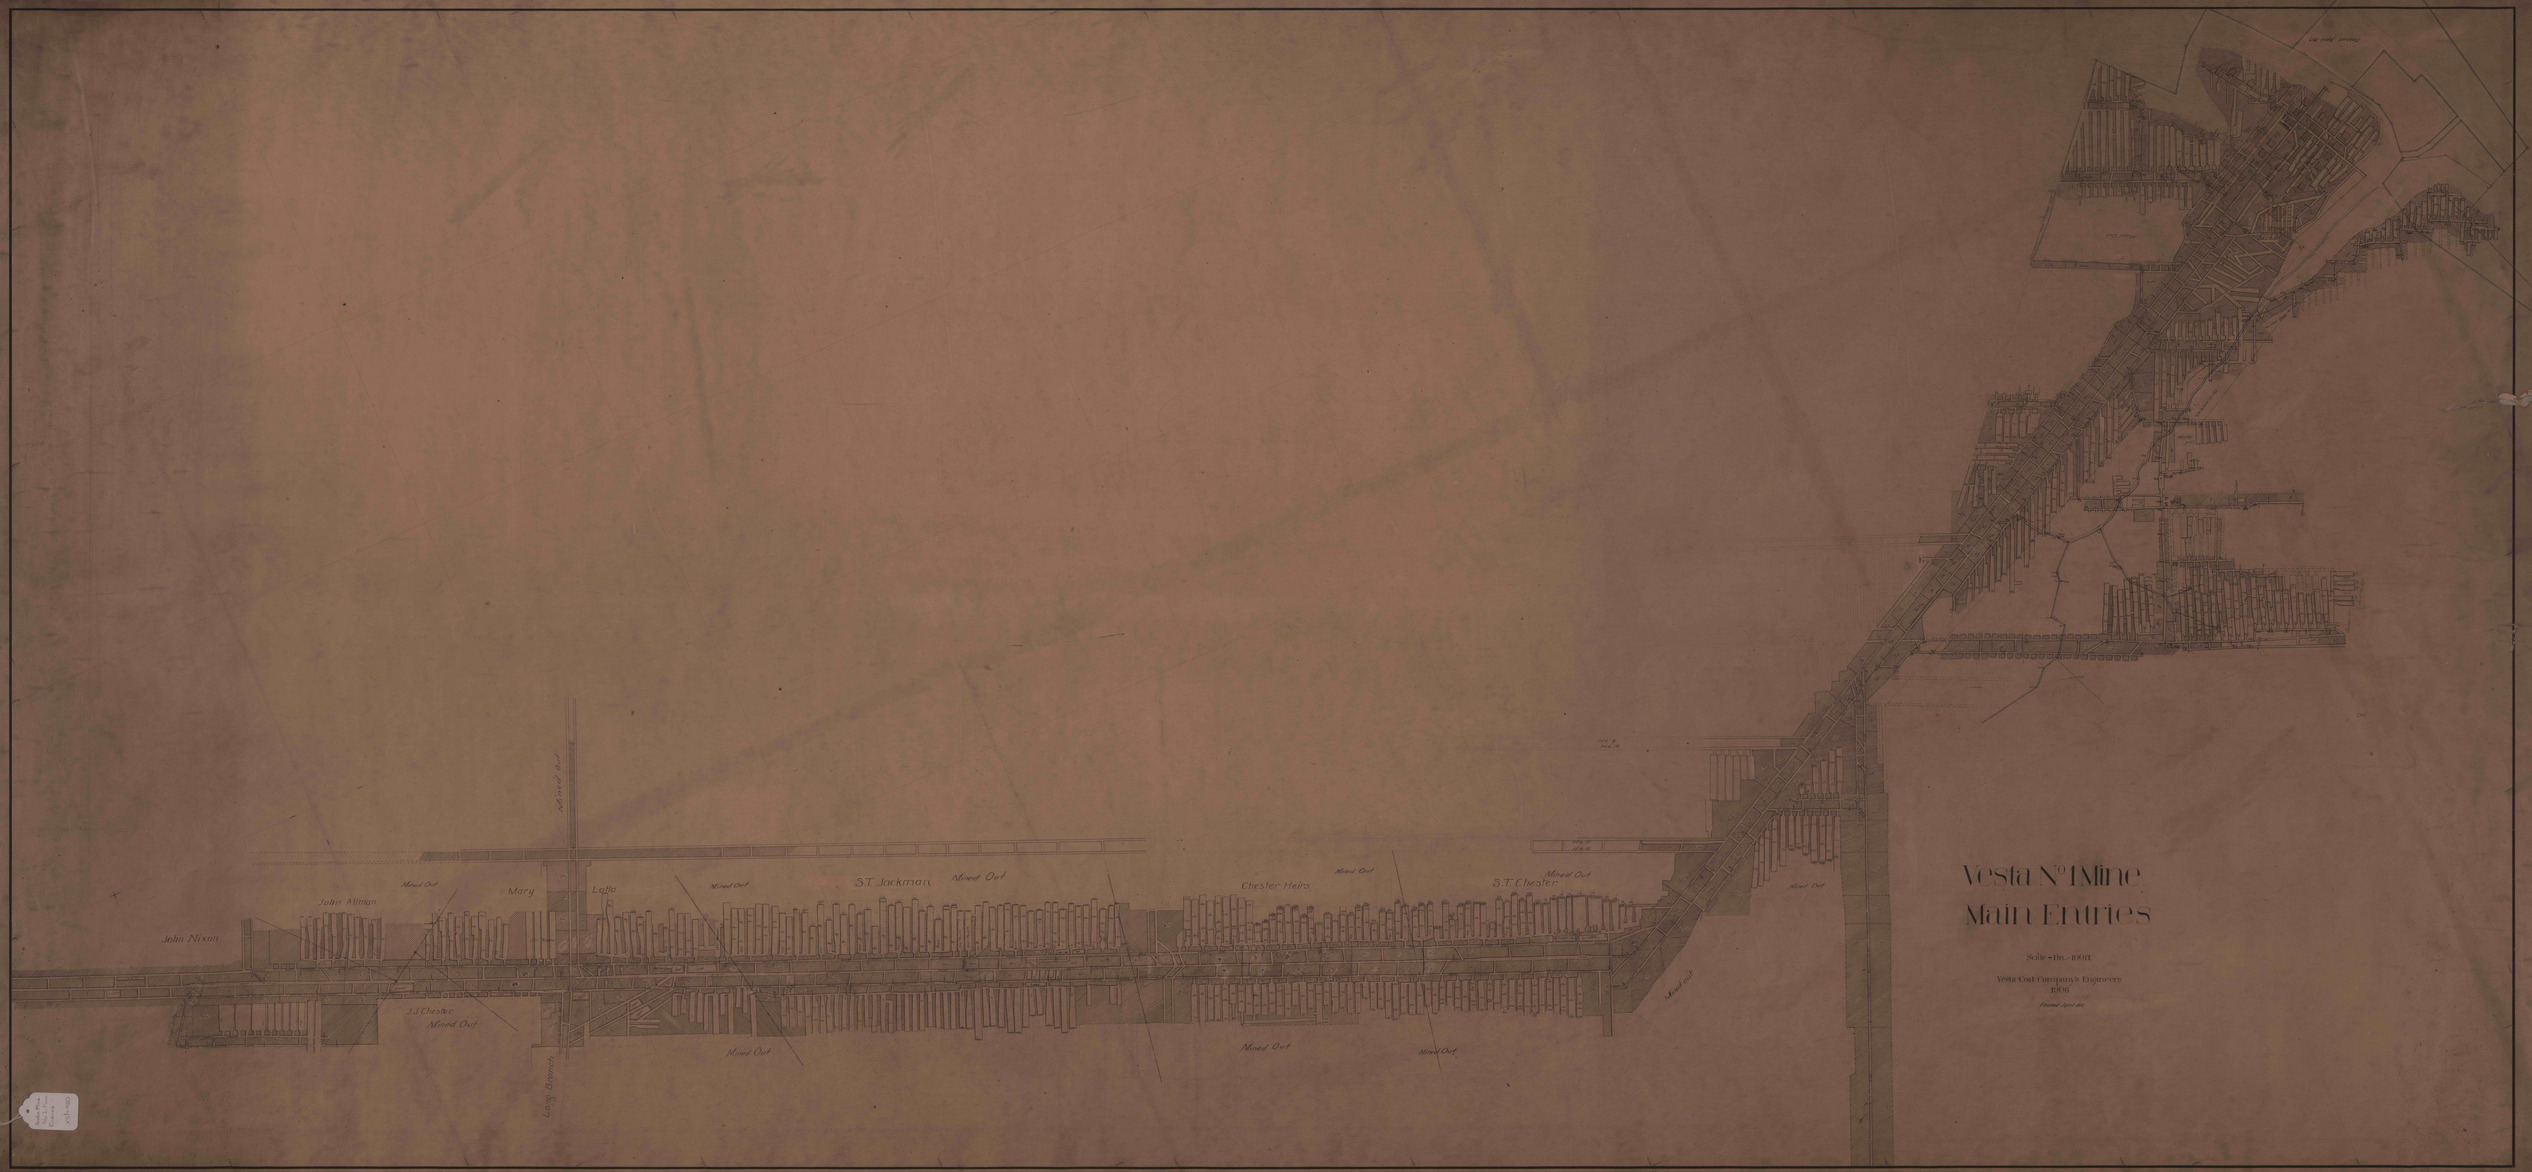
Vesta No. 1 Mine
Main Entries
Scale = 1in. = 100ft.
Vesta Coal Company's Engineers
1906
John Nixon
John Allman
Mined Out
Mary
Lafie
S.T. Jackman
Chester Heirs
S.T. Chester
J.J. Chester
Long Drain