
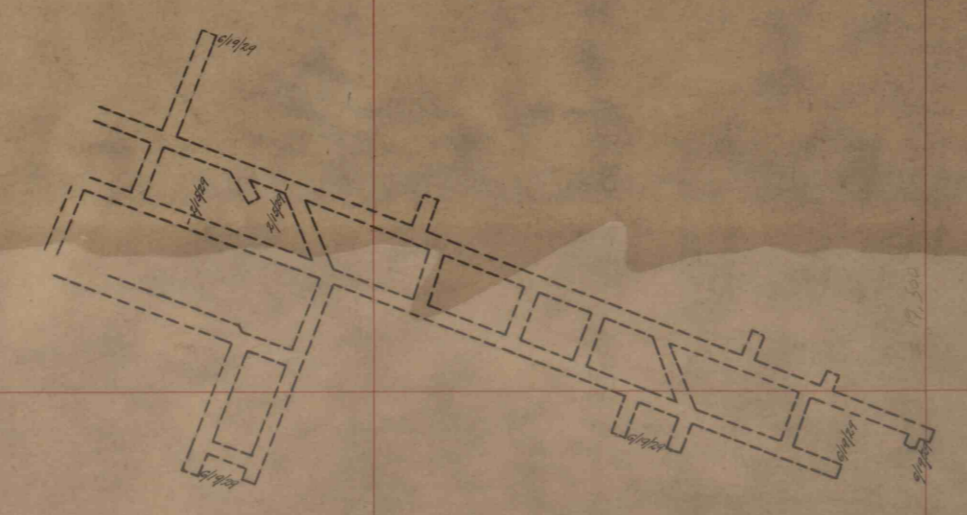
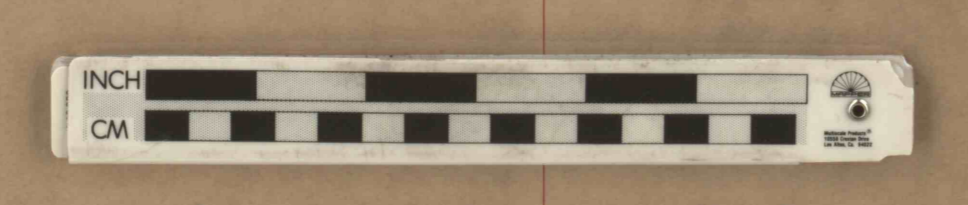


60
59
58
57

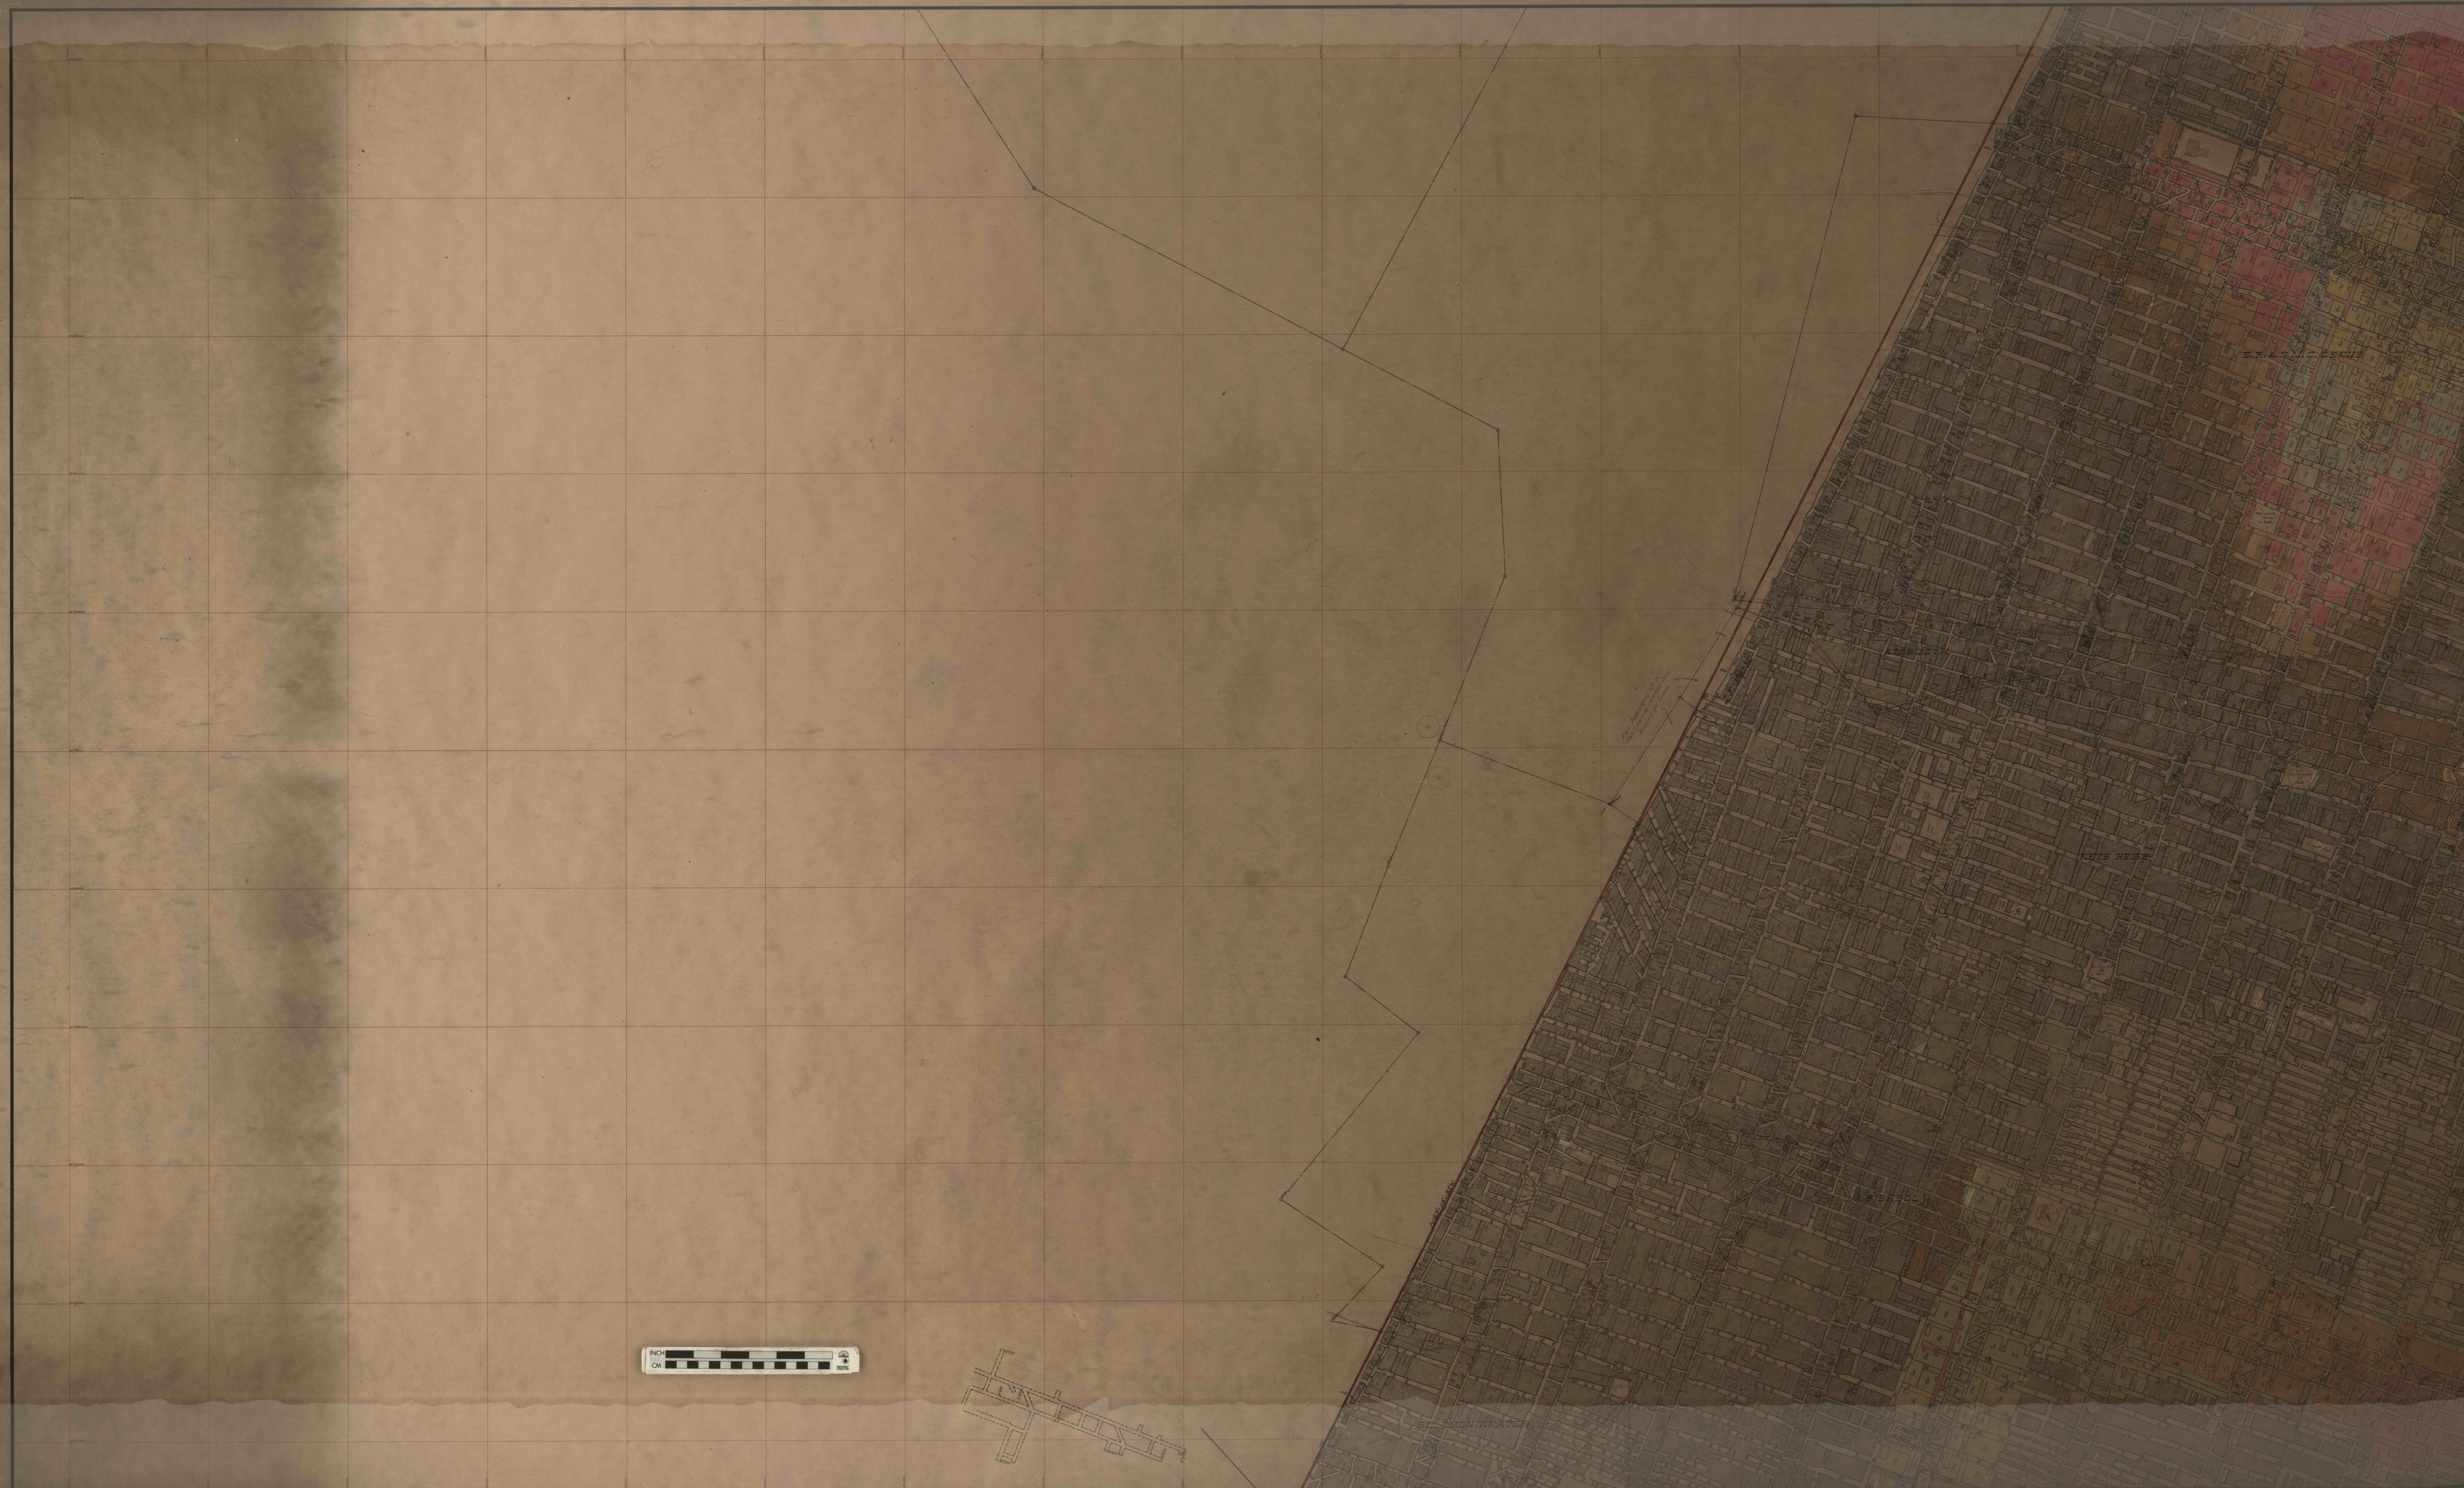

60