


60  
59 59

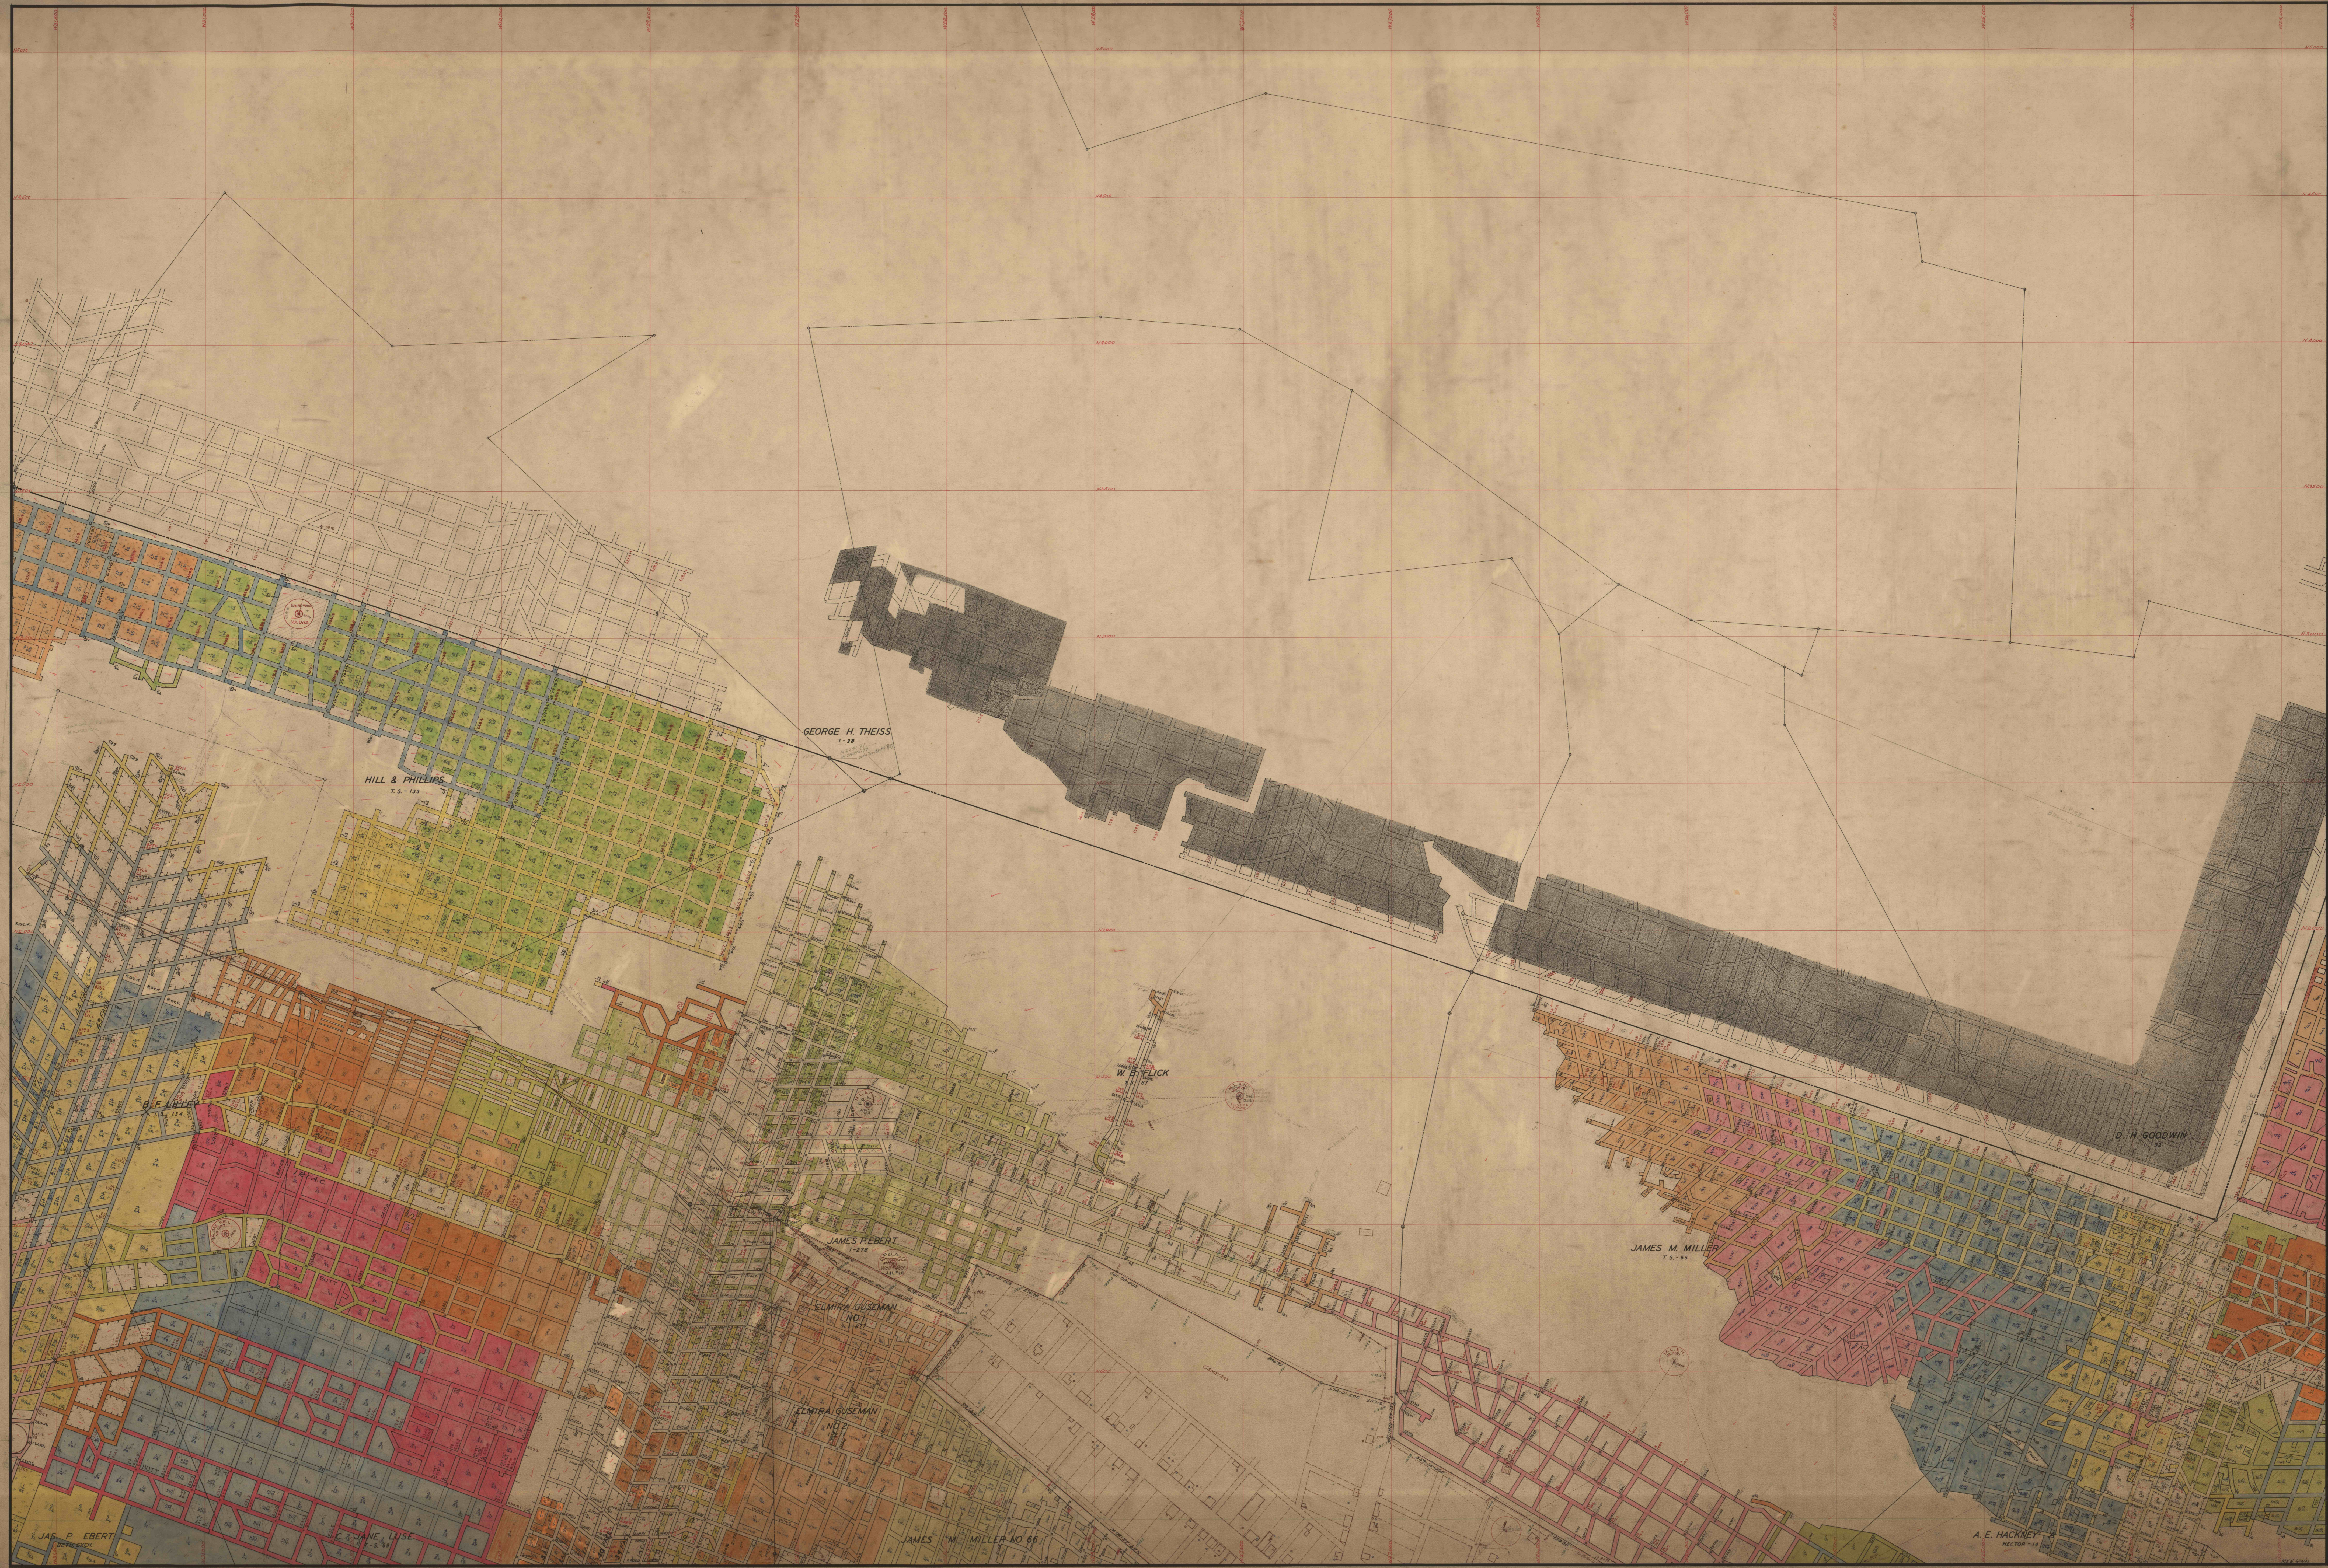

60 59  
57 59

INCH  
CM

60 59