



60
58

58

92

Nº 4 MINE
4TH HILL MAP Nº 2
SCALE 1 IN = 100 FT ENG DEPT V. C. CO.
JAN. 19 - 1911

390610

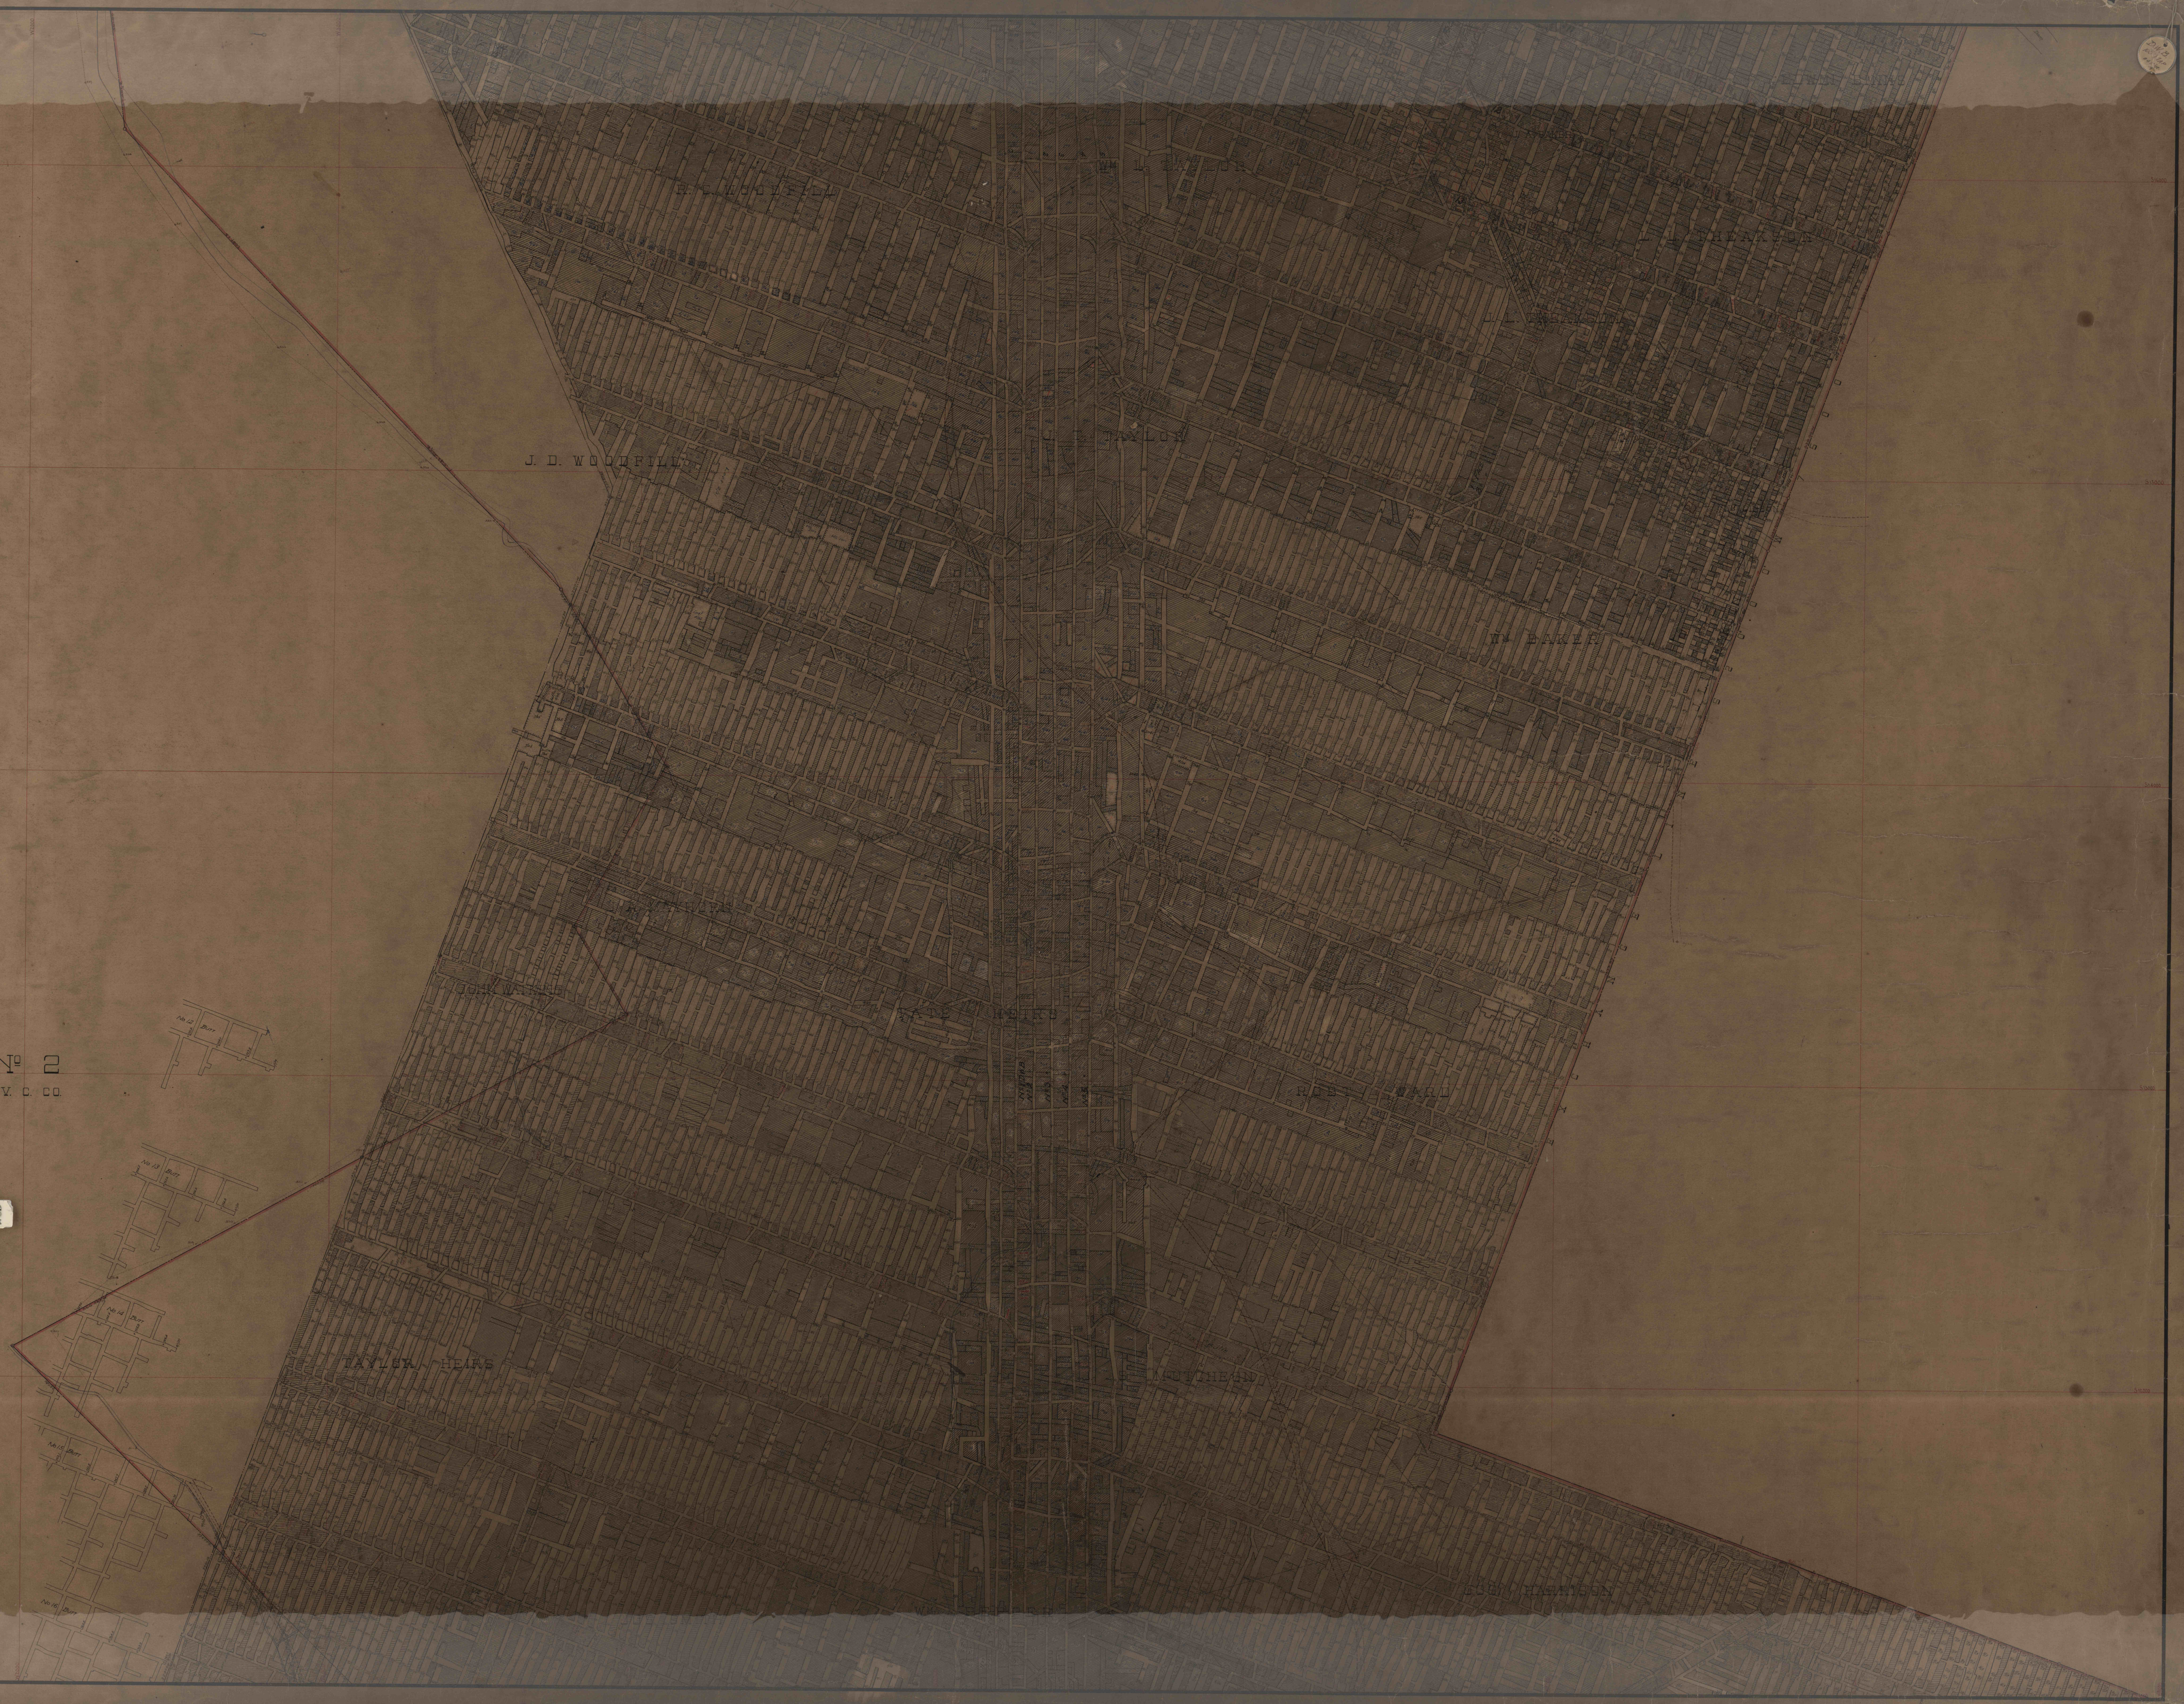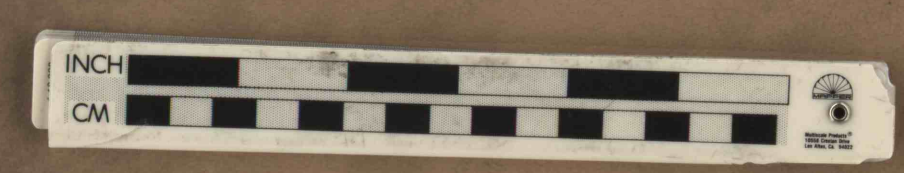

58
60