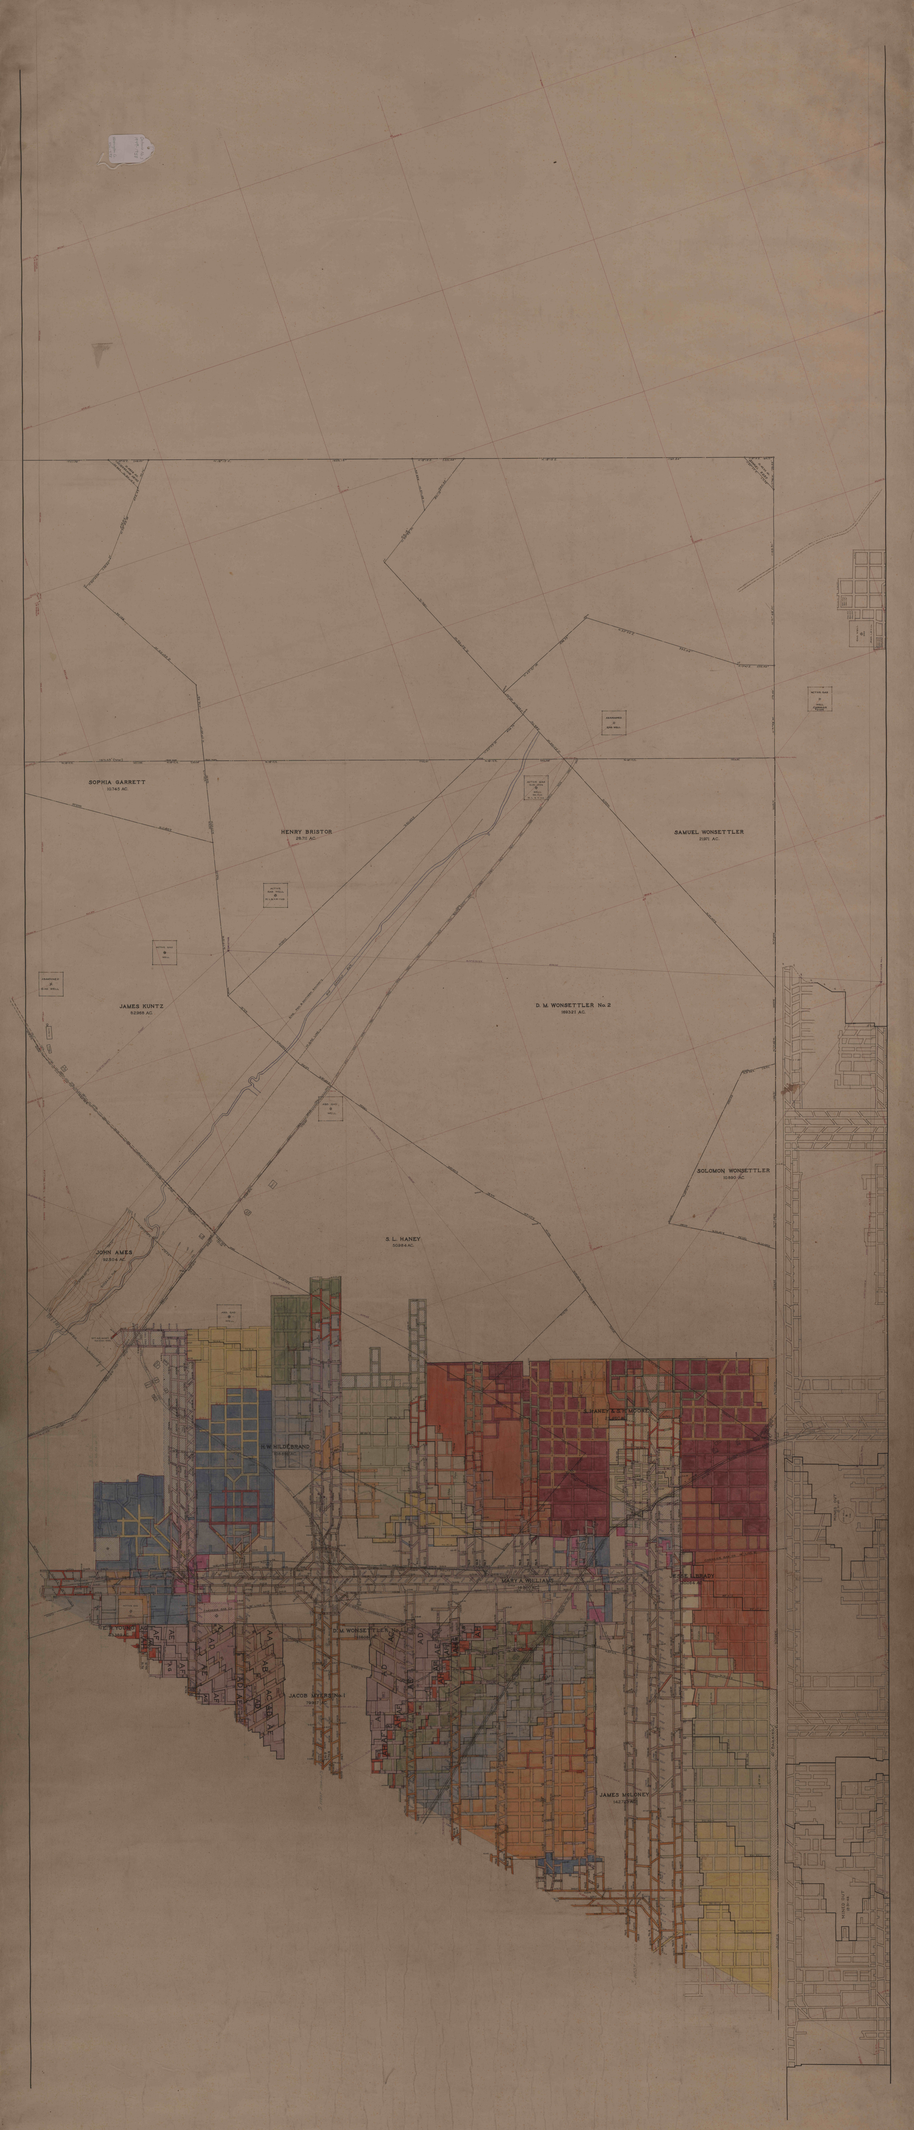
SOPHIA GARRETT
10.745 AC.
HENRY BRISTOR
28.11 AC.
SAMUEL WONSETTLER
13.91 AC.
JAMES KUNTZ
82.98 AC.
D. M. WONSETTLER No. 2
188.321 AC.
SOLOMON WONSETTLER
11.80 AC.
S. L. HANEY
30.64 AC.
JOHN AMES
10.84 AC.
H. W. WILDERRAND
JACOB WEYERMAN
JAMES MILONEY
MARY A. WILLIAMS