


CROW COAL  
AND  
PRESENT WORKINGS  
OF  
VESTA N° 1 MINE

SCALE 1/4" = 100 FT 1904

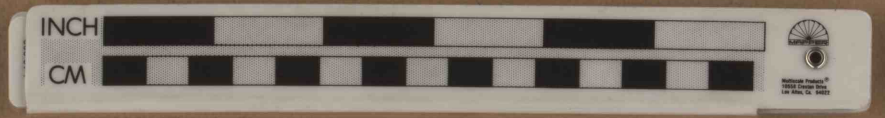

M.R.C. & C. CO.  
LONDON

2 60  
1 1  
61 9

60  
1 1  
59

34 -  
35 -  
36 -