


60
58-59

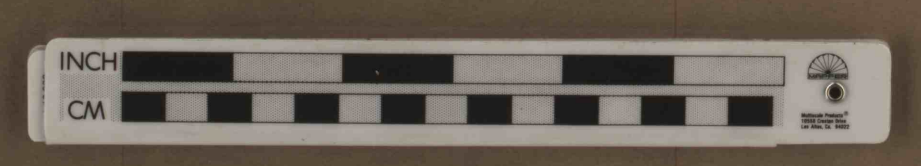

RELIANCE
COKE
COMPANY



VESTA N° 7 MINE

ENGR. DEPT V. C. CO. FEB. 22 1918

ABANDONED DEC. 8 1923

SCALE 1"=100'

50
59
60-11

68
67

68
67