


56-59  
58-57  
56


H. C. FRICK  
COKE  
COMPANY - MARGUERITE  
MINE

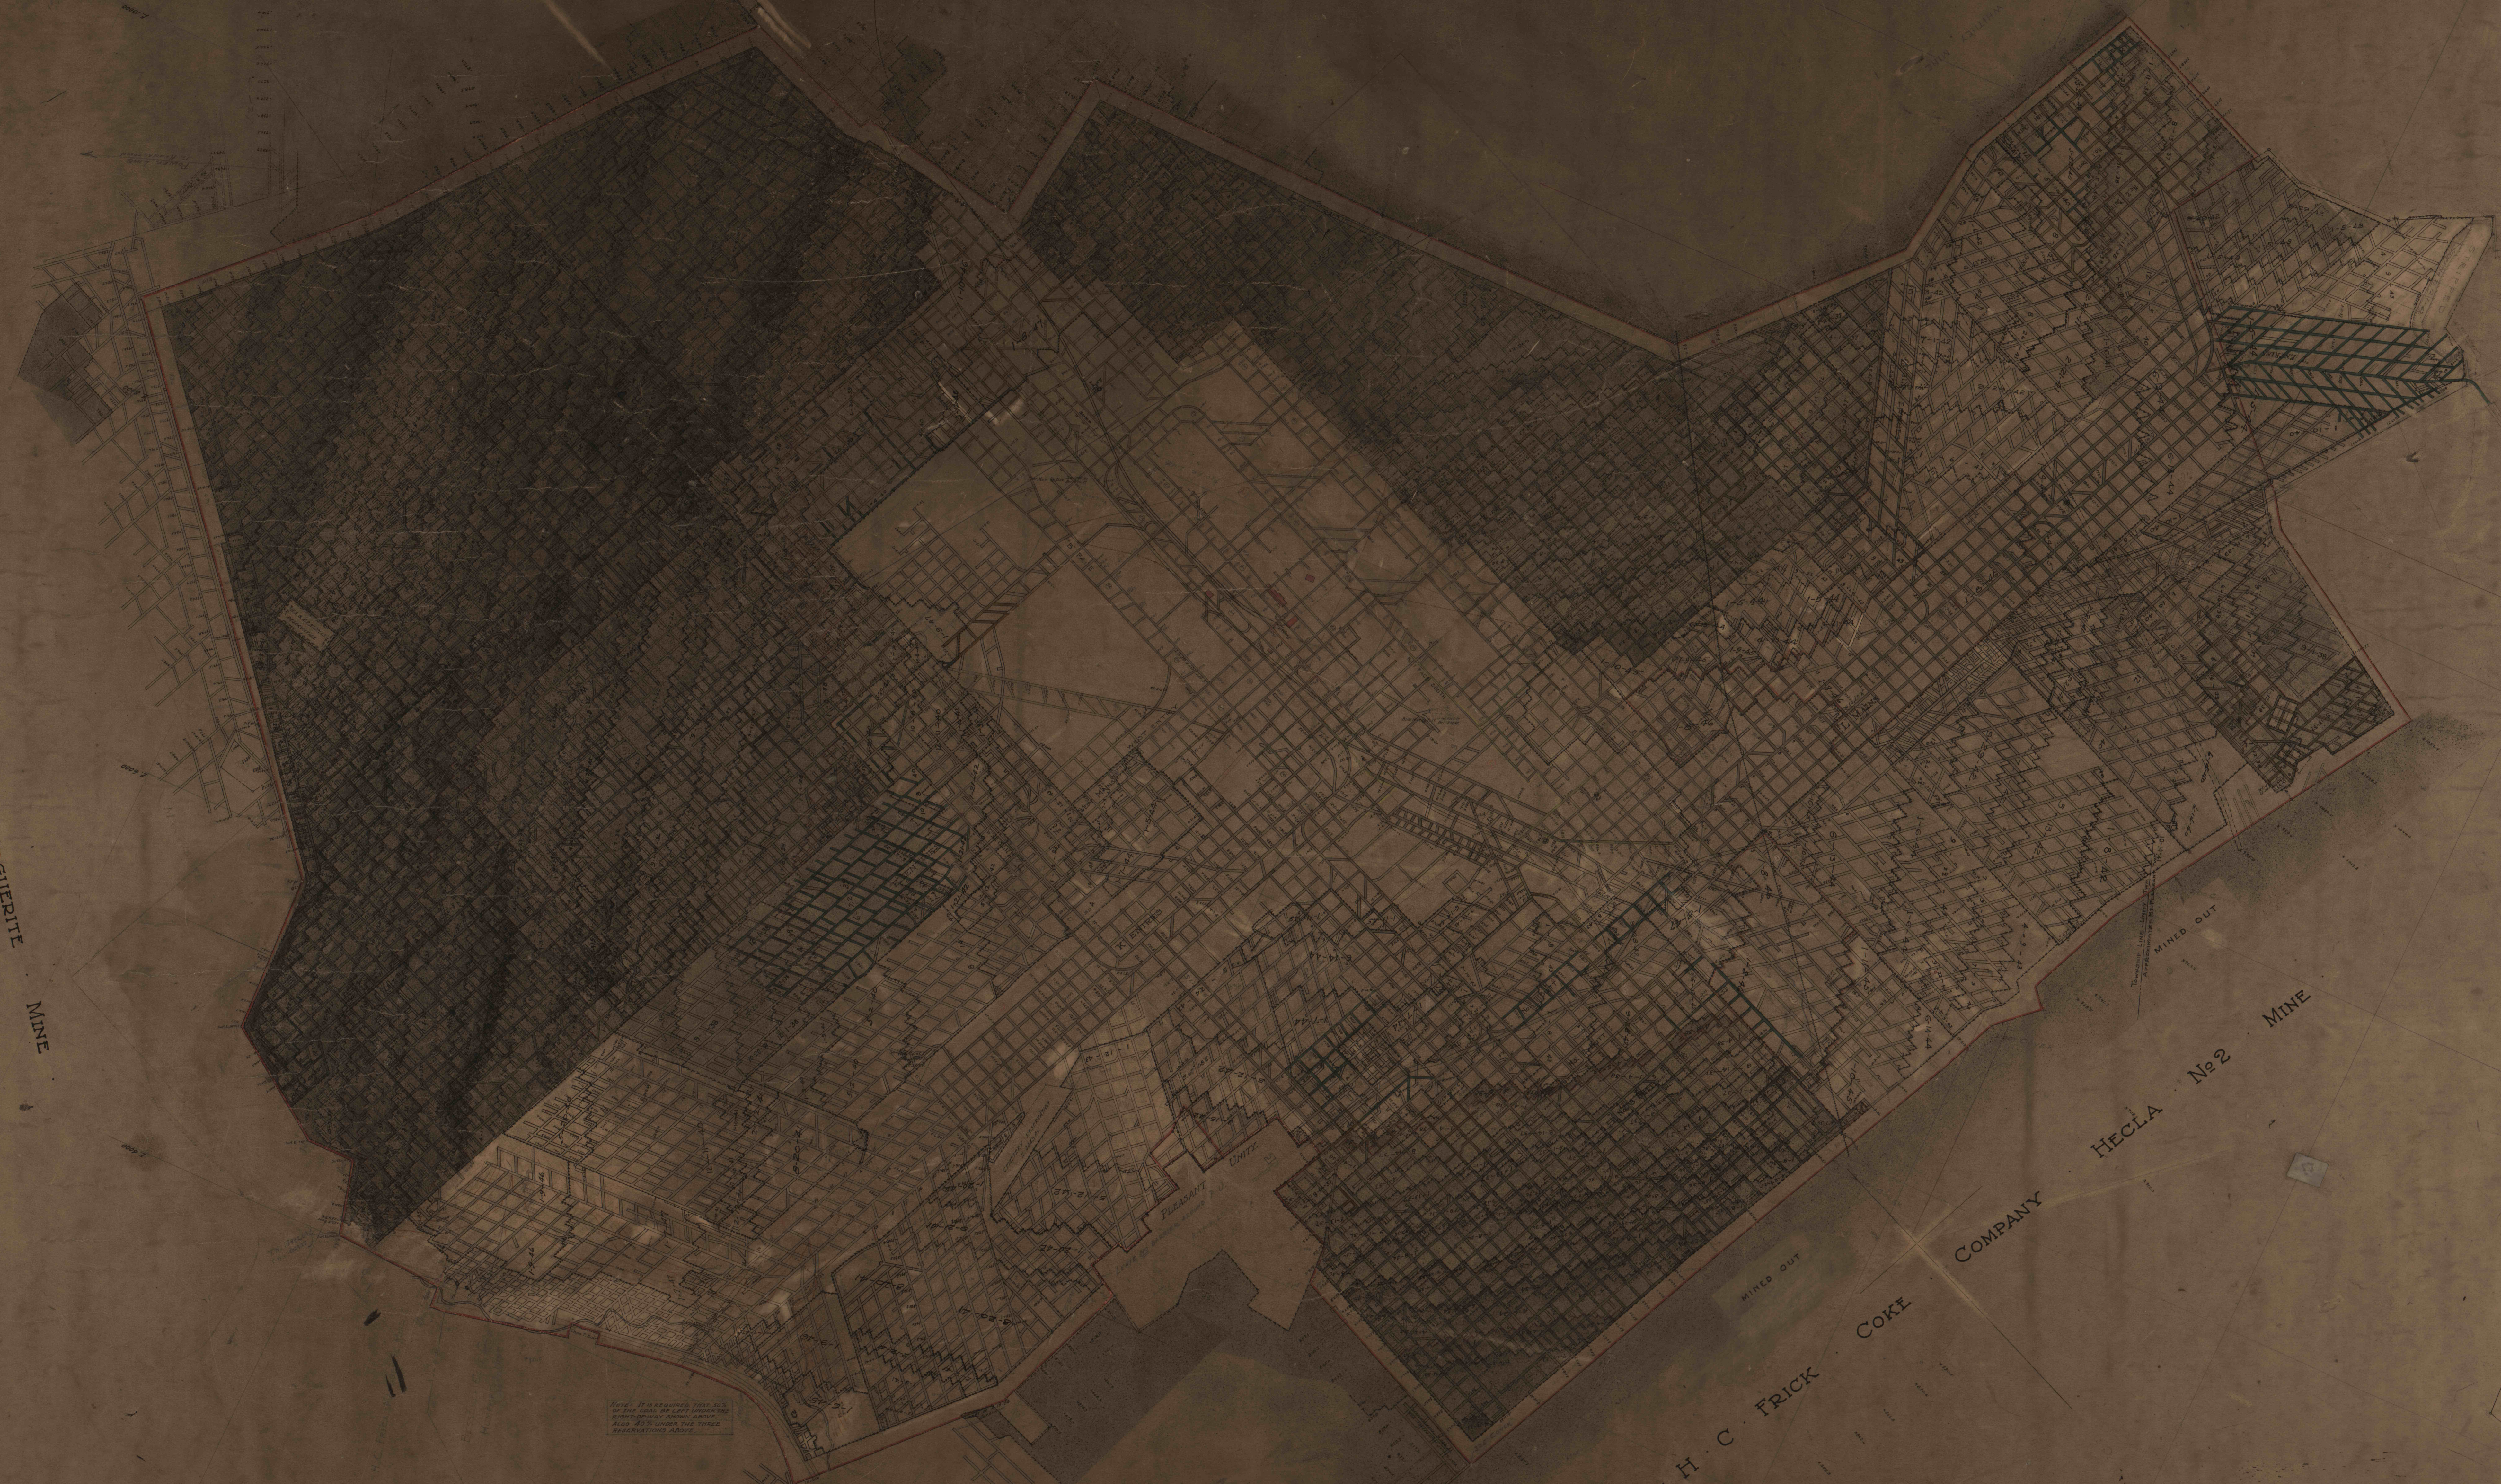

HUMPHRIES COAL & COKE CO.  
BESSEMER MINE

H. C. FRICK  
COKE  
COMPANY

HECLA No 2  
MINE

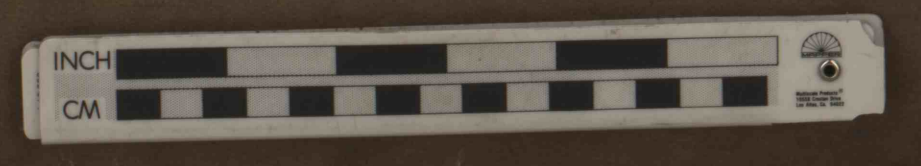

56-57  
58-59  
56