


1"=100' 388047 XSL 561

 

ANNE M. BAILEY

J.B. POLLOCK

MARY GEORGY

D.A. HUFFORD

JAMES HUFFORD

JAMES HUFFORD
RES.

L.B. MITCHELL

JOHN A. HUFFORD

J.T. MARTIN
