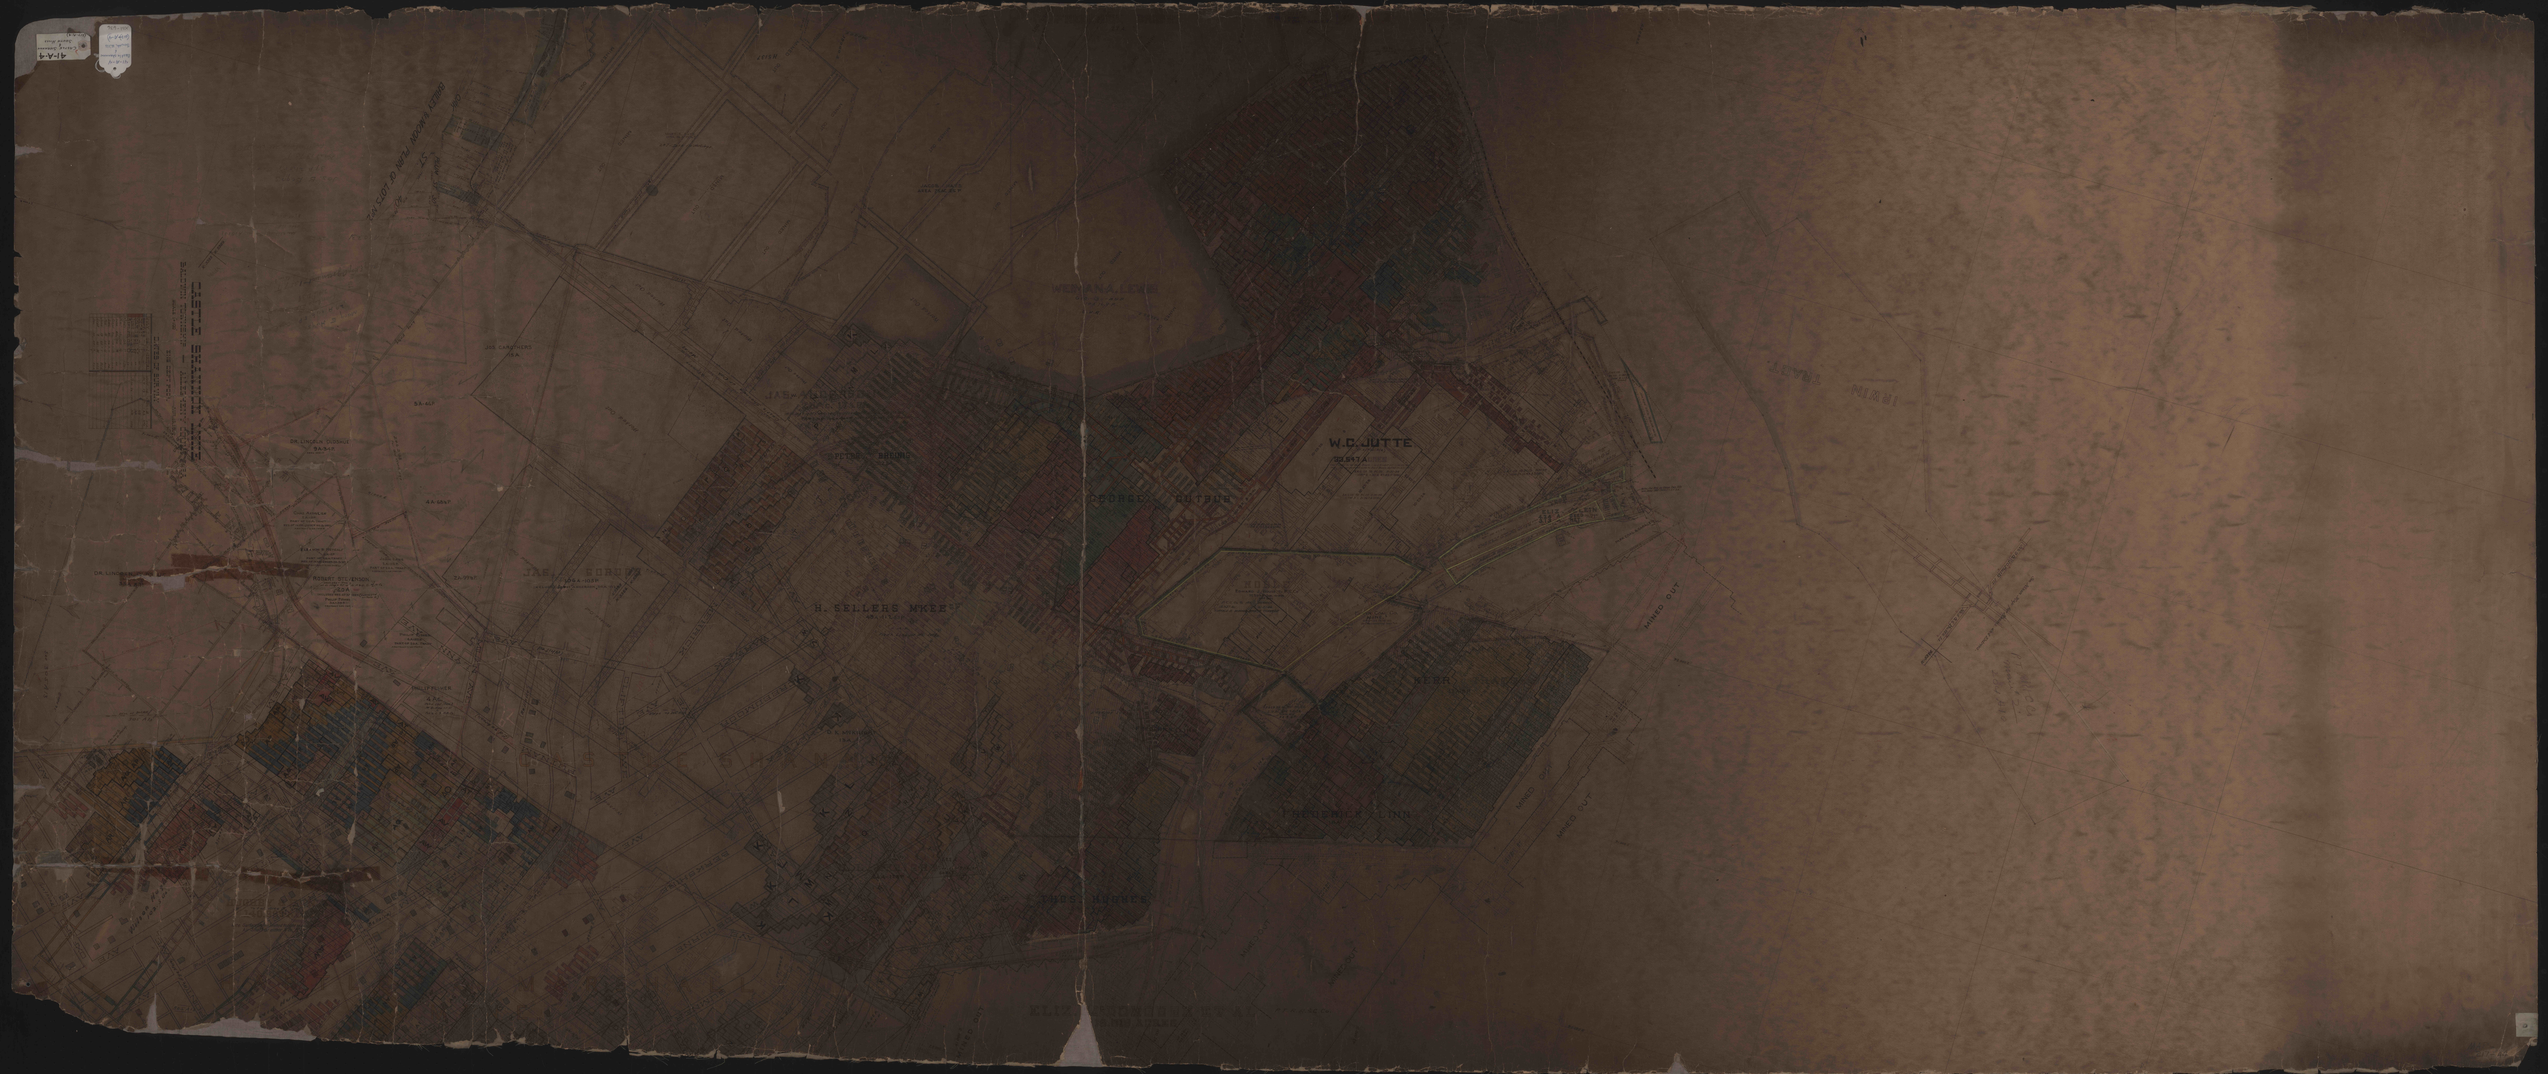
WERMANA LEWIS
JAS. LAWRENCE
SPITTS BRUNE
W.C. JUTTE
GEORGE BUTBUH
JAS. EUBUH
H. SELLERS MKEE
MIXED OUT
KERR
FRANKLIN LINN
JAMES MYERS
ELIJAH LAWRENCE
ALLEGHENY
MIAMI
MIXED OUT
MIXED OUT
MIXED OUT