


CLINTON BLOCK COAL CO  
COAL & SURFACE

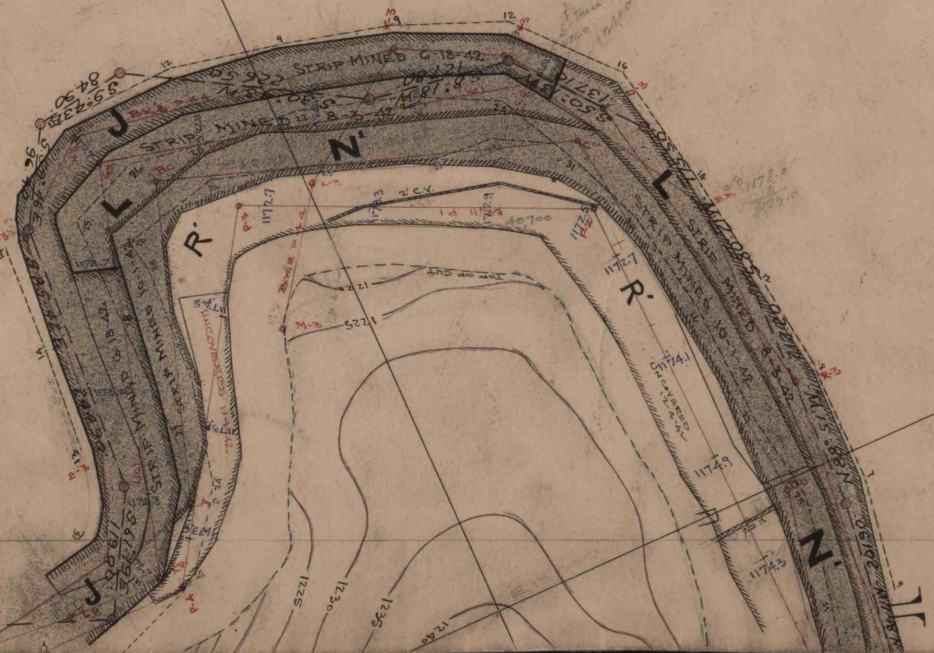

See 2-A-15

ALBERTA CULLOUGH



FOR SURVEY SEE CLINTON BLOCK BK\*4 Pg 37

LEBANON BLOCK COAL CO  
BOUNDARY LINE

See 2-A-15

387512 1