


44 - 40
42 - 43
40 - 41

M Newdorfer.

Barclay Rankin & Markle.

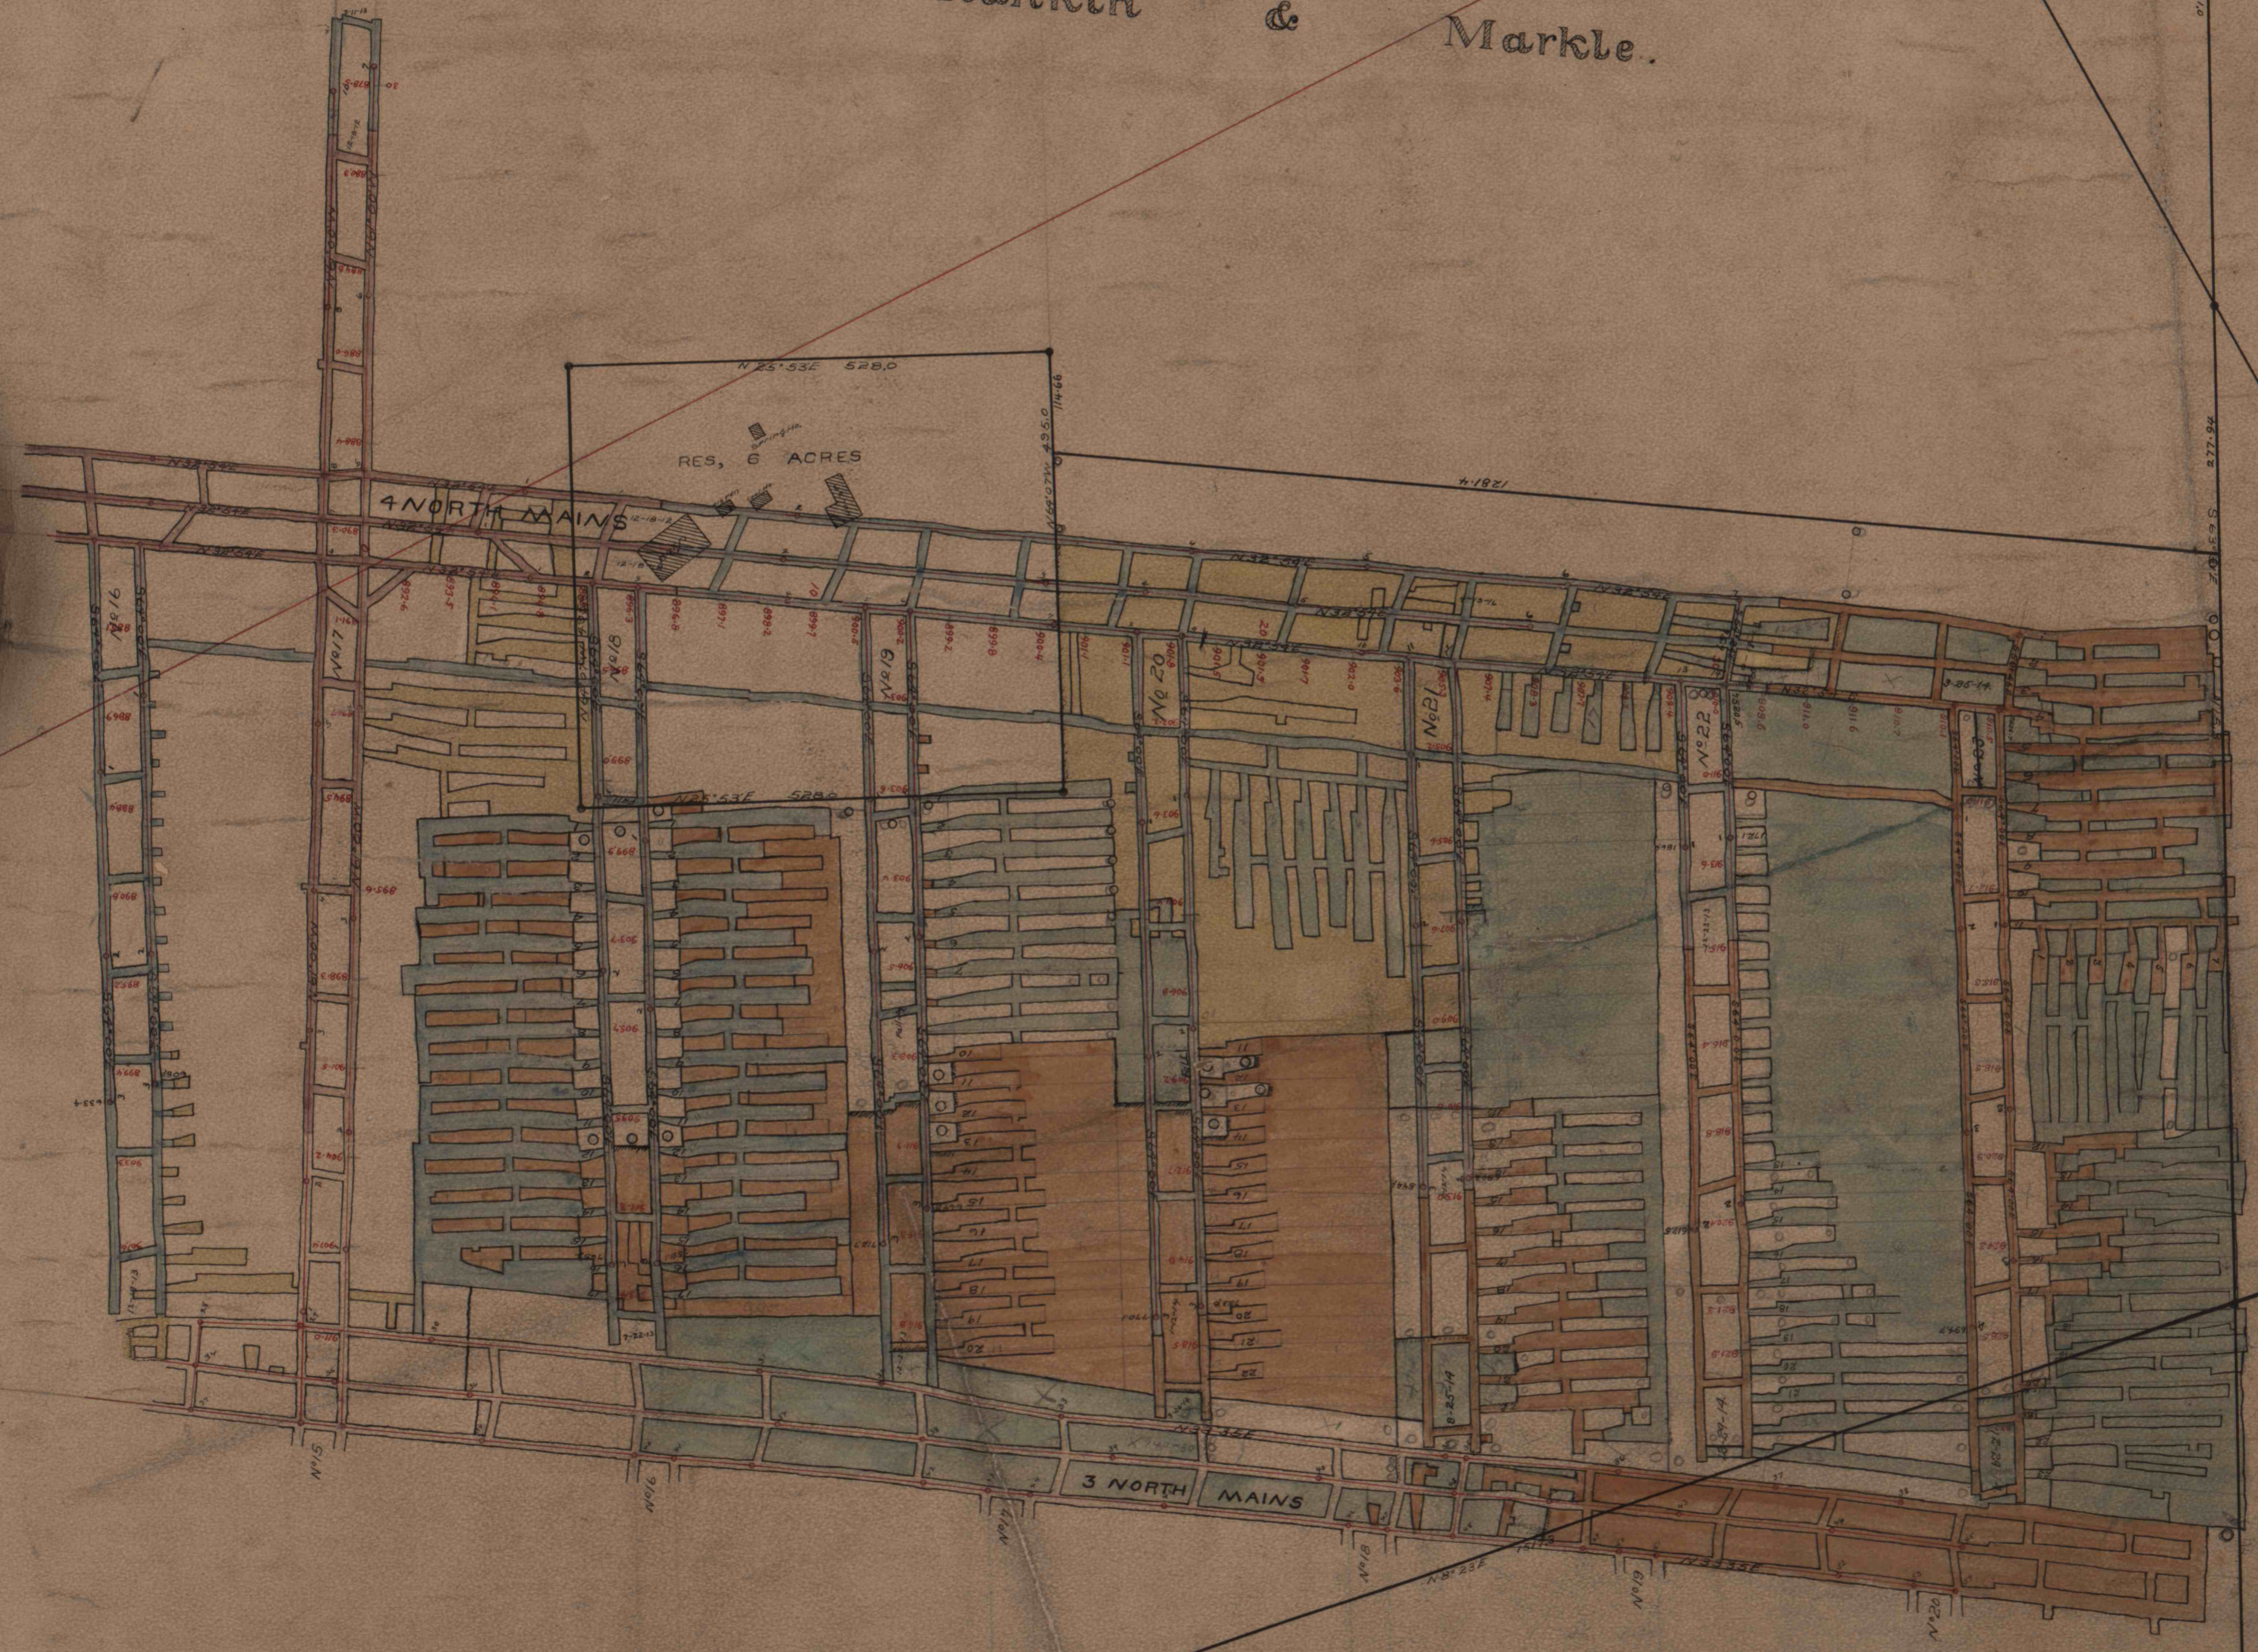

35 36
11
1

36
11
35 3

40 -
- 41
42 -
- 43
44 -
- 45
46 -