

K-5094

K-5094 K-5095

HOLMES
40 AC

J RAMSAY
20 AC

A. W. MELLON
4 AC.
P. C. Co. C. & S.
Surface sold to Thos. Ceney
3-9-15

Caroline
76 AC
118 ft

SABINA PATTERSON
15 AC
112 ft

Sabina Patterson
15 AC
112 ft
WORKINGS


MINE

ENTRANCE

REM. COAL OF PGH. VEIN SOLD TO CHARLES J. FLECK 6-5-30 (123+ AC. SURF. AREA)

John H. Okner
20.123 AC

Sub 286 A10

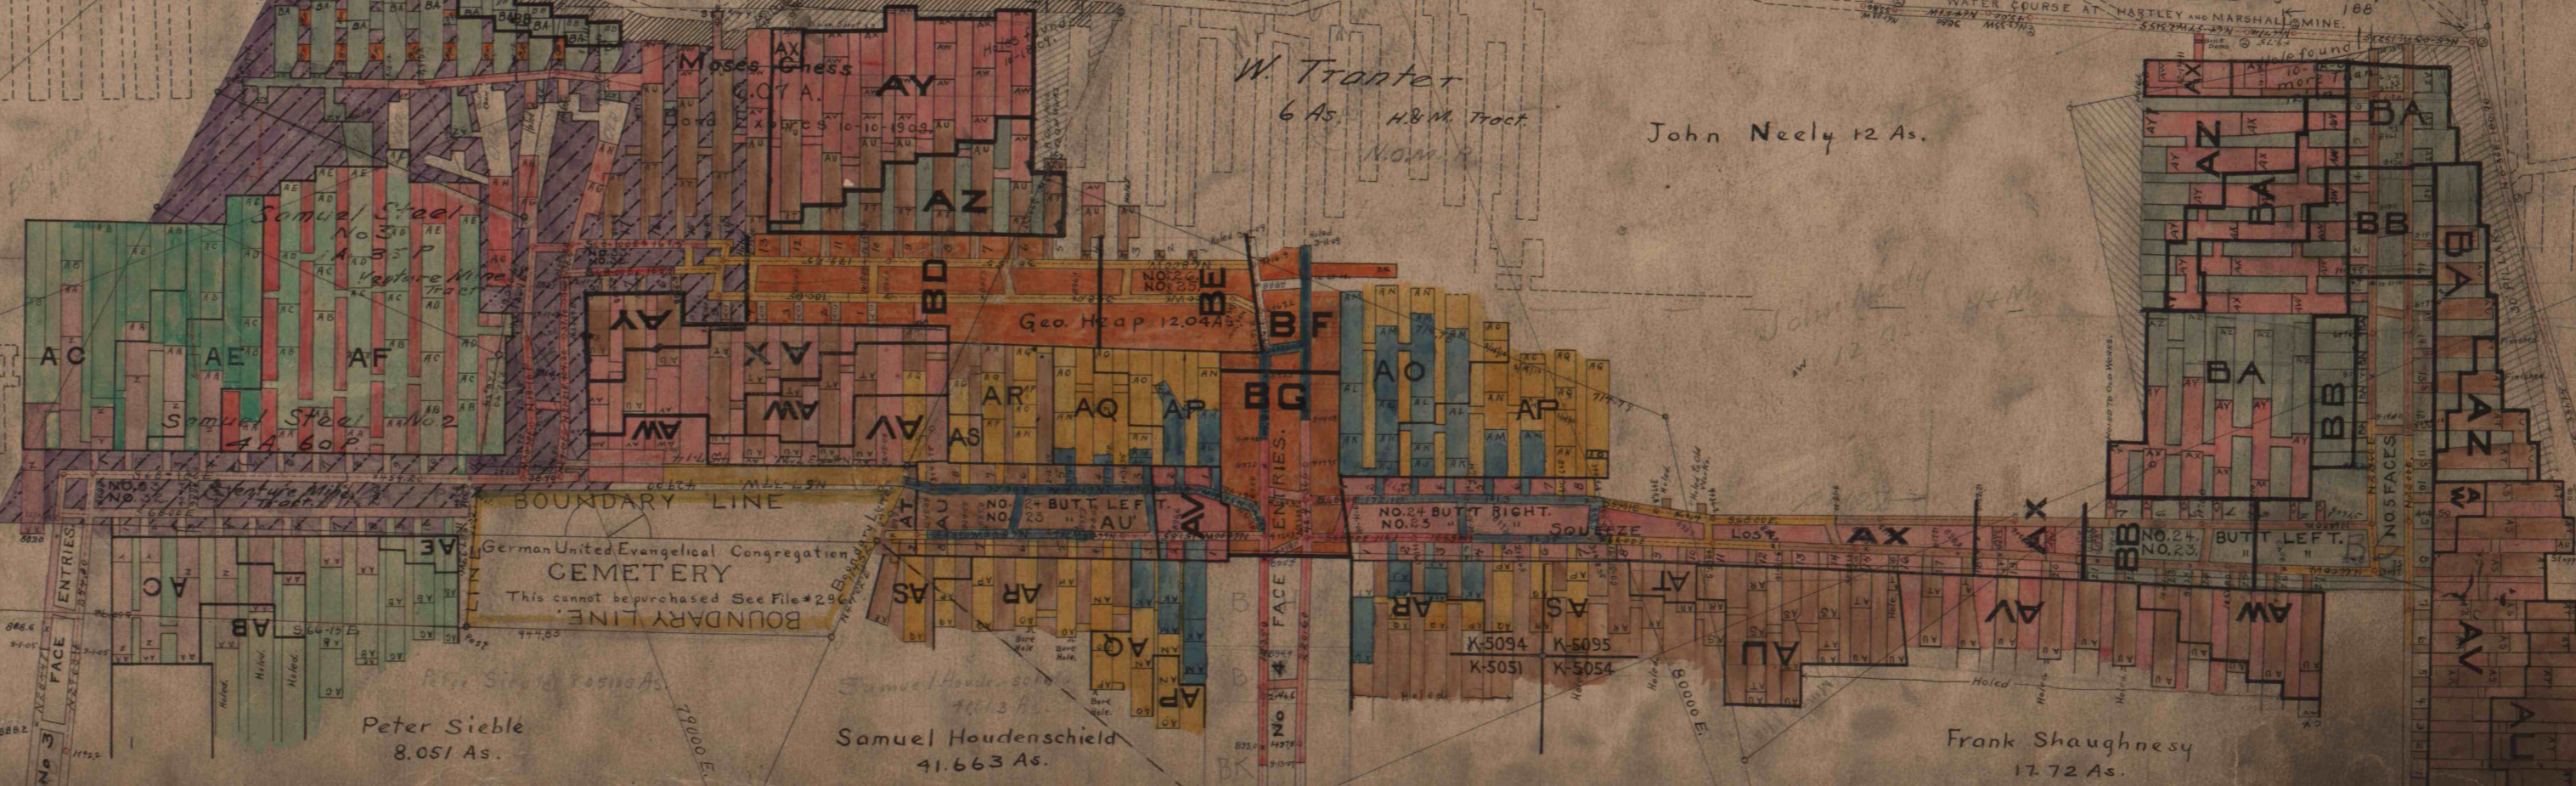

Peter Sieble
8.051 AC

Samuel Houdenschild
41.663 AC

Frank Shaughnesy
17.72 AC

William Simon's
12 AC

Headline to
M. Field
N. Mine