

MAP
 OF
COAL LANDS
 SITUATE IN SEMICKLEY TWP.
 WESTMORELAND CO. PA.
 OWNED BY
McCANDLESS, KING & CO.
 Surveyed in 1885.
 BY
Taylor & Ramm, C.E.s
 Scale half to an inch

SUMMARY
































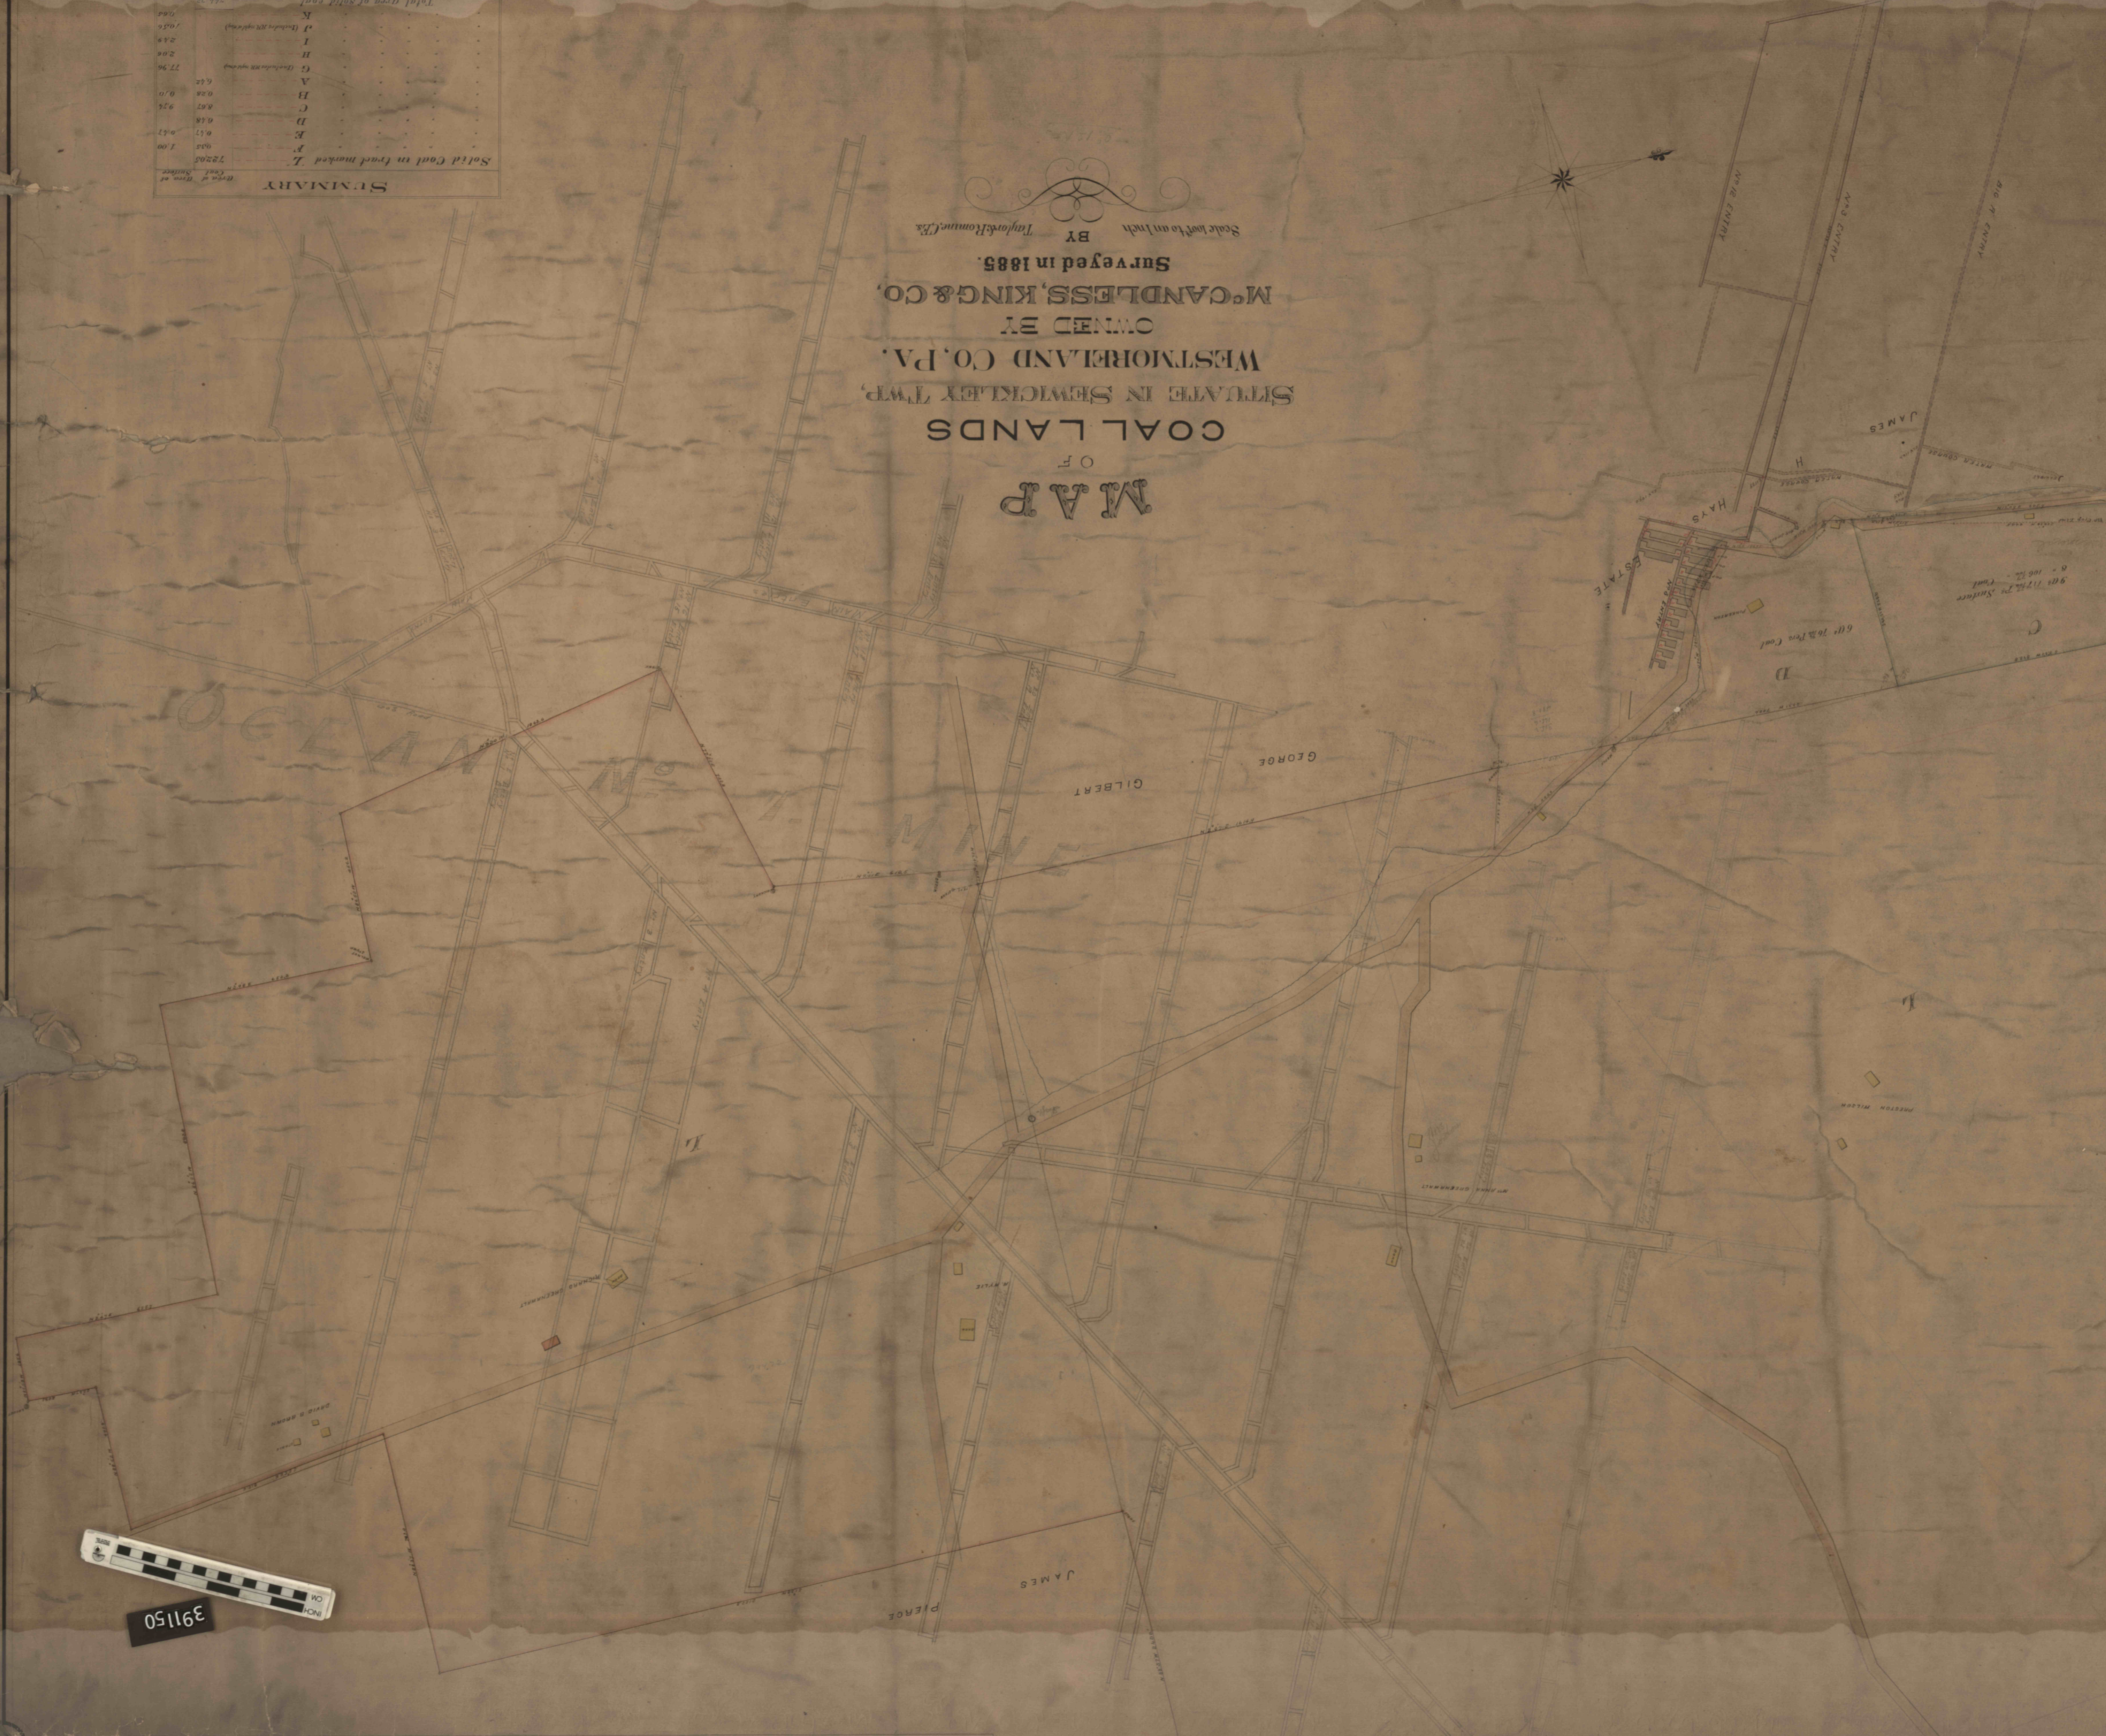

68 66
67

59
60

60
59