


60
59

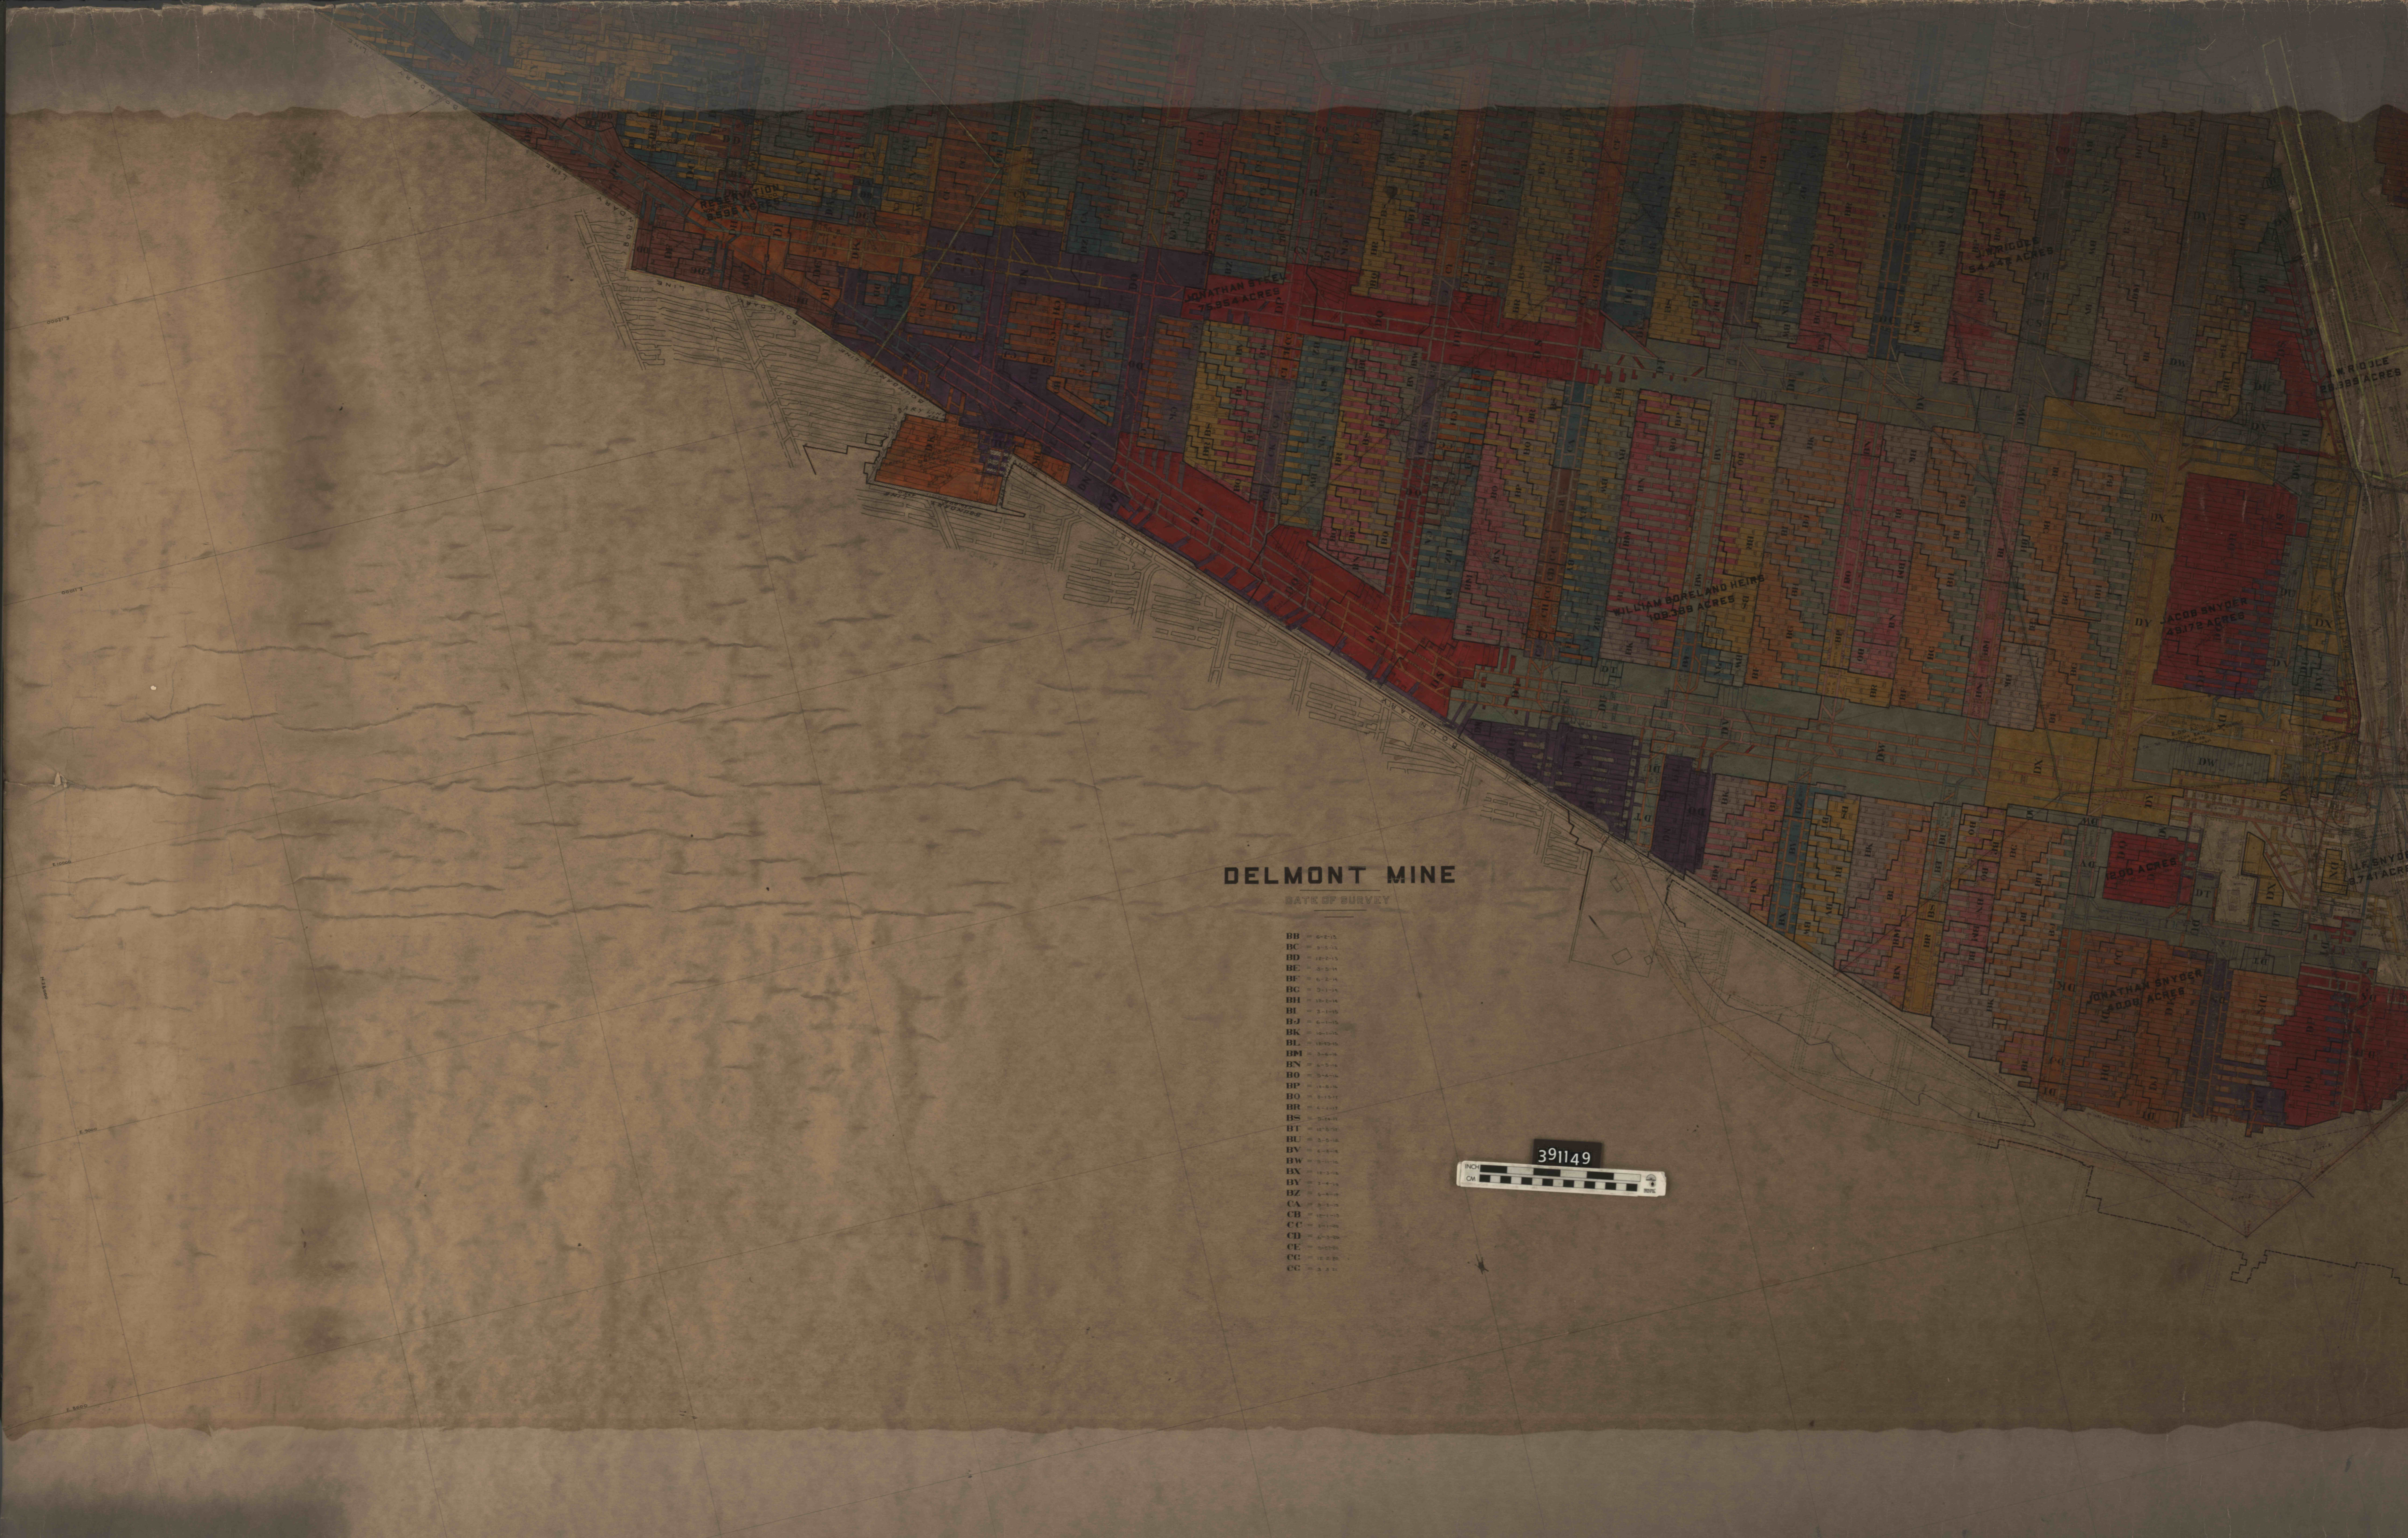

DELMONT MINE

DATE OF SURVEY

391149








