

South Side  
Penn. No. 5  
15100  
862-1876  
251-711

EXPLANATORY NOTE

JOHN P. MILLER

THE PART COLORED YELLOW DENOTES WHERE THE COAL HAS BEEN MINED OUT  
BOUNDARY LINE OF PROPERTY BELONGING TO THE PENN GAS COAL COMPANY  
PROPERTY LINES, SUB-DIVISIONS AND COAL CROP LINE  
AREA MINED OUT FROM FEB 25<sup>th</sup> 1865 TO MAR 1<sup>st</sup> 1866  
AREA MINED OUT FROM MAR 1<sup>st</sup> 1866 TO JAN 26<sup>th</sup> 1867  
AREA MINED OUT FROM JAN 26<sup>th</sup> 1867 TO JAN 15<sup>th</sup> 1868  
JAN 15<sup>th</sup> 1868 - JAN 10<sup>th</sup> 1869  
JAN 10<sup>th</sup> 1869 - JAN 10<sup>th</sup> 1870  
JAN 10<sup>th</sup> 1870 - JAN 13<sup>th</sup> 1871


AREA MINED OUT FROM JAN 13<sup>th</sup> 1871 TO FEB 1872  
FEB 1872 - MAR 11<sup>th</sup> 1873  
MAR 11<sup>th</sup> 1873 - JAN 28<sup>th</sup> 1874  
JAN 28<sup>th</sup> 1874 - 25<sup>th</sup> 1875  
JAN 25<sup>th</sup> 1875 - 10<sup>th</sup> 1876  
S. J. SHRUM

MAP OF THE SOUTH MINE  
OF THE  
PENN GAS COAL COMPANY  
AT  
PENN STATION  
WESTMORELAND COUNTY  
Pennsylvania

SHOWING ALL THE ENTRIES WITH THE COURSES AND DISTANCES, THE ROOMS WITH THE DEPTH AND DATE OF COMMENCEMENT, THE AREA OF COAL MINED AND THE AREA OF COAL REMAINING, THE OUT CROP LINE, PROPERTY LINES, RESERVATIONS, BUILDINGS TIPPLES AND TRACKS; BEING A PICTURE OF THE CONDITION OF THE MINE FEBRUARY 25<sup>th</sup> 1865.

SCALE ONE INCH = 100 FEET

SURVEYED AND DRAWN BY  
*Robert H. Lamborn,*  
*John P. Miller*  
CIVIL ENGINEER  
PHILADELPHIA PA.

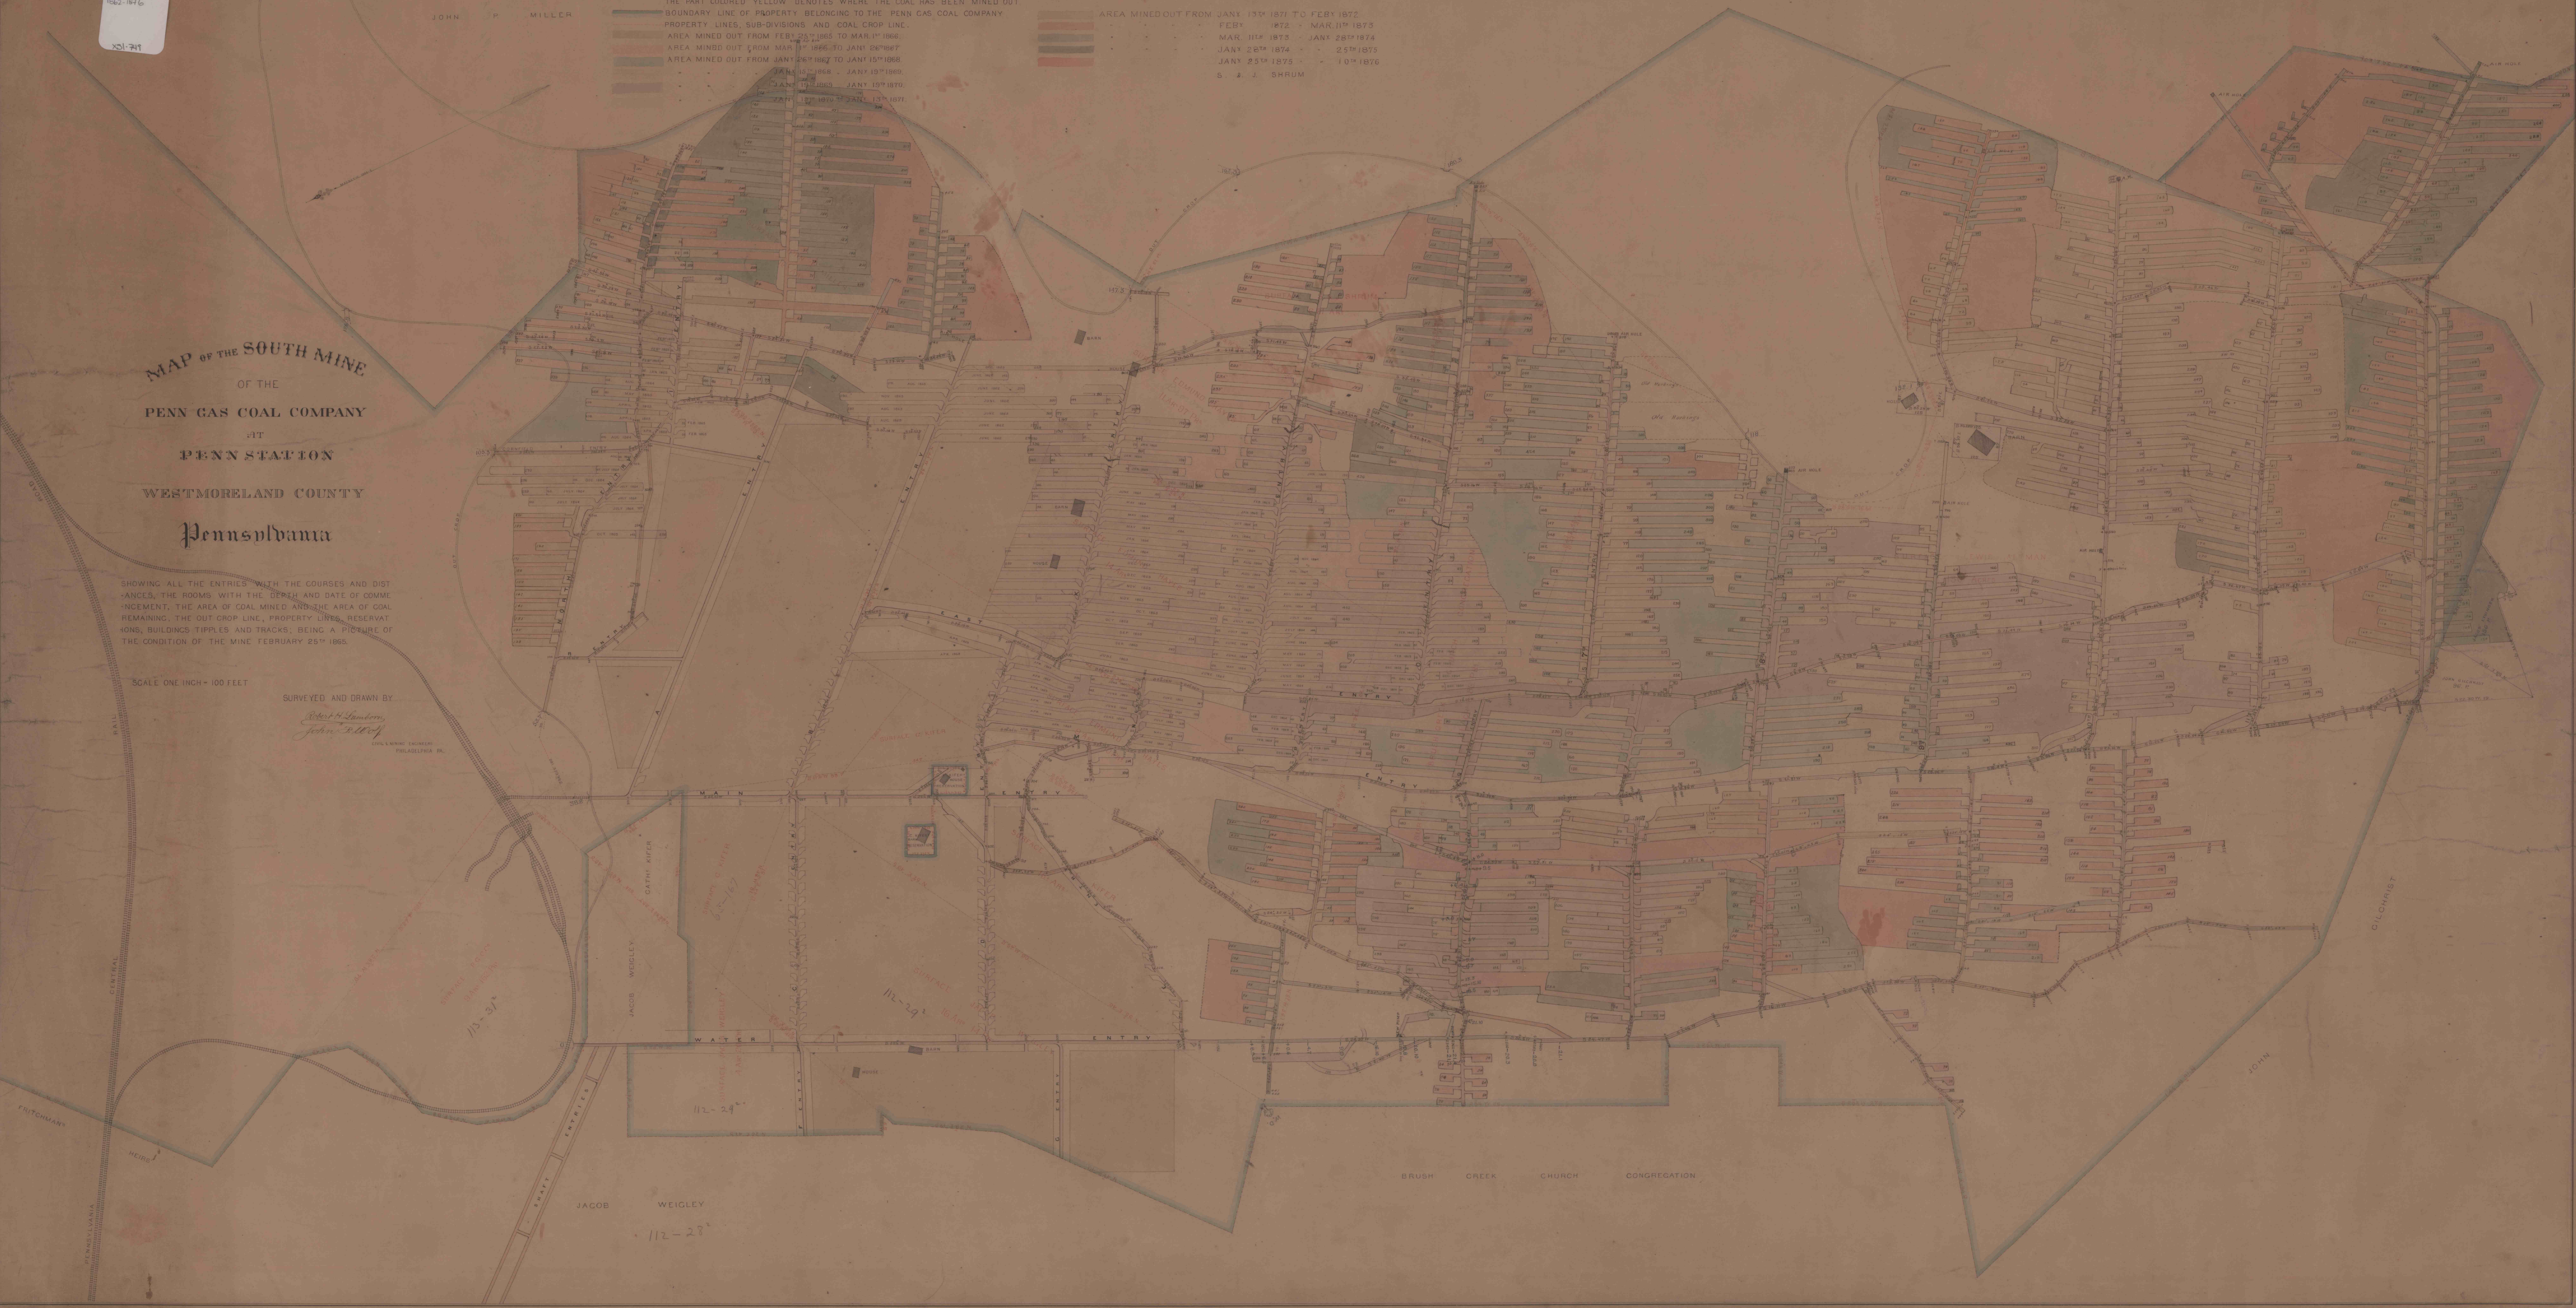

JACOB WEIGLEY  
112-28

BRUSH CREEK CHURCH CONGREGATION

GILCHRIST

JOHN