



Joins to 299A8
- Moon Run Mine -

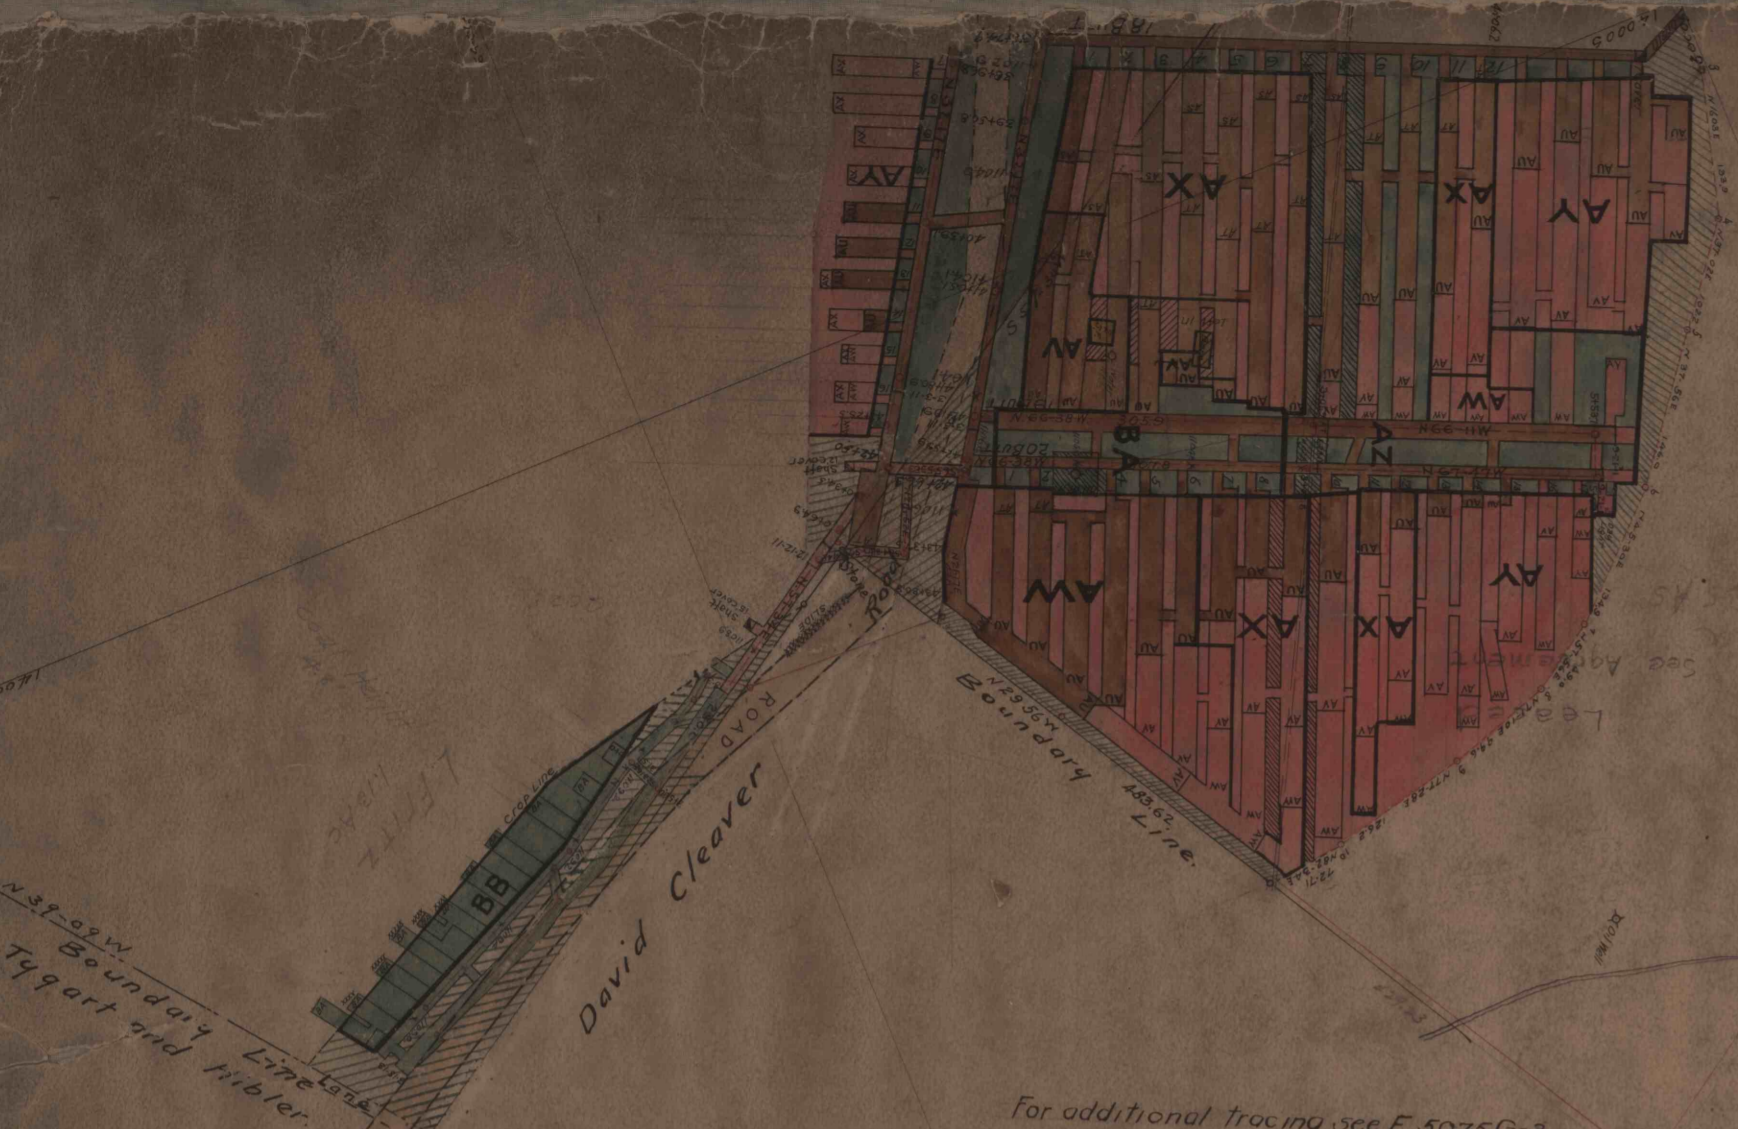

For additional tracing see E 5078 G-3

Moon Run
Join #299A8
Sheet #4
Moon Run

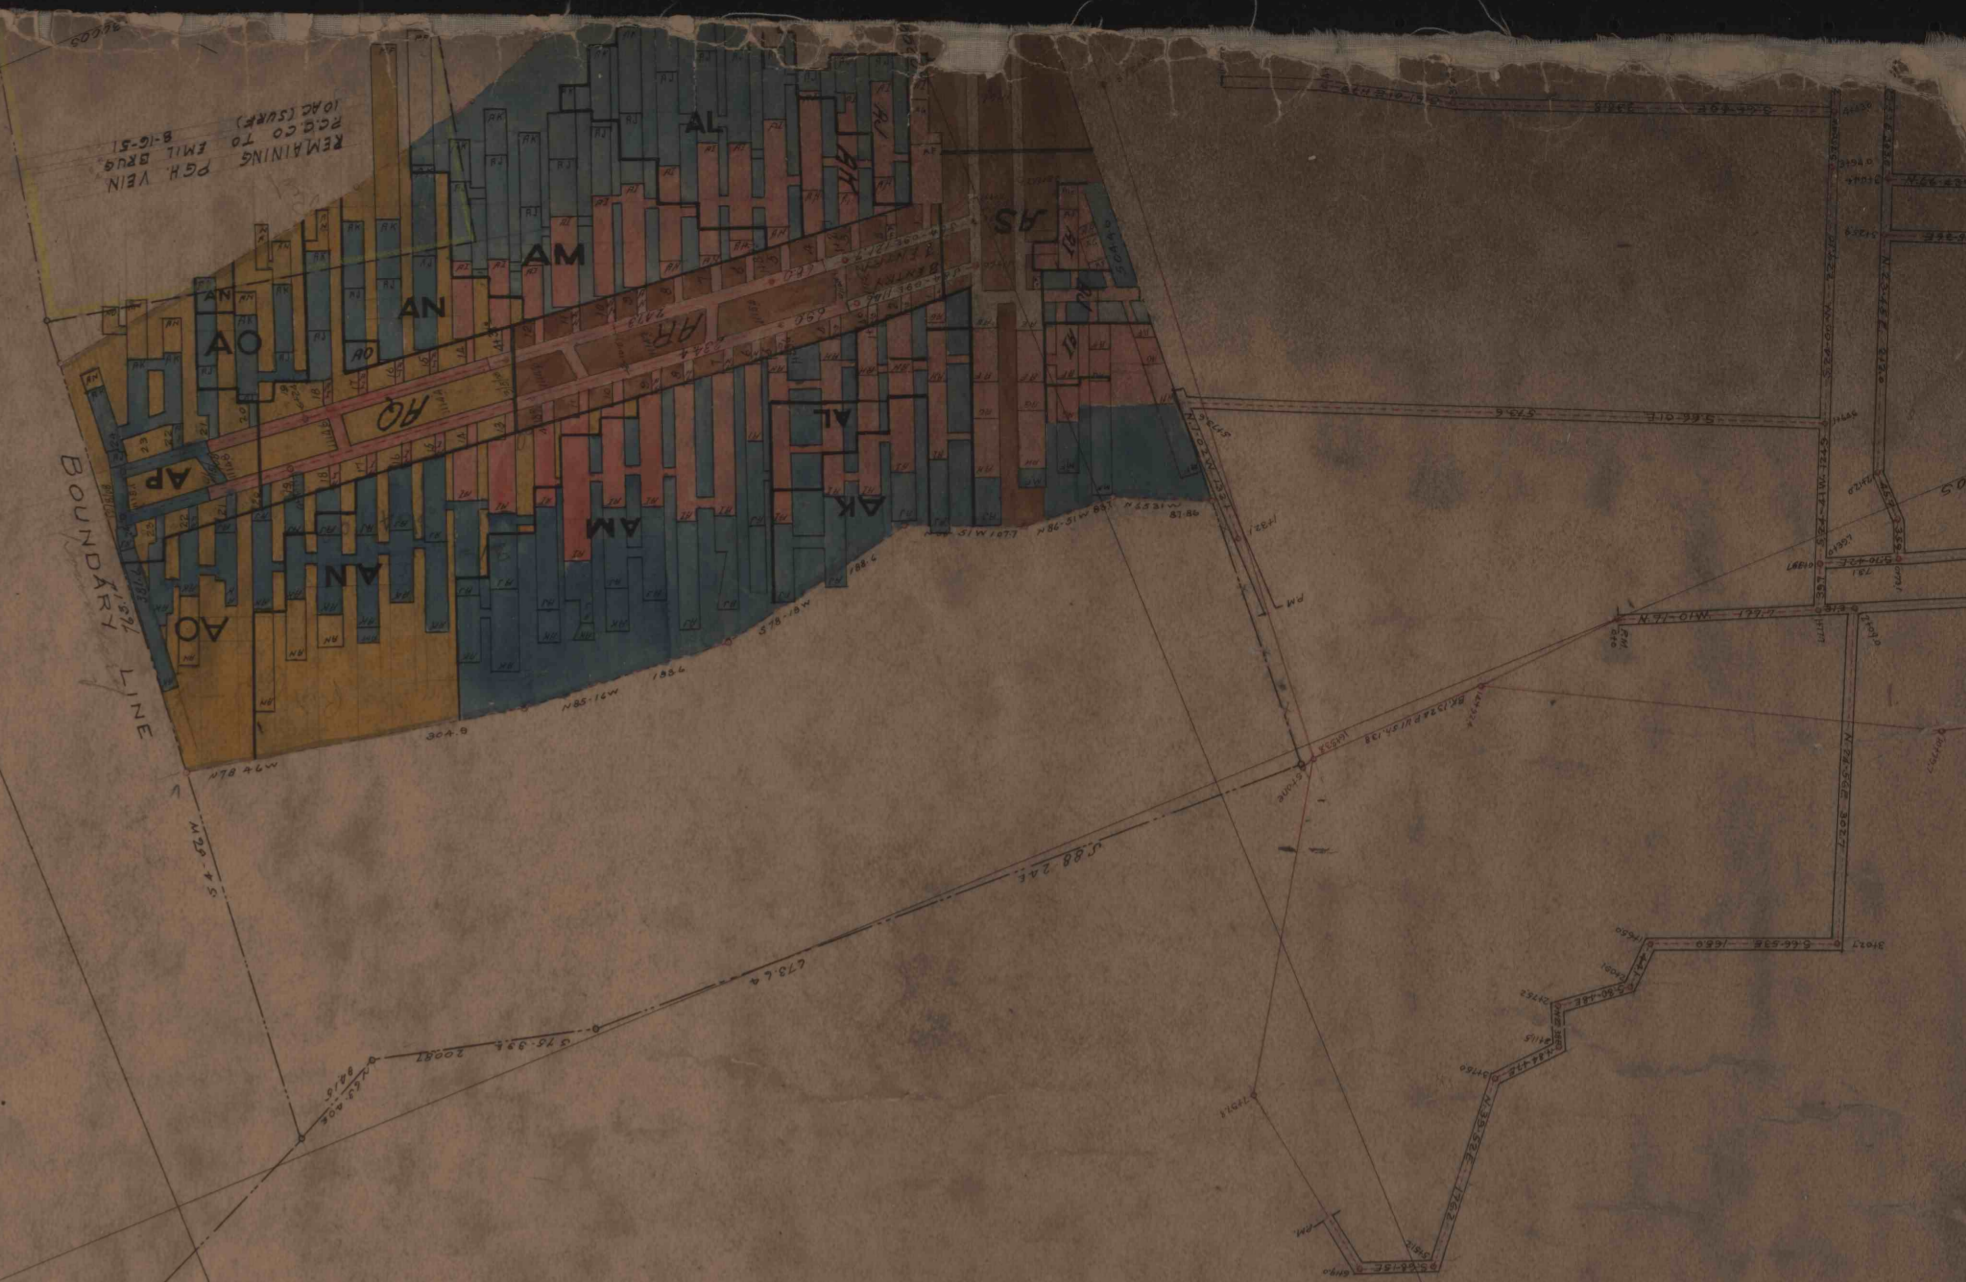

Moon Run Mine
1911-1915
XSL-778