


No. 3  
New Map  
Magnetic  
Meridian  
281-782

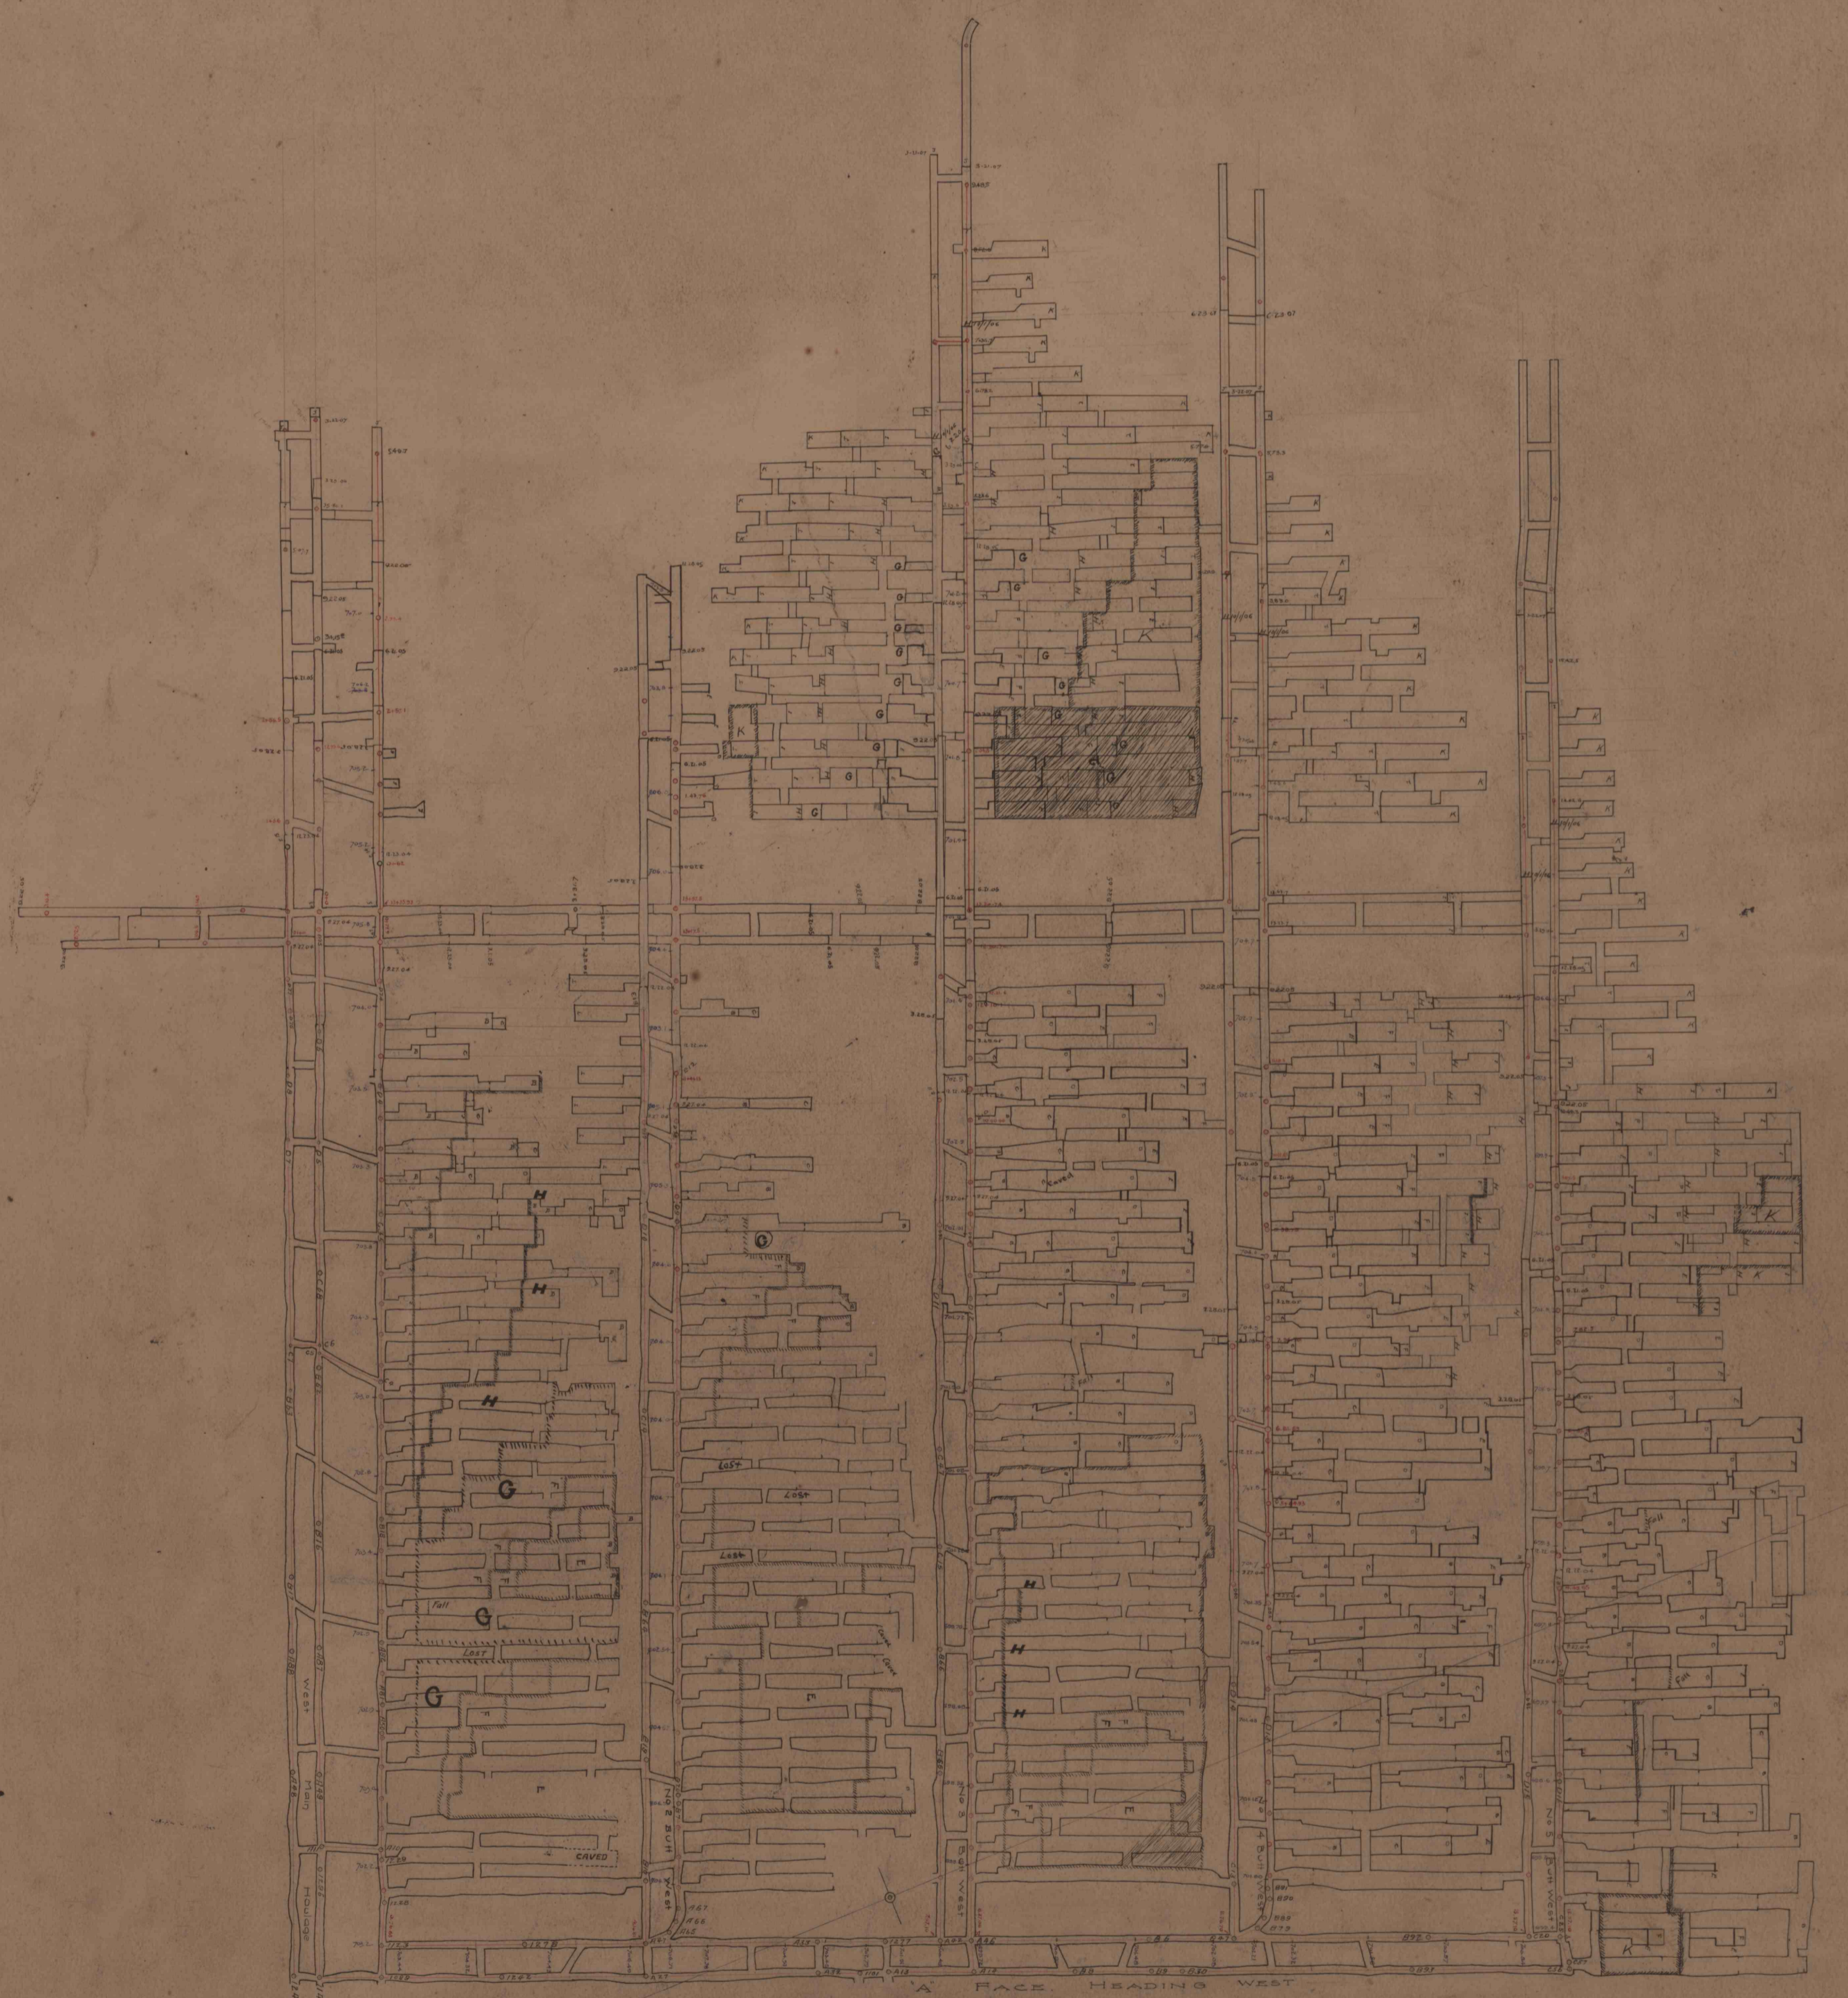

FACE HEADING WEST