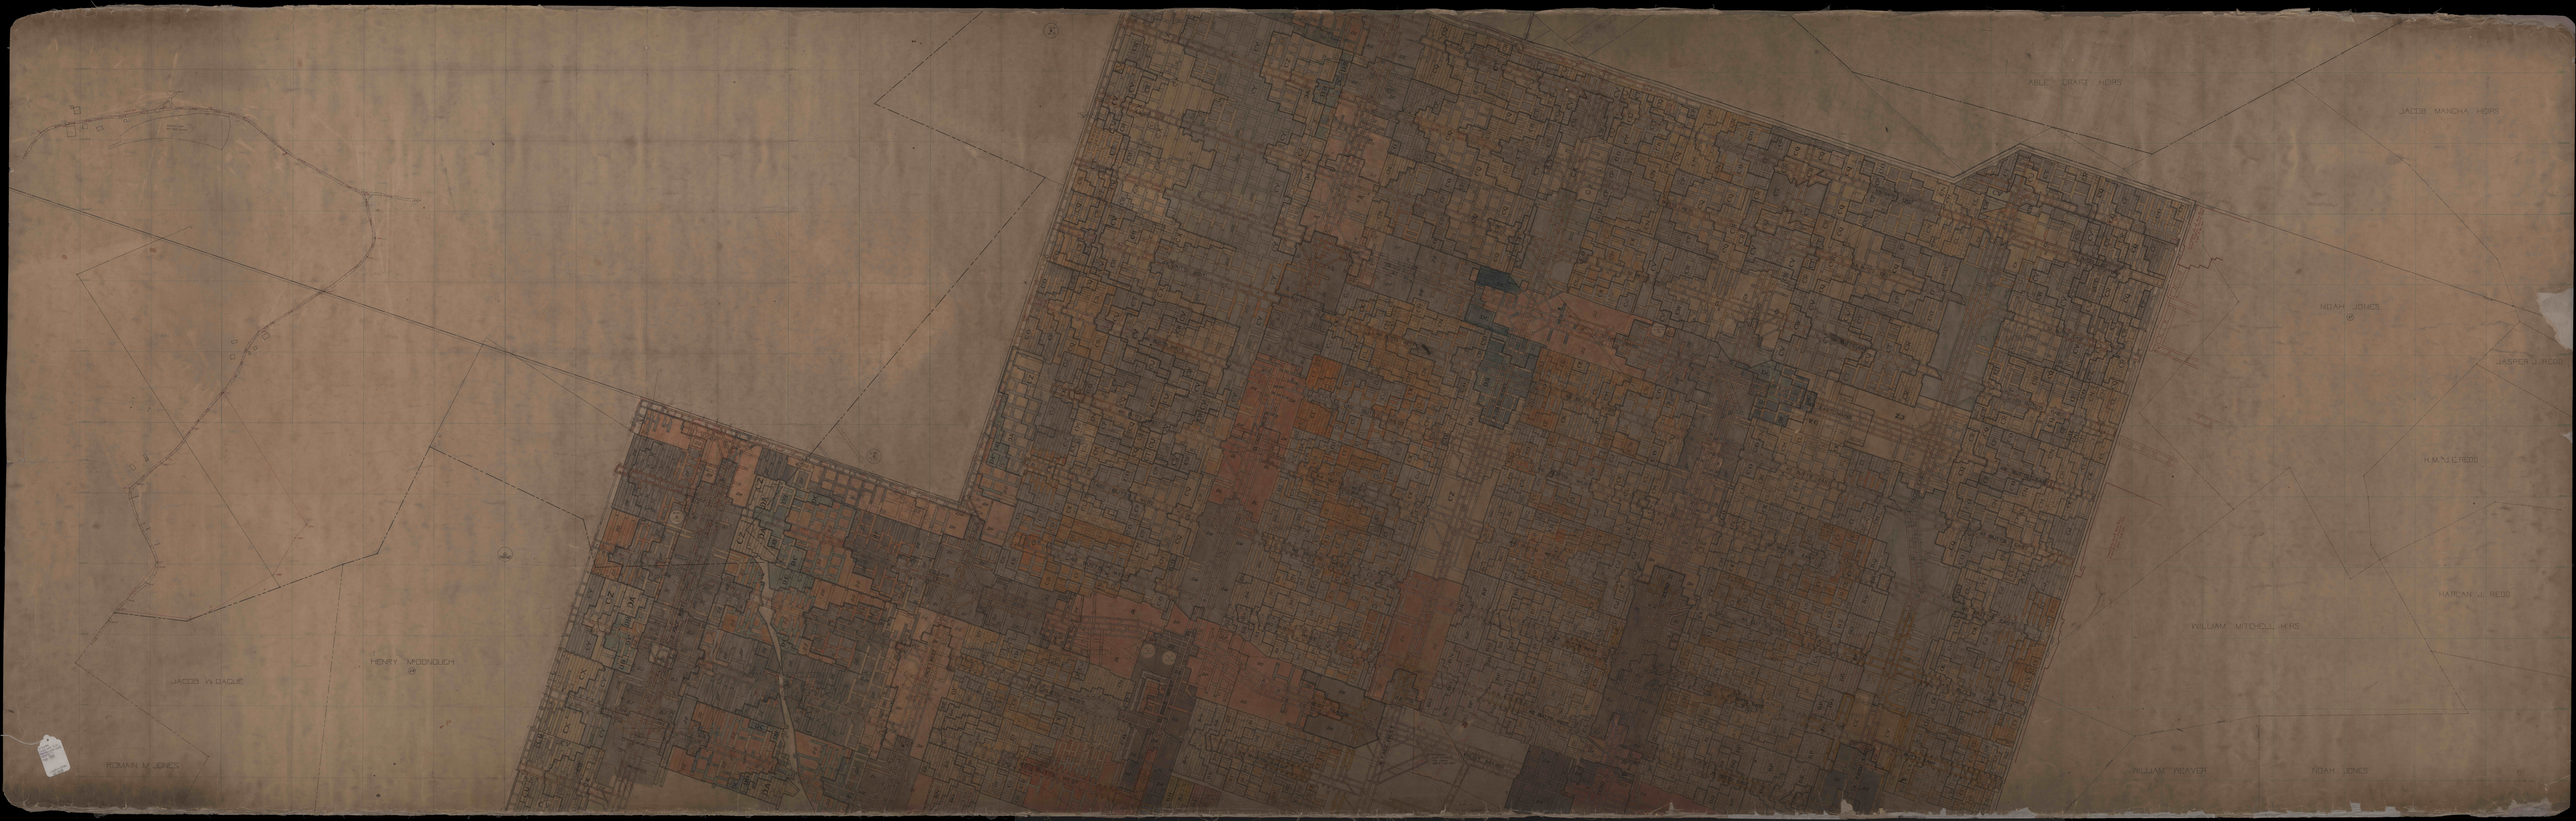
ABLE CRAFT HEIRS
JACOB MANCHA HEIRS
NOAH JONES
JASPER J. REED
H.M.S.J. REED
HARDEAN J. REED
WILLIAM MITCHELL HEIRS
WILLIAM WEAVER
NOAH JONES
HENRY McDONOUGH
JACOB W. DAGUE
ROMAN M. JONES