

ROBERT P. JOHNSON  
1875

ROBERT P. JOHNSON  
1875

387751

WILLIAM MAYHEW  
B. 170 A.

W. CALDWELL  
1875 A.

JOHN WALKER


BLAINE MINE

BLAINE MINE

MINED OUT

MINED OUT

MINED OUT

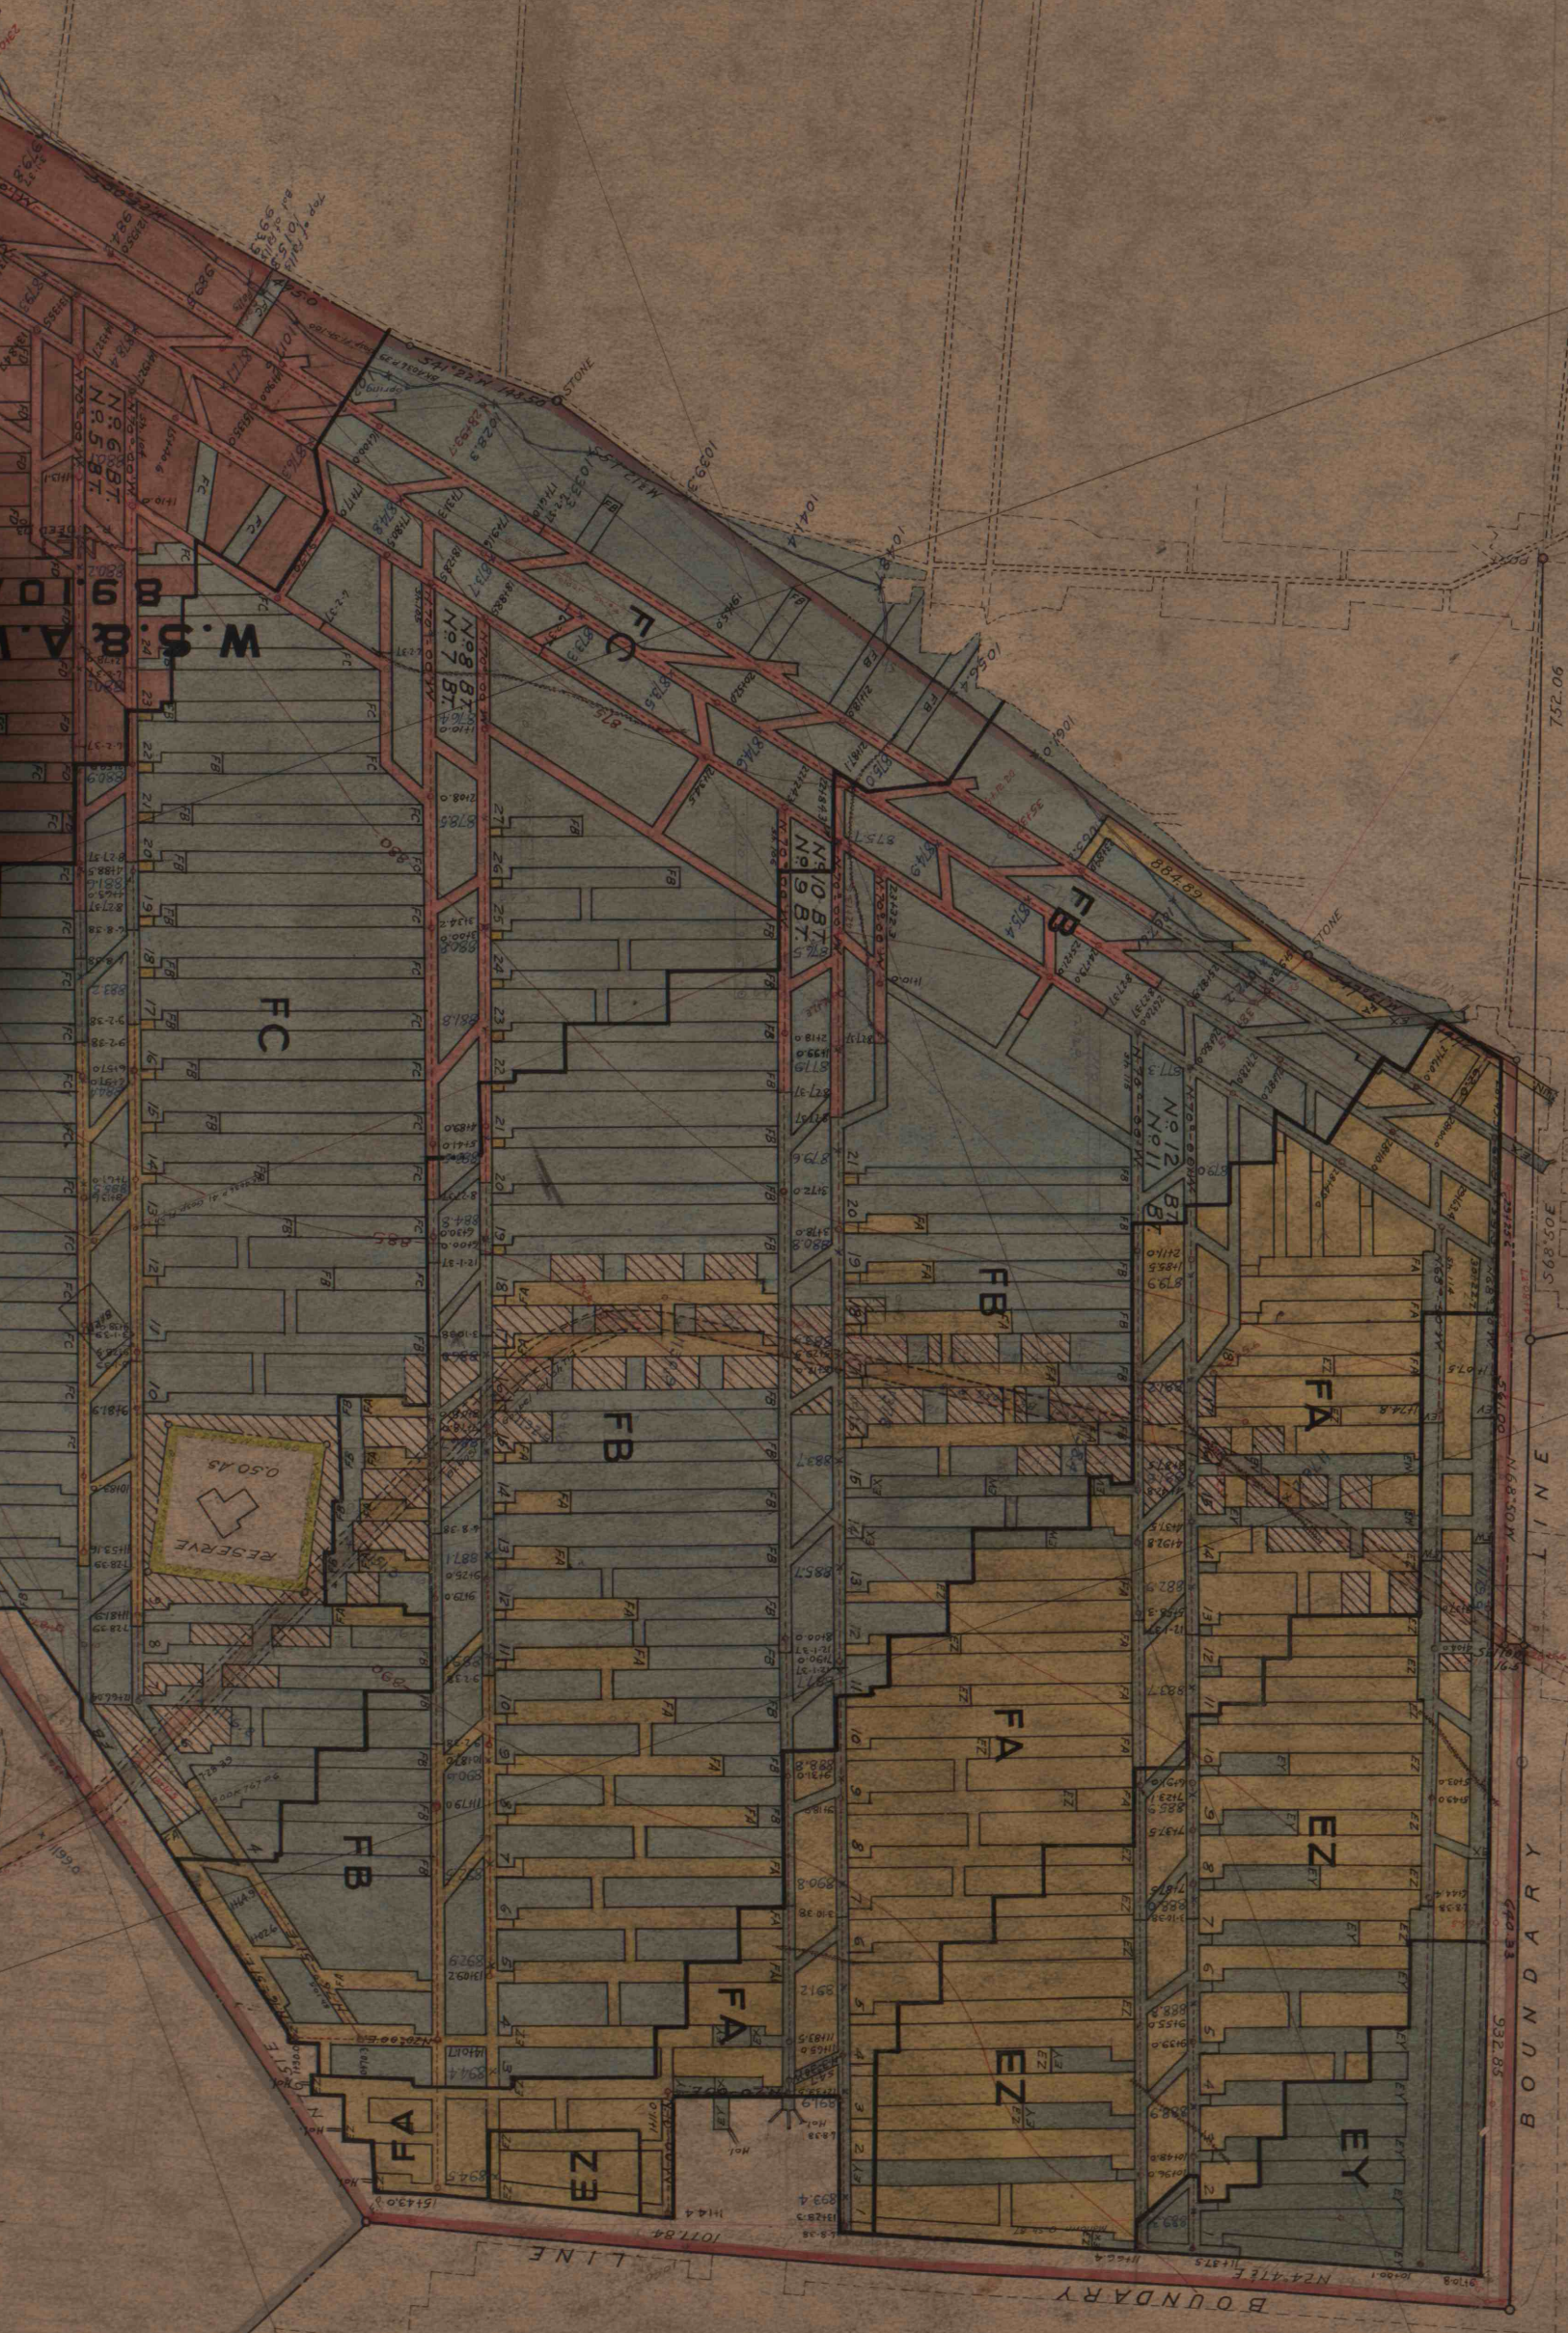

W. B. BAW

FC

FC

FB

FA

EZ

EY

EZ

EY

FC

FC