
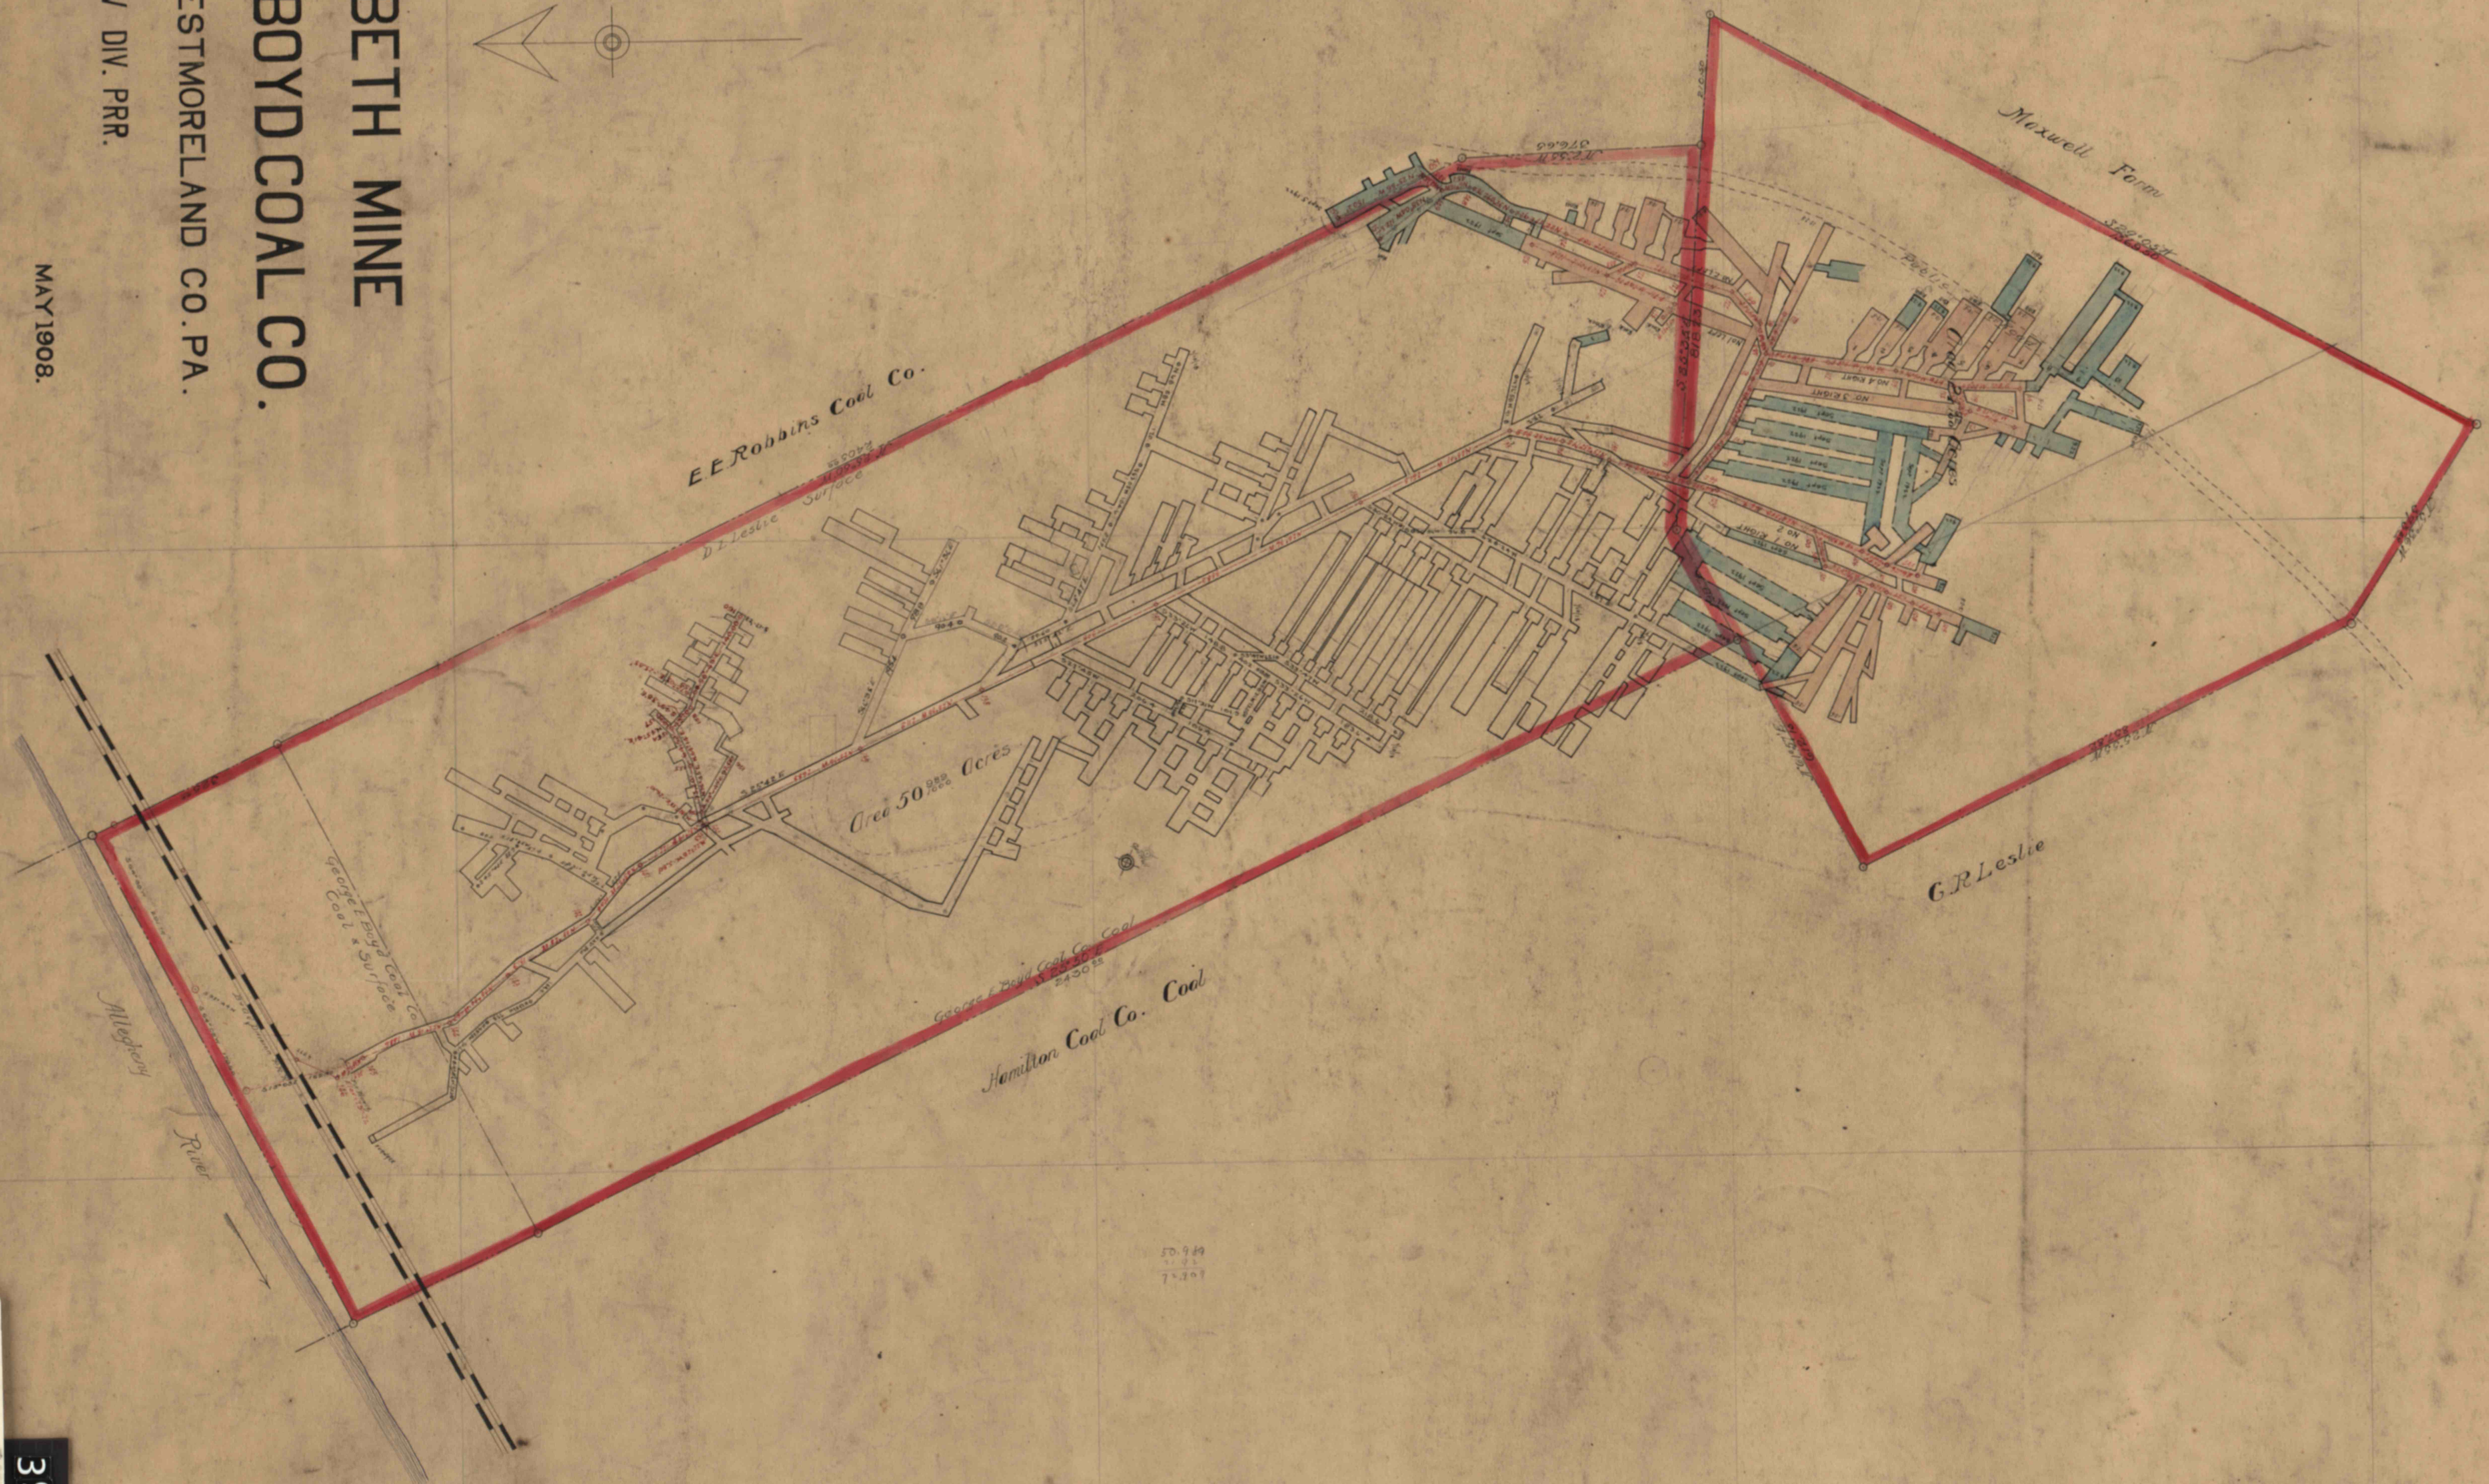


**ELIZABETH MINE**  
**GEORGE E. BOYD COAL CO.**  
EDGECLIFF, WESTMORELAND CO. PA.  
B&AV DIV. PRR.  
SCALE 1 INCH = 100 FT.  
MAY 1908.

STROUSE & FRITZ  
MINING ENGINEERS  
NEW KENSINGTON, PA.

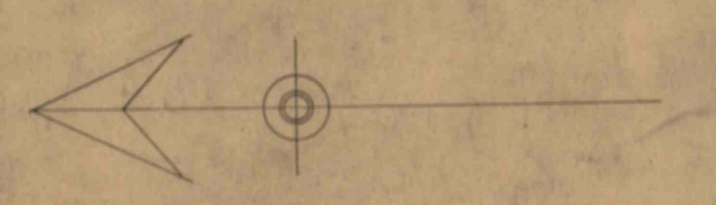

42-  
44-  
40-  
39-

64 66  
1 1 1 1  
3 65 67

39-  
40-  
41-  
42-