

N.Y. AND C.G.C. CO. NO. 4 MINES


JANUARY 1885

SCALE 1"=120'


#331-0-14

Small white label with illegible text.

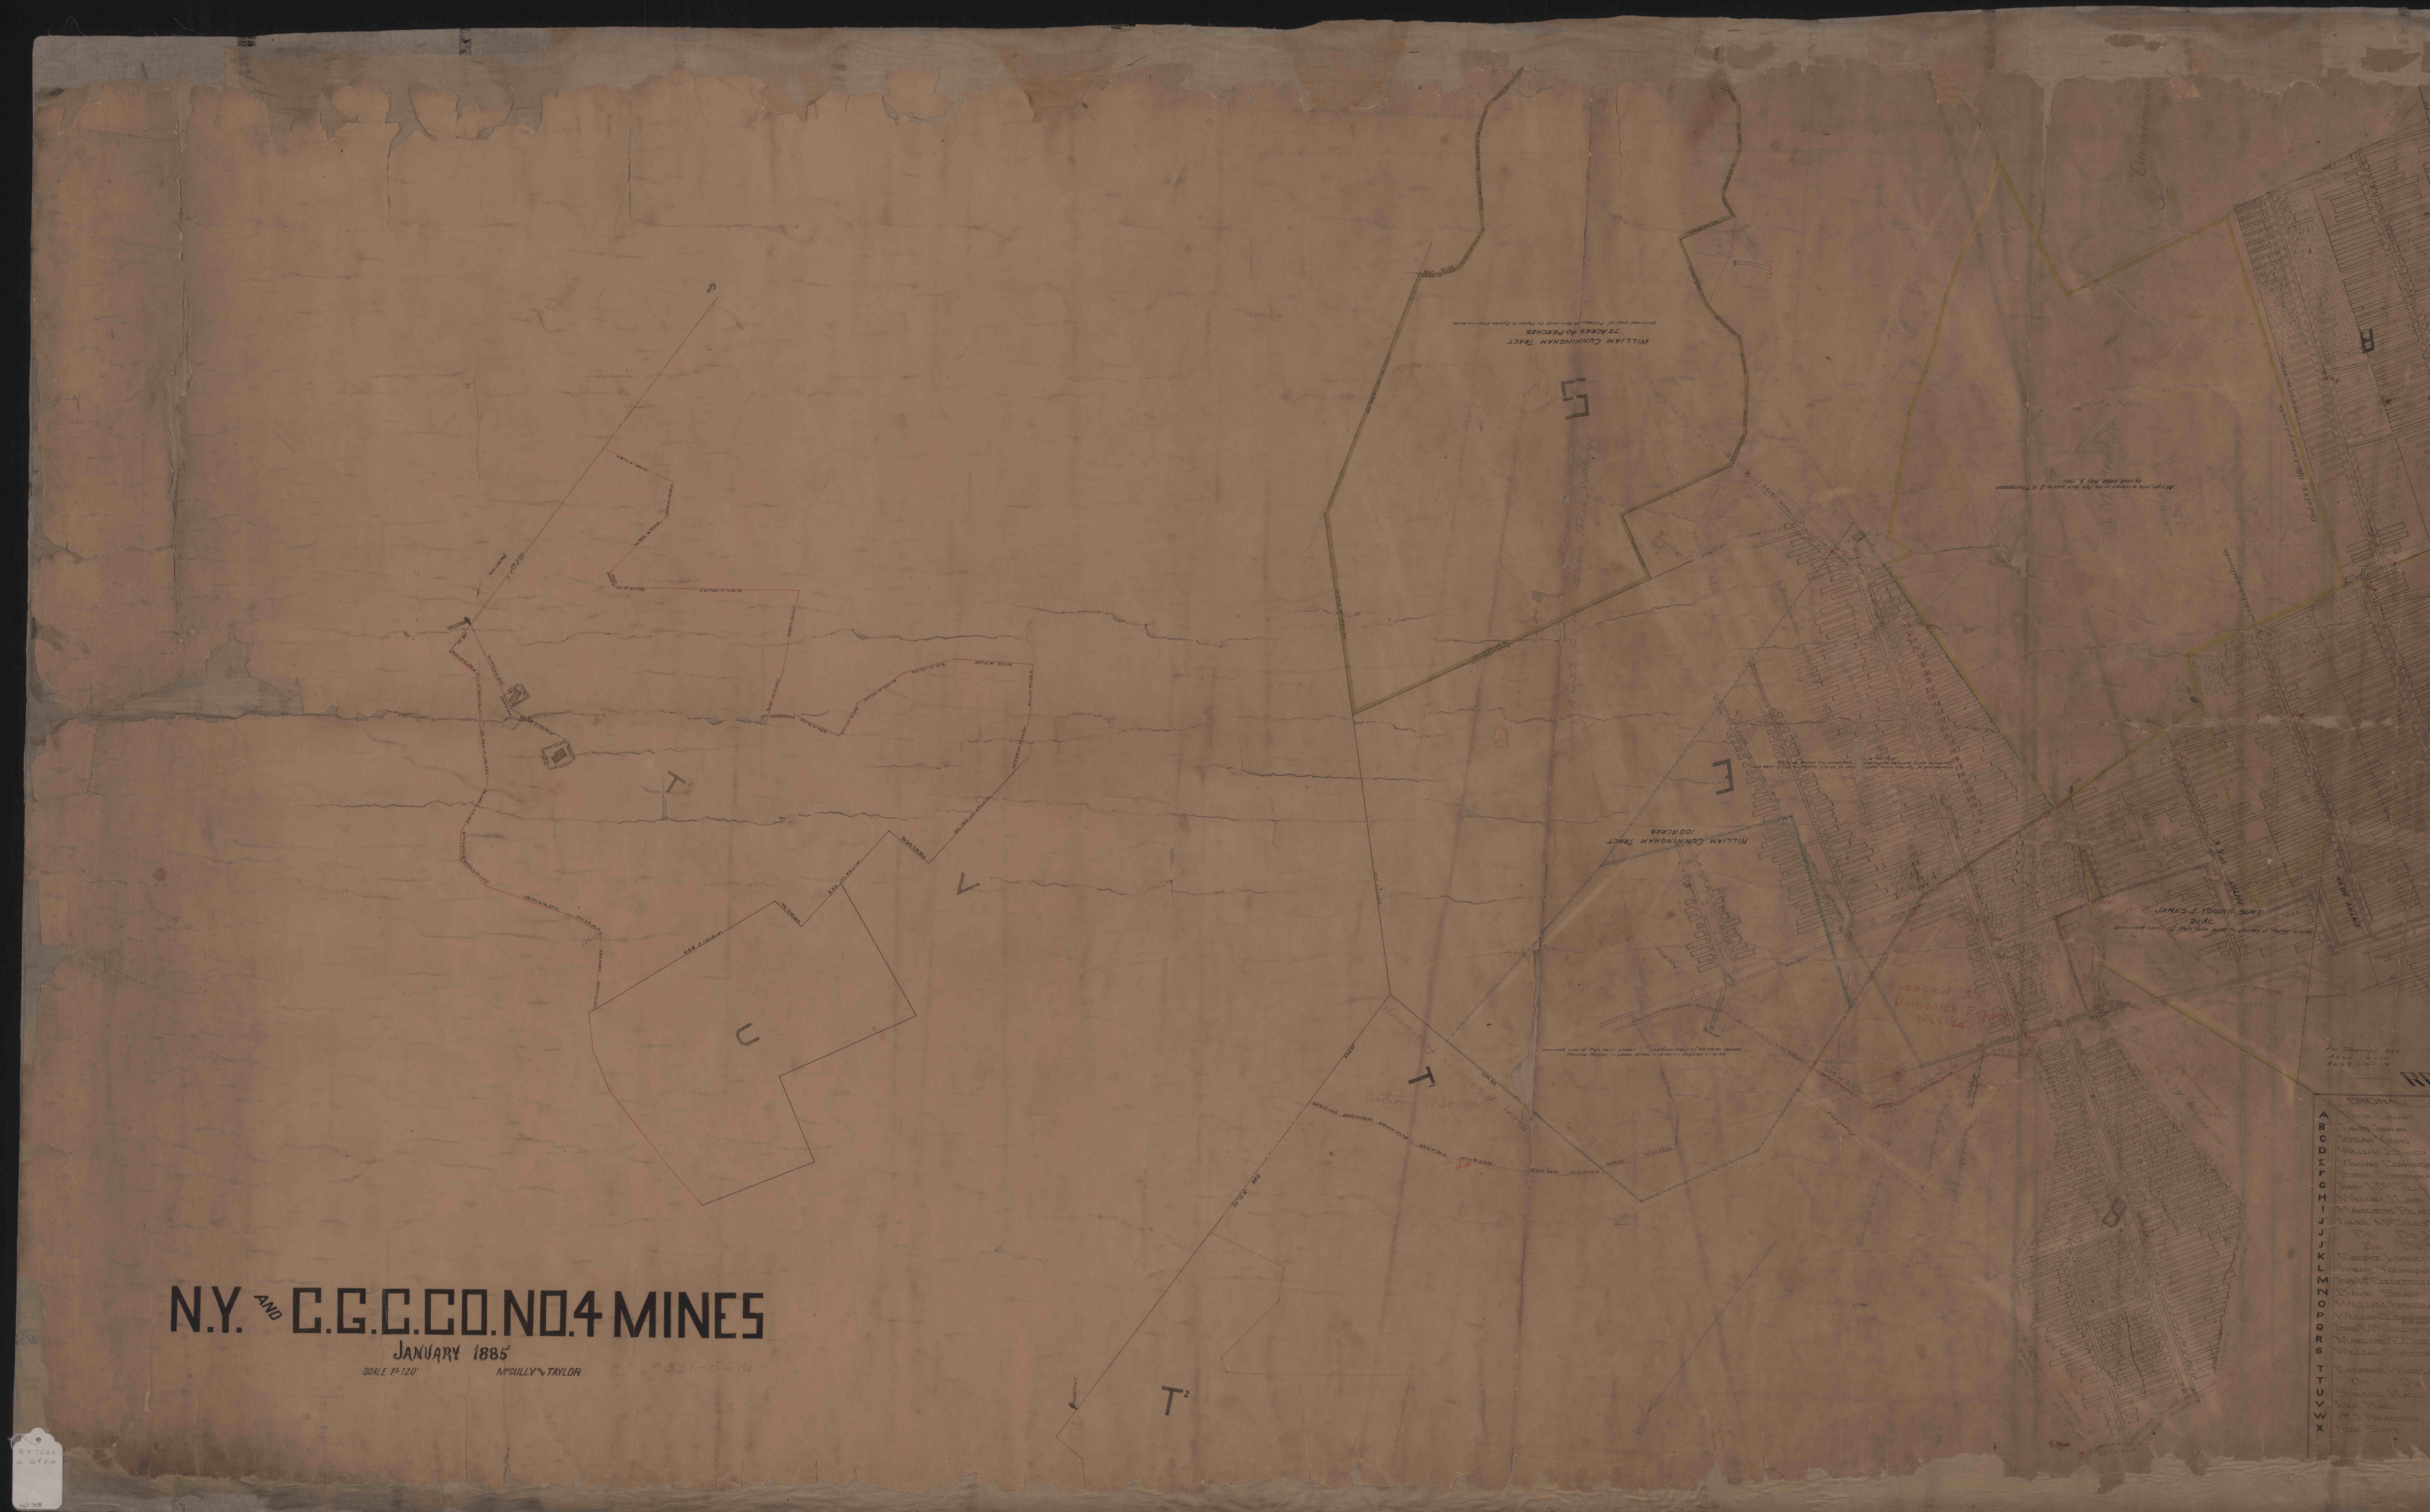

