


60
59
57

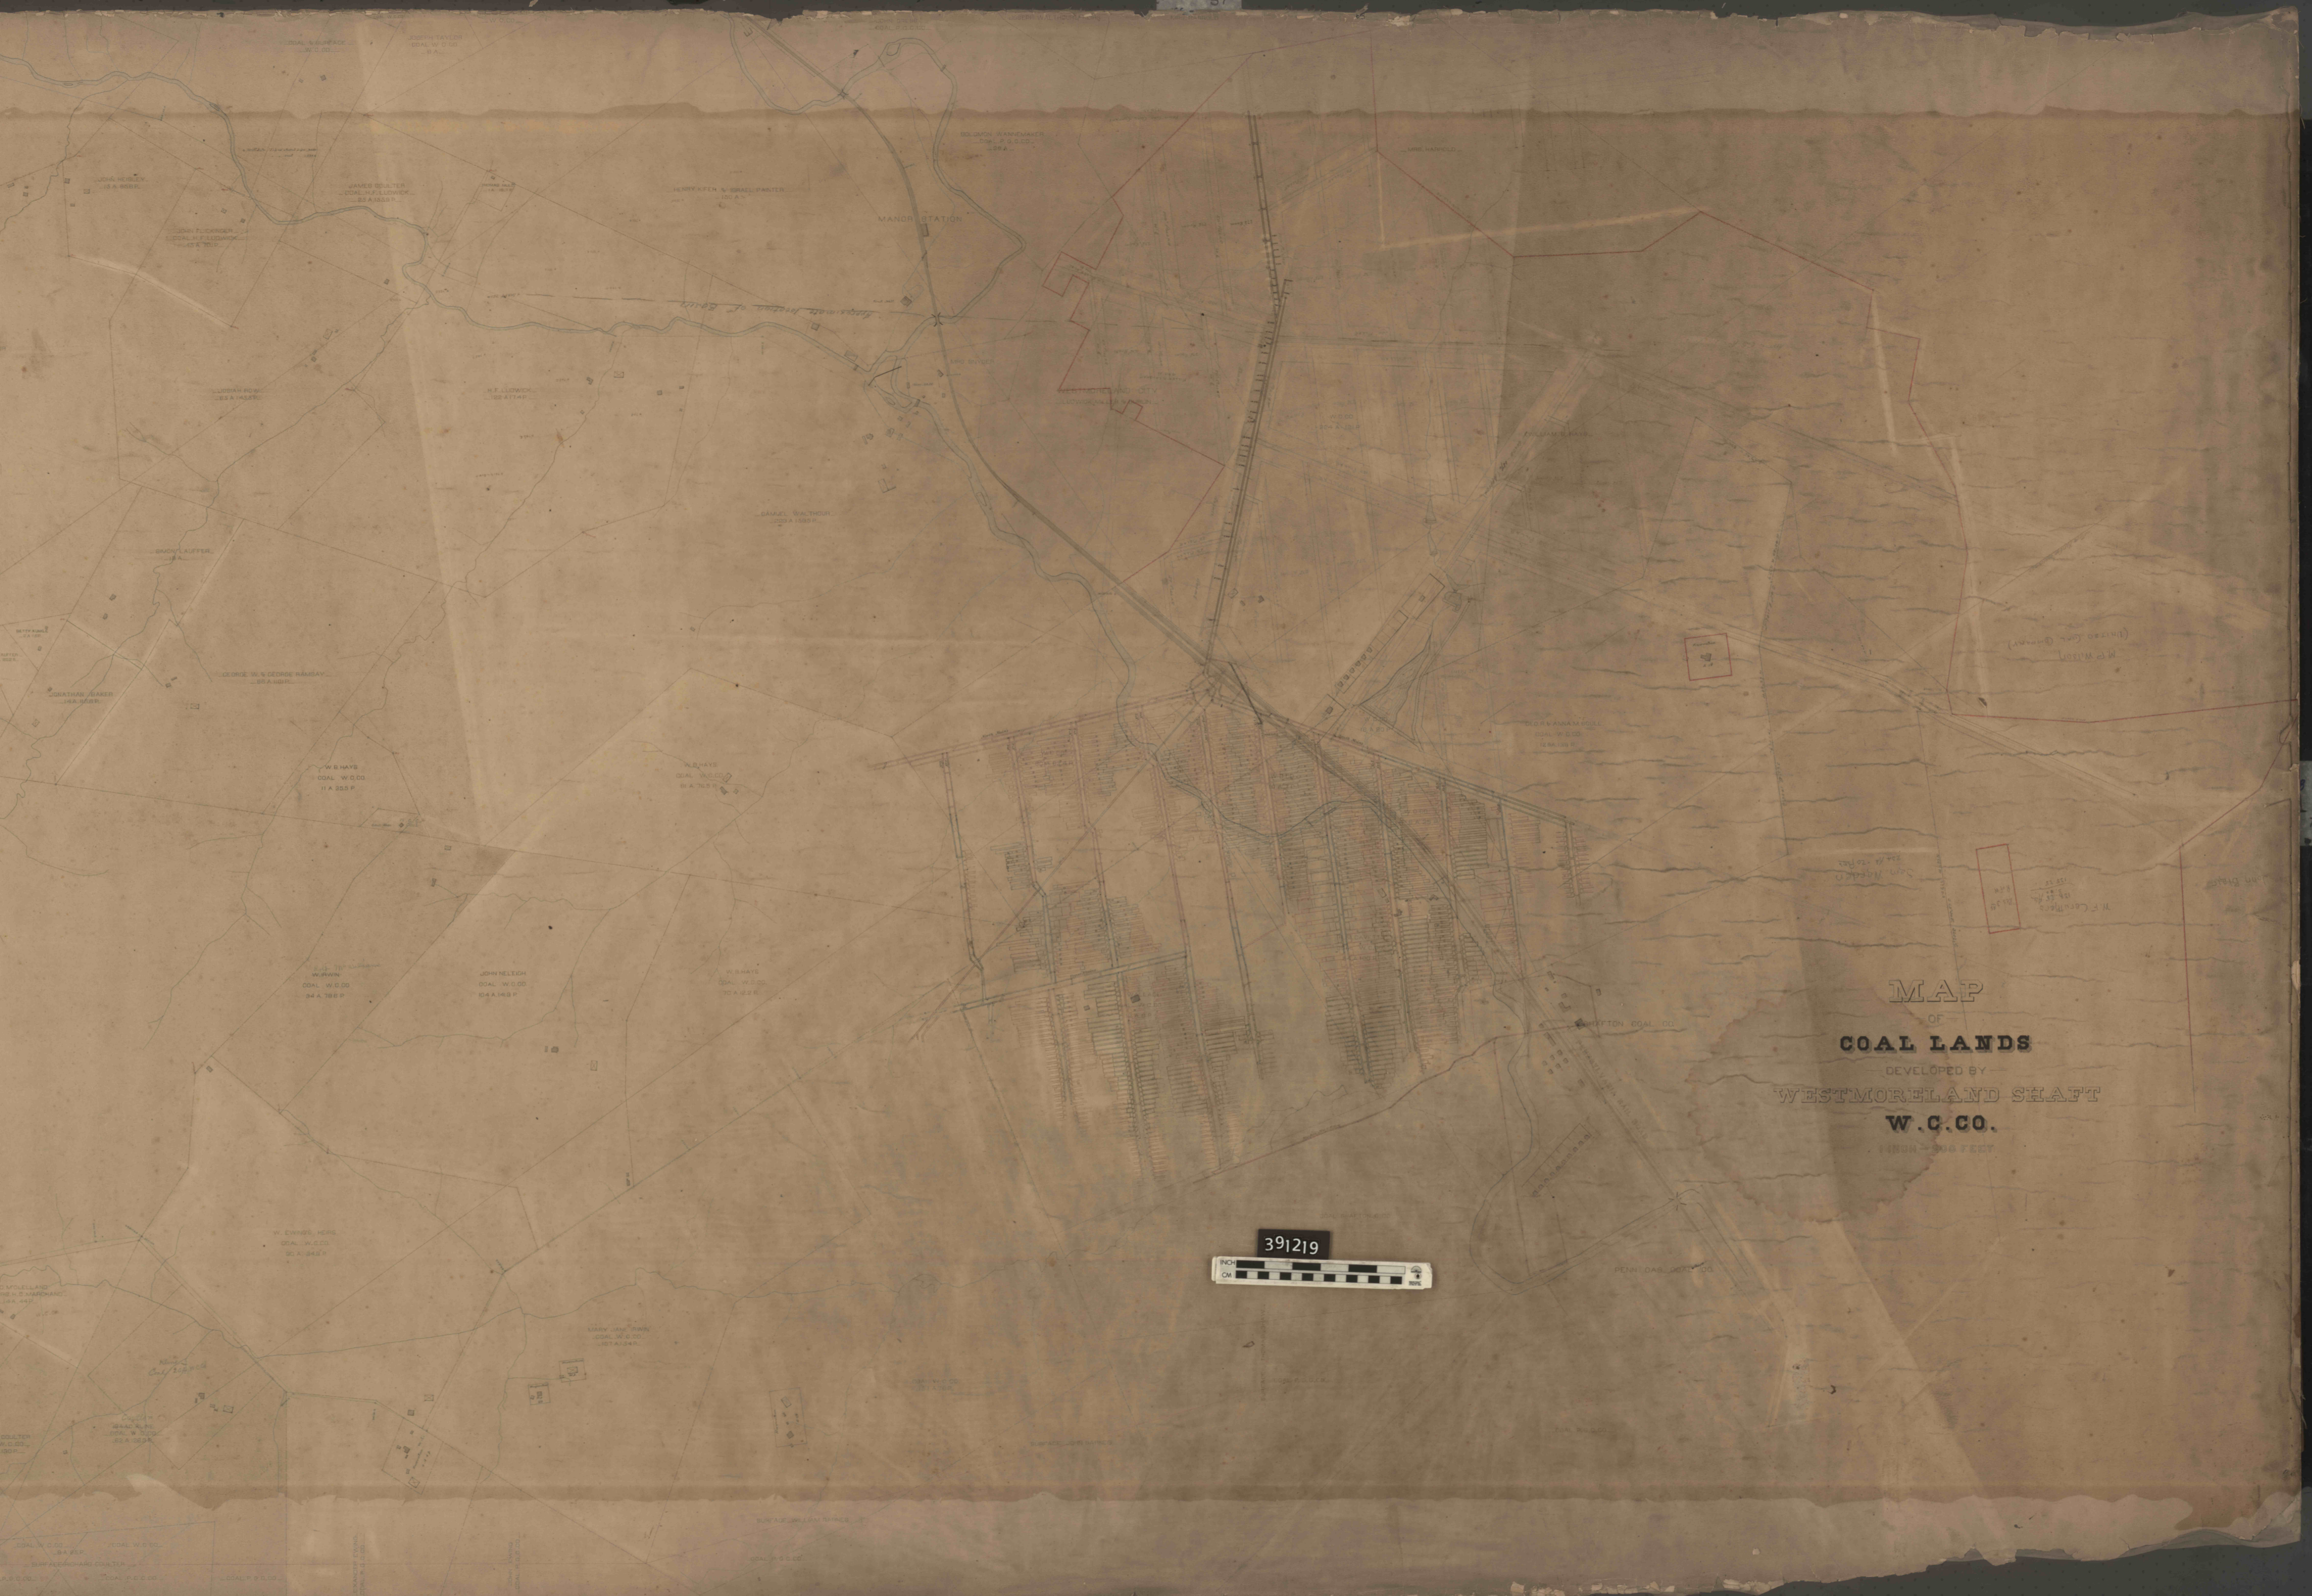

MAP
OF
COAL LANDS
DEVELOPED BY
WESTMORELAND SHAFT
W.C.CO.
1898-1908 FEET



80 82
79 81 83

58
59
60