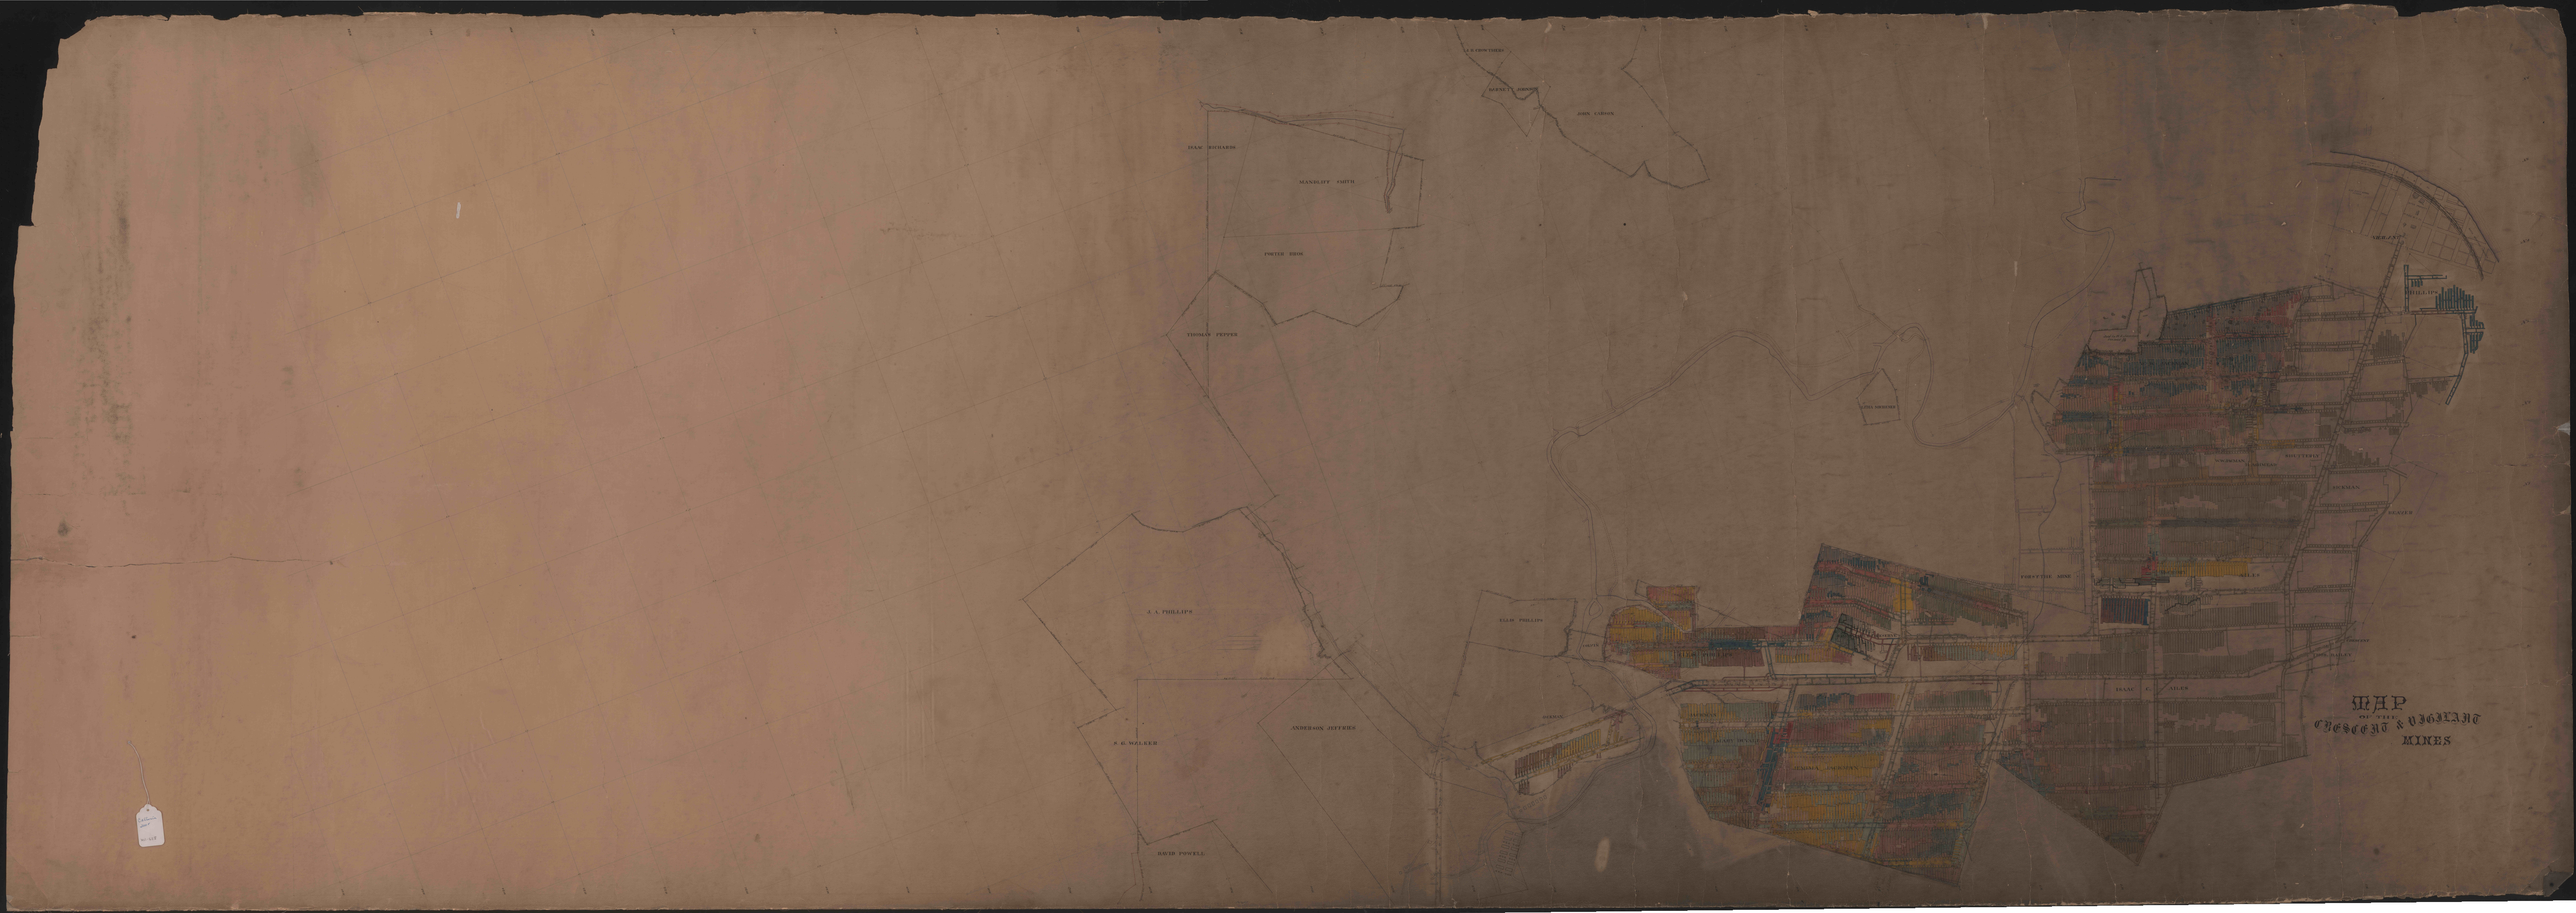
MAP
OF THE
CRESCENT & VIGILANT
MINES
J. S. SOUTHERN
MORRIS JONES
JOHN CORNIN
ISAAC RICHARDS
MANDLIFF SMITH
PETER EDDY
THOMAS PEPPER
JOHN MORRIS
J. A. PHILLIPS
ELIAS PHILLIPS
ANDERSON JEFFRIES
S. G. WALKER
DAVID POWELL
PRIESTLY MINE
ISAAC C. ATLEE
SOUTHERN
HUNTSMAN
ROGERS
ATLEE
PHILLIPS
GREAT