


387724

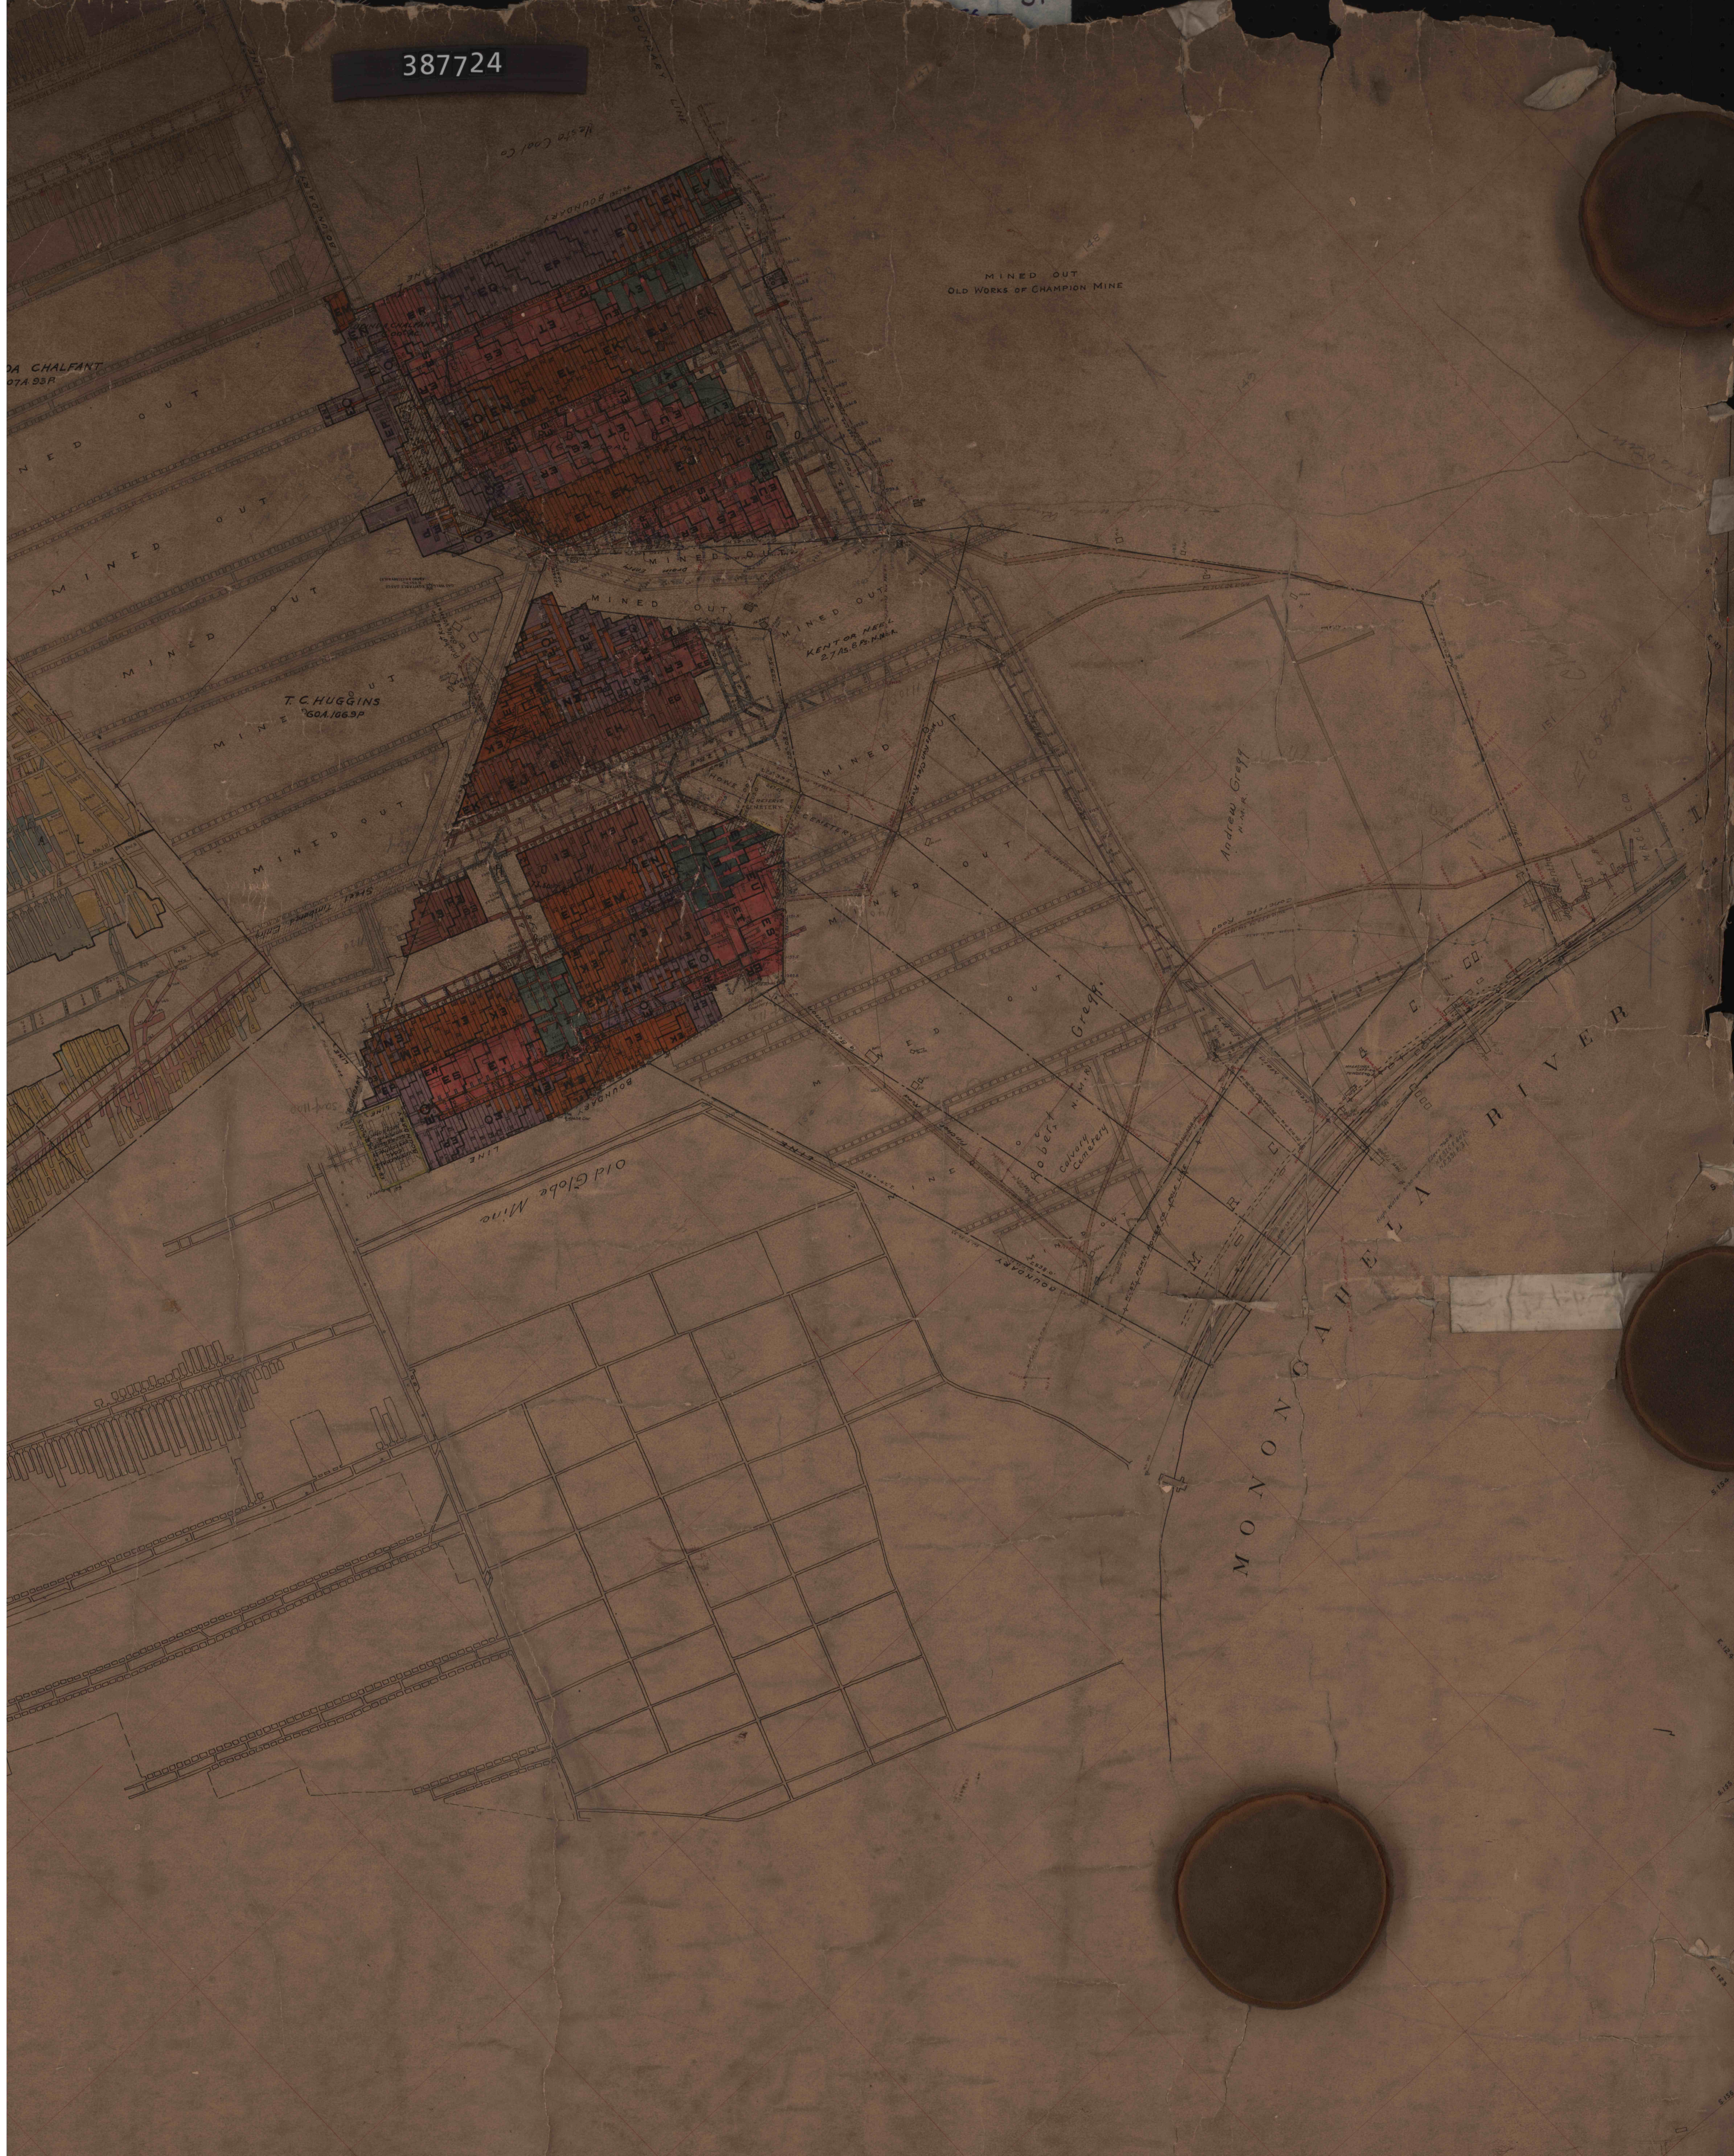

