


DATE: 11/25/85
BY: [illegible]

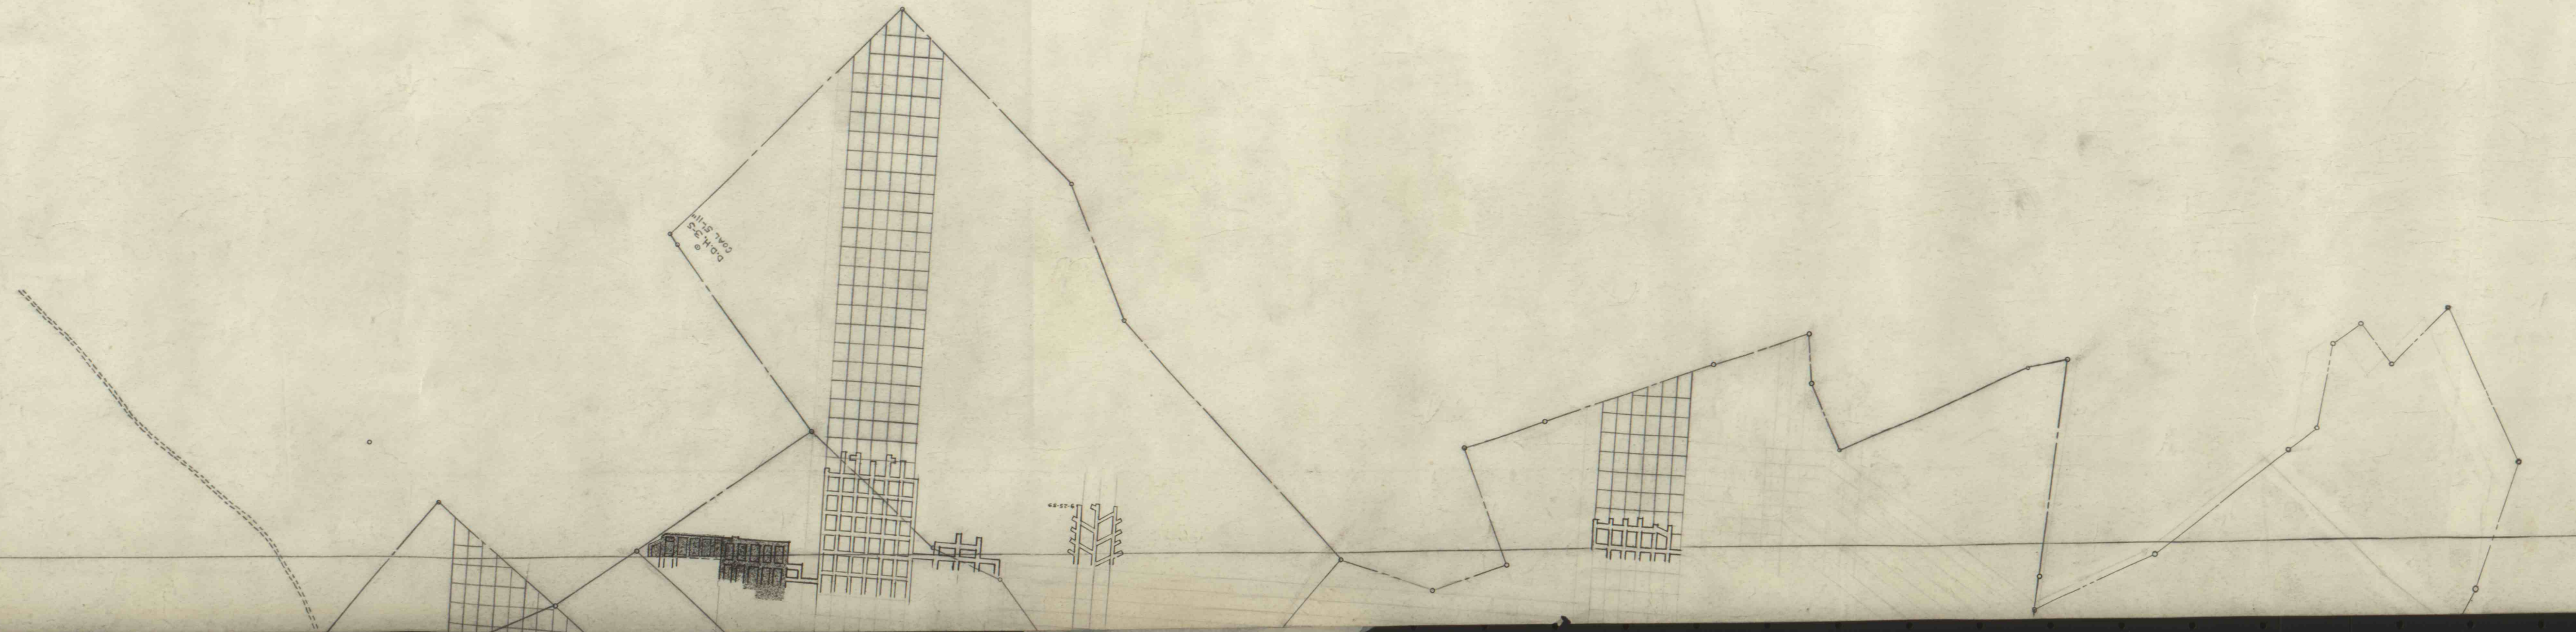

DATE: 11/25/85
BY: [illegible]

66-07-0