


38
- 37
- 36

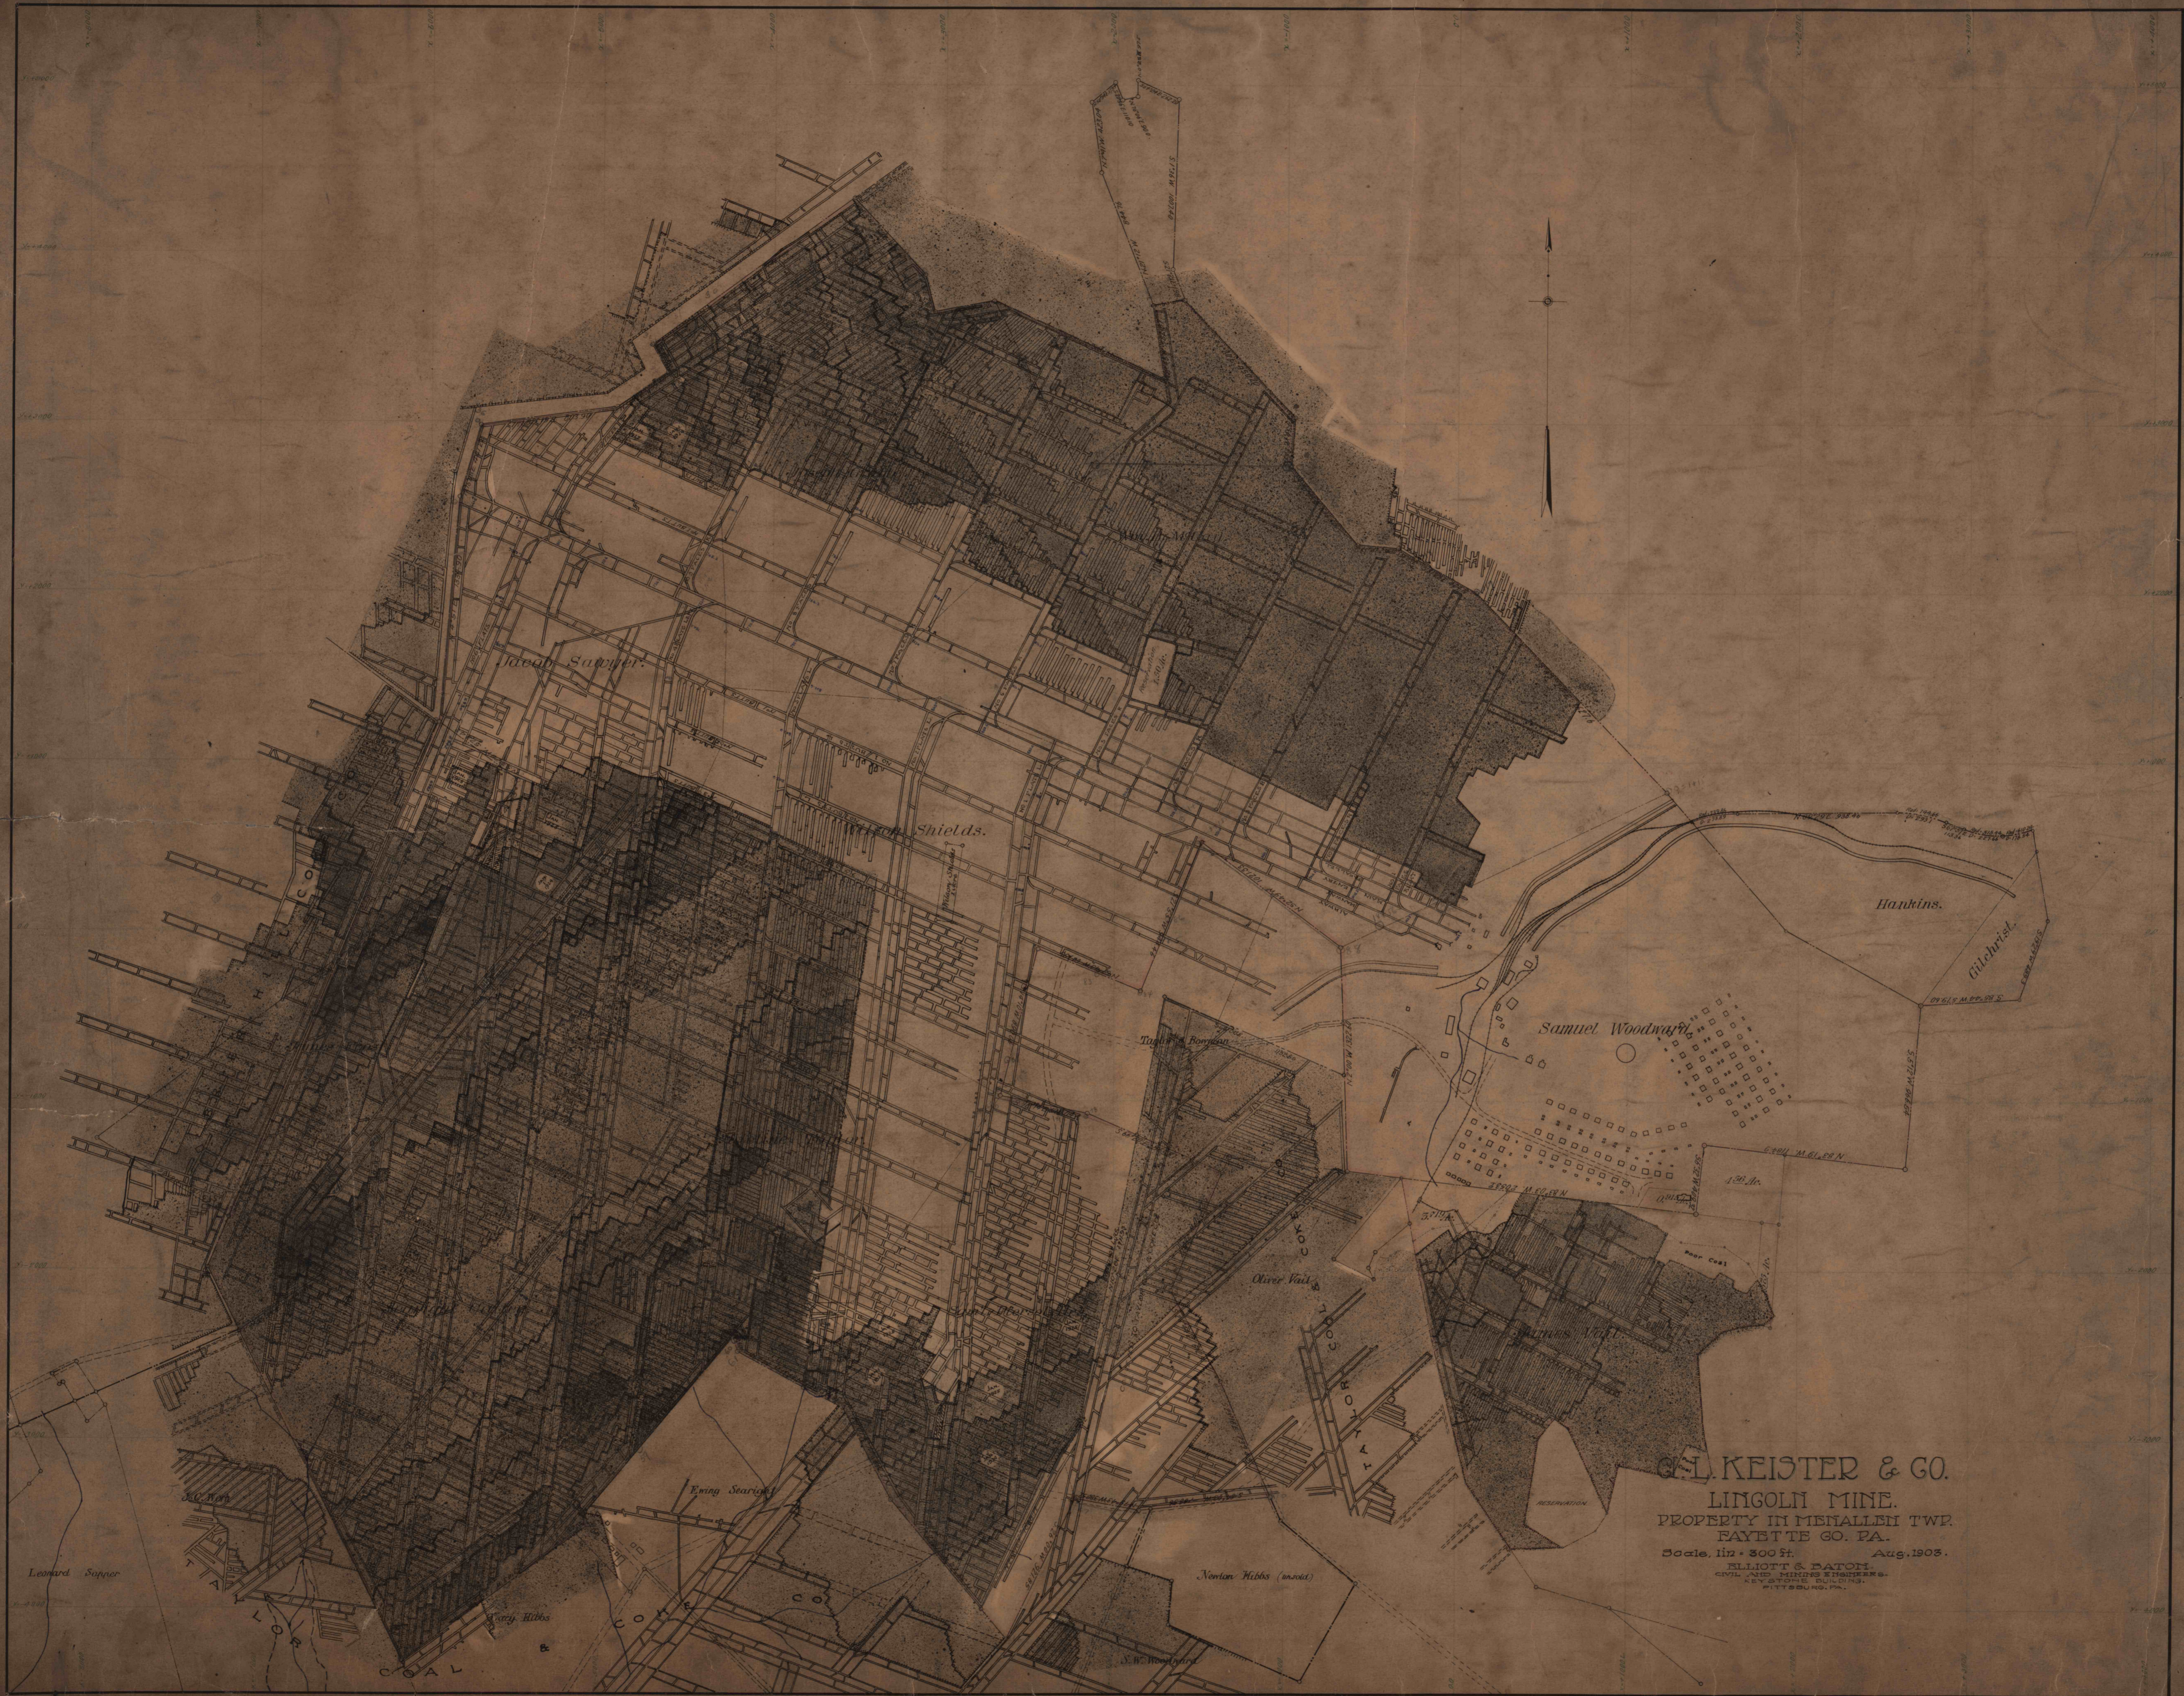

KEISTER & CO.
 LINGOH MINE.
 PROPERTY IN MENALLEN TWP.
 FAYETTE CO. PA.
 Scale, 1 in = 300 ft. Aug. 1903.
 ELLIOTT & BAYNE
 CIVIL AND MINE ENGINEERS
 KEWATONE BUILDING
 PITTSBURGH, PA.



1" = 300'

387716
178

38
- 37
- 29