


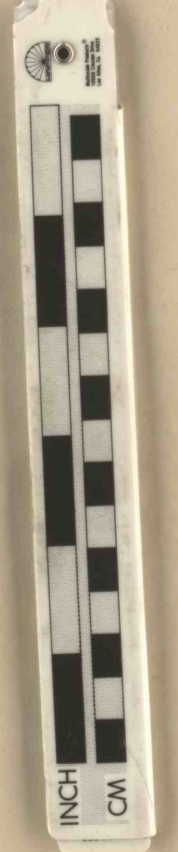

LEGEND  
 DRILL HOLES  
 1981 WORKINGS  
 FAULTY AREAS  
 ADDITIONAL WELLS  
 PLUMBERS - RECTIFIERS  
 RESERVES - OUTSIDE  
 SURFACE OWNED  
 1982  
 JANUARY  
 FEBRUARY  
 MARCH  
 APRIL  
 MAY  
 JUNE  
 JULY  
 AUGUST  
 SEPTEMBER  
 OCTOBER  
 NOVEMBER  
 DECEMBER  
 RENTON MINE  
 1982  
 1"=500'



40-  
 41-  
 42-  
 43-  
 44-  
 45-

72 74  
 71 73 75