



Revised
June 24, 1903
Pittsburgh Co.
No. 600

BANNING NO 2 MINE PITTSBURG COAL CO.

ARRANGEMENT OF EMPTY AND FULL TRACKS
FOR ENDLESS ROPE HAULAGE LANDING AT N#1
FACE ENTRY LEFT.
Scale 1" = 8' Feb 1903.

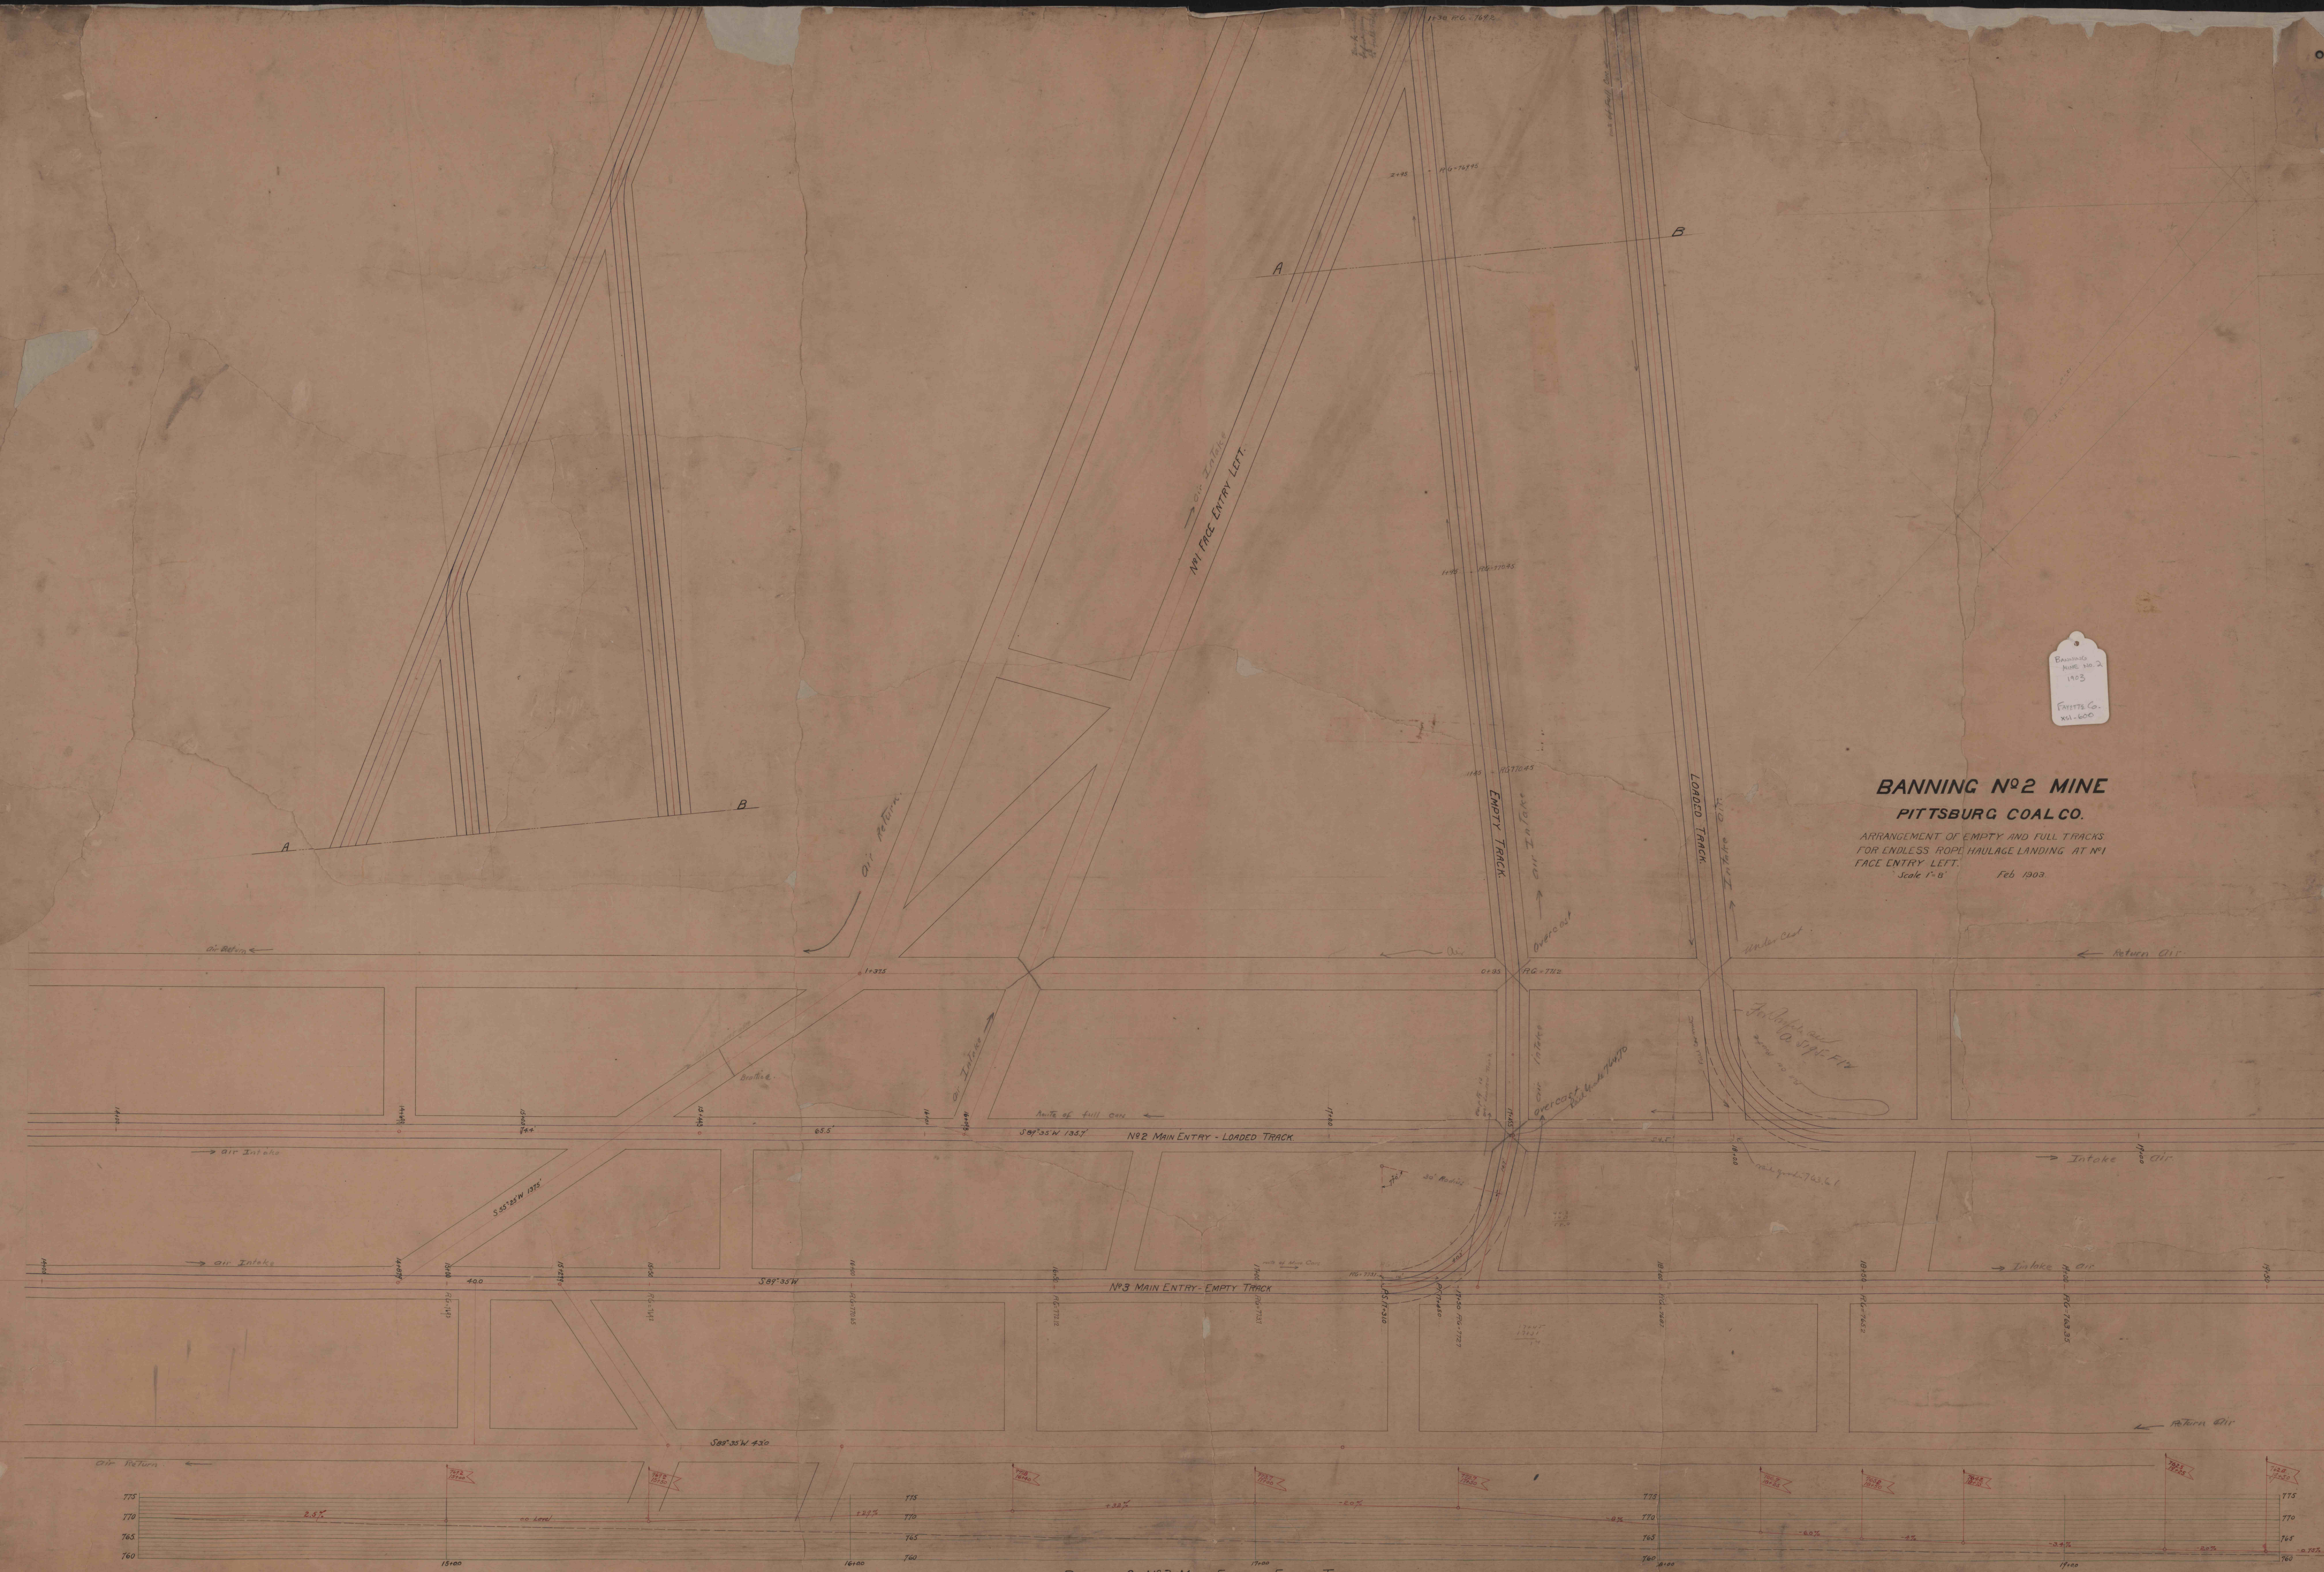

PROFILE OF EMPTY TRACK
Natural Scale 1" = 8'

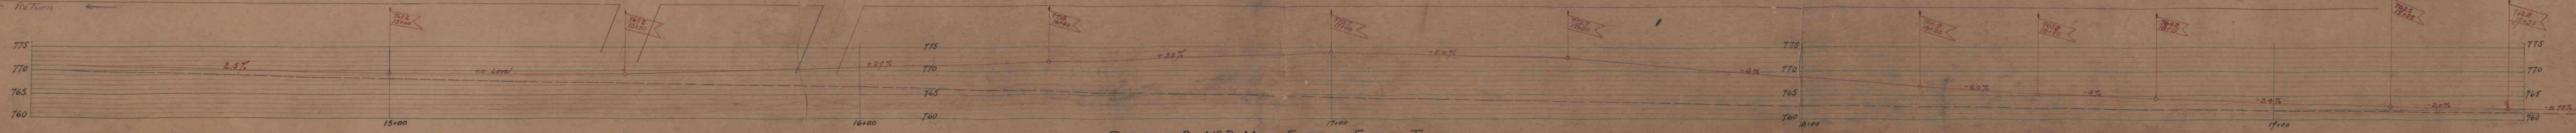

PROFILE OF N#3 MAIN ENTRY EMPTY TRACK.
Natural Scale - 1" = 8' Feb 03.