

57  
59  
60

PL 11 590 A-B

TORRENCE HARB.  
P.O. TO U.S.C.O.  
1887.

L.A. WOODS  





MINED OUT

MINED OUT

MINED OUT


MINED OUT

UNITED COA

391155



LOST

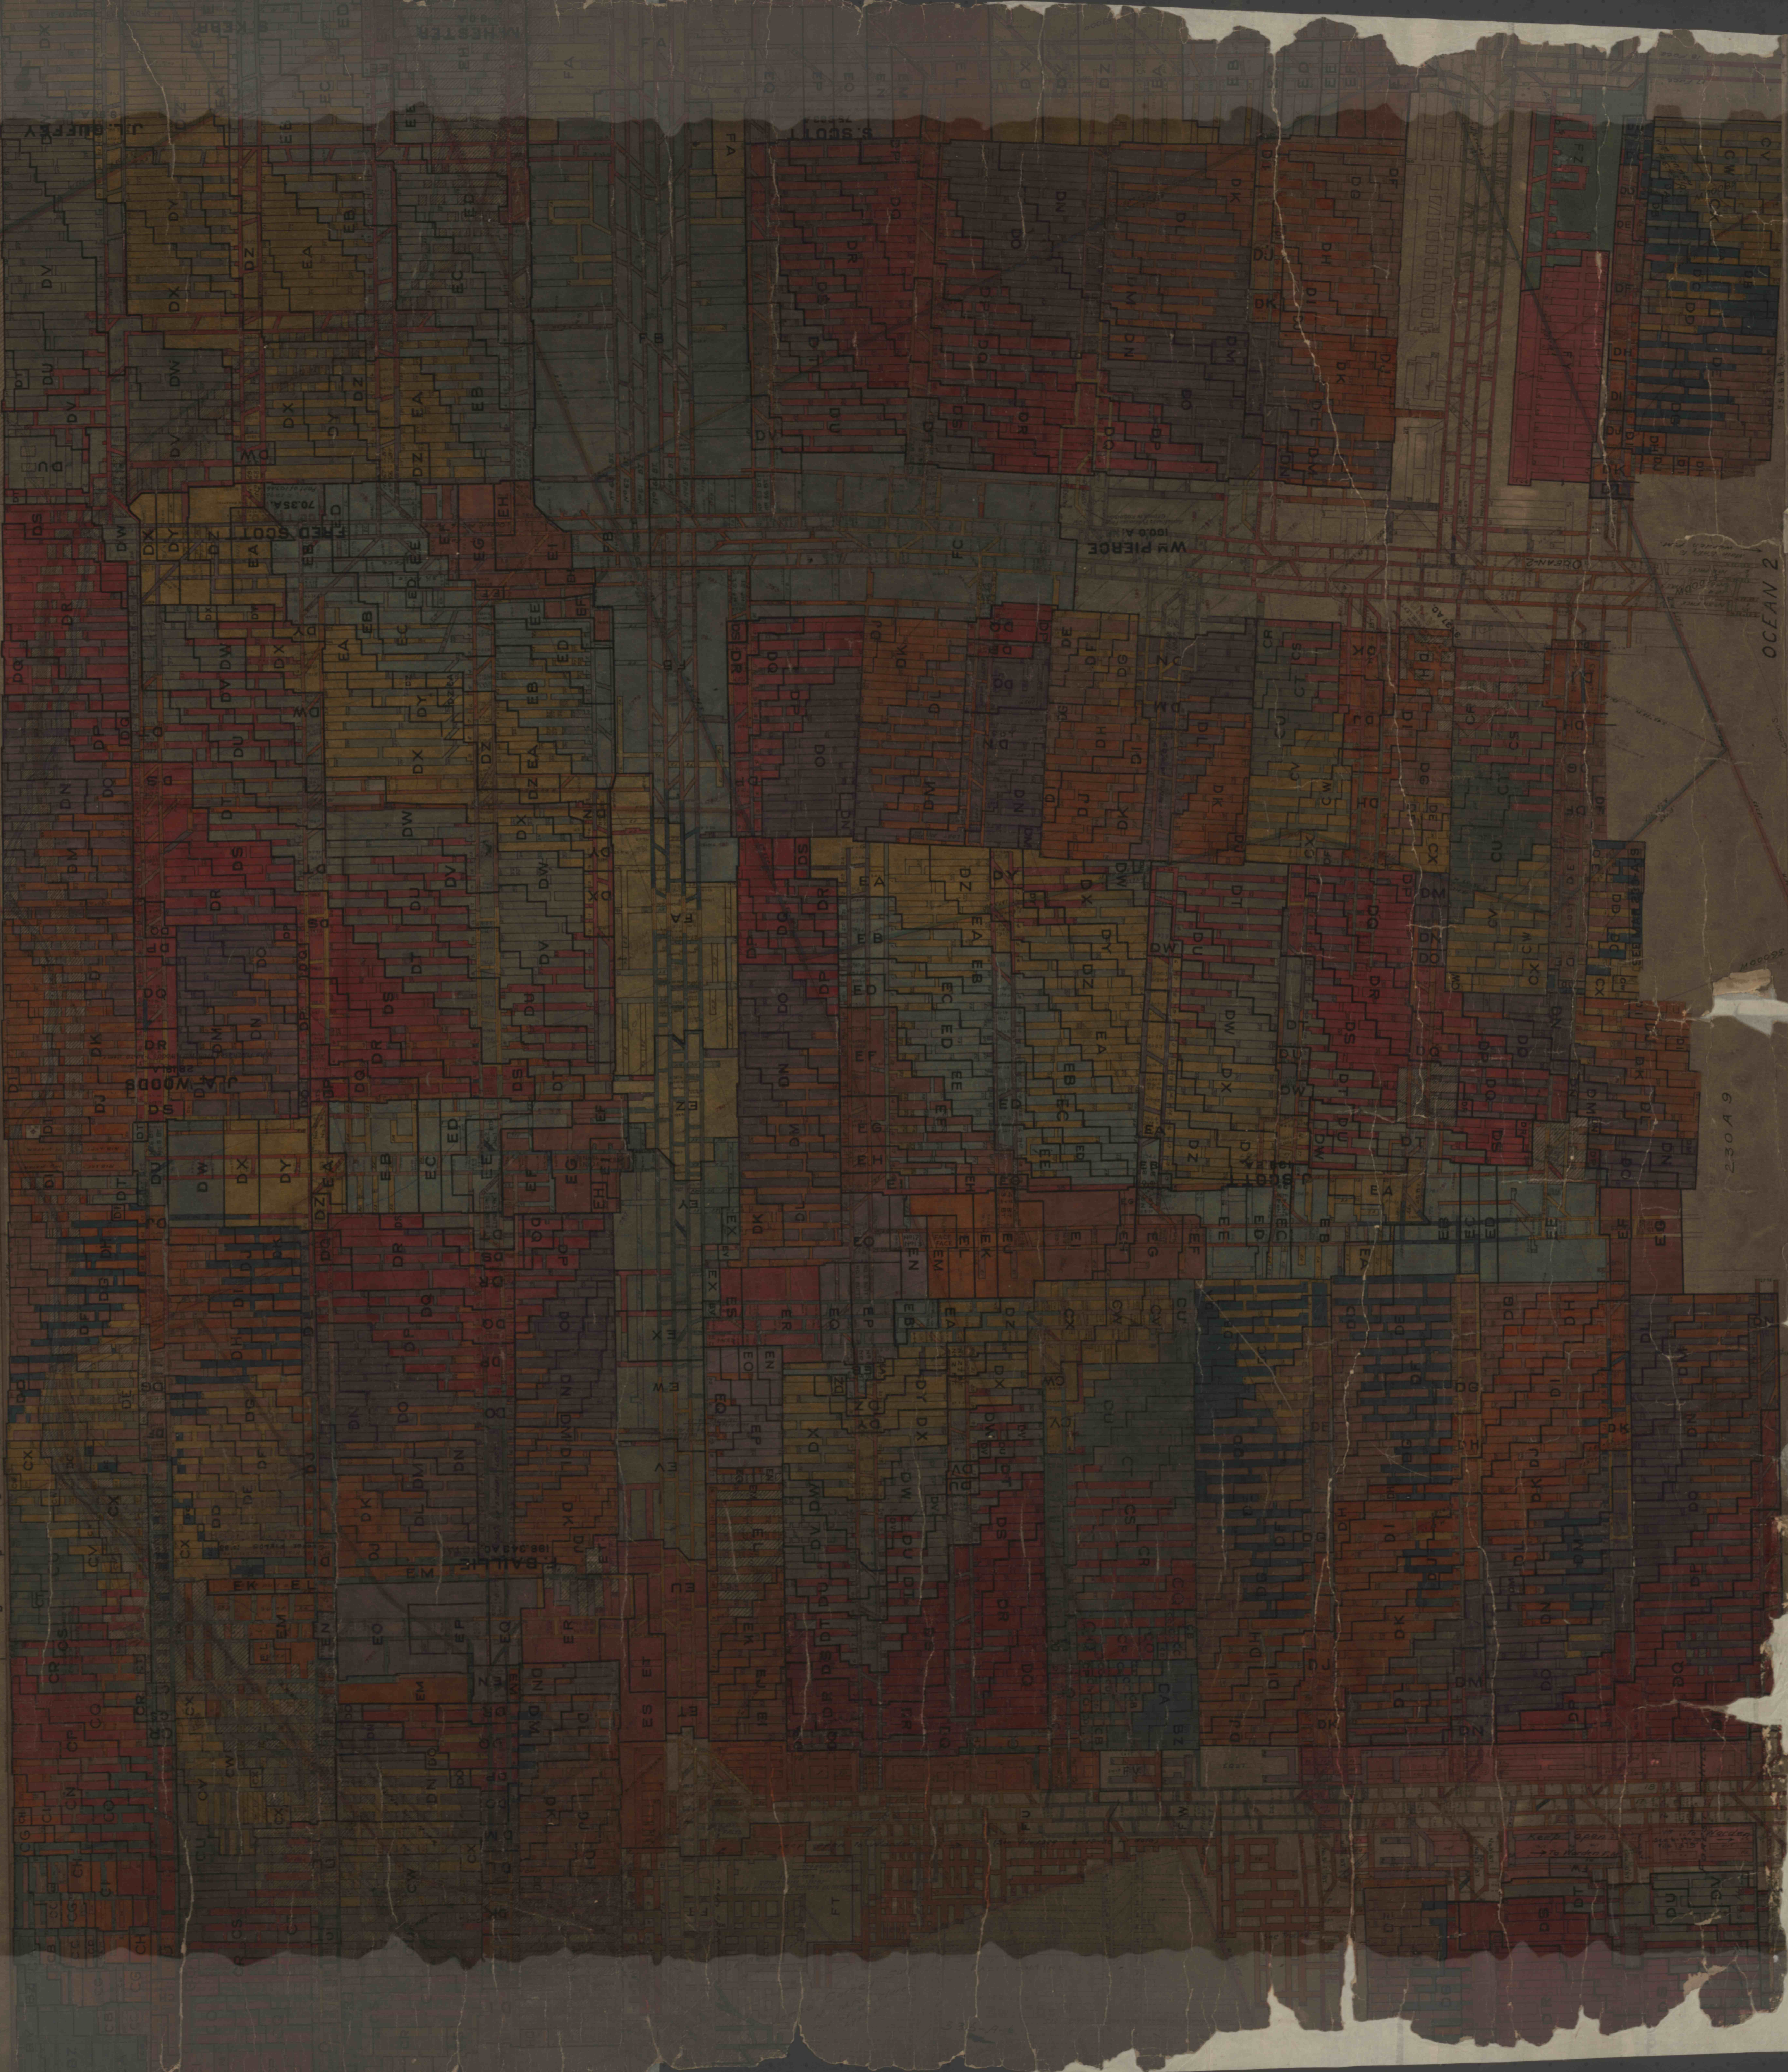

OCEAN 2

230A9

66 68 70  
67 69

56  
57  
58  
59  
60