
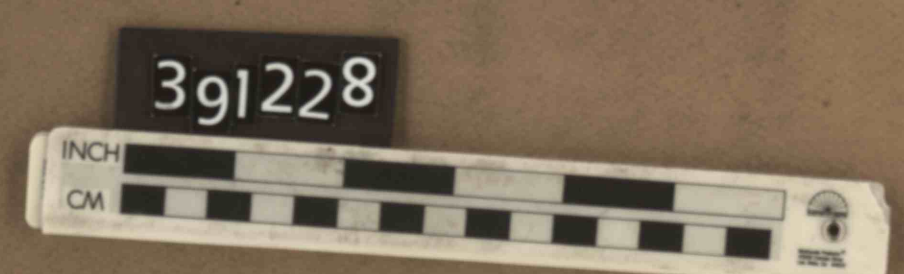





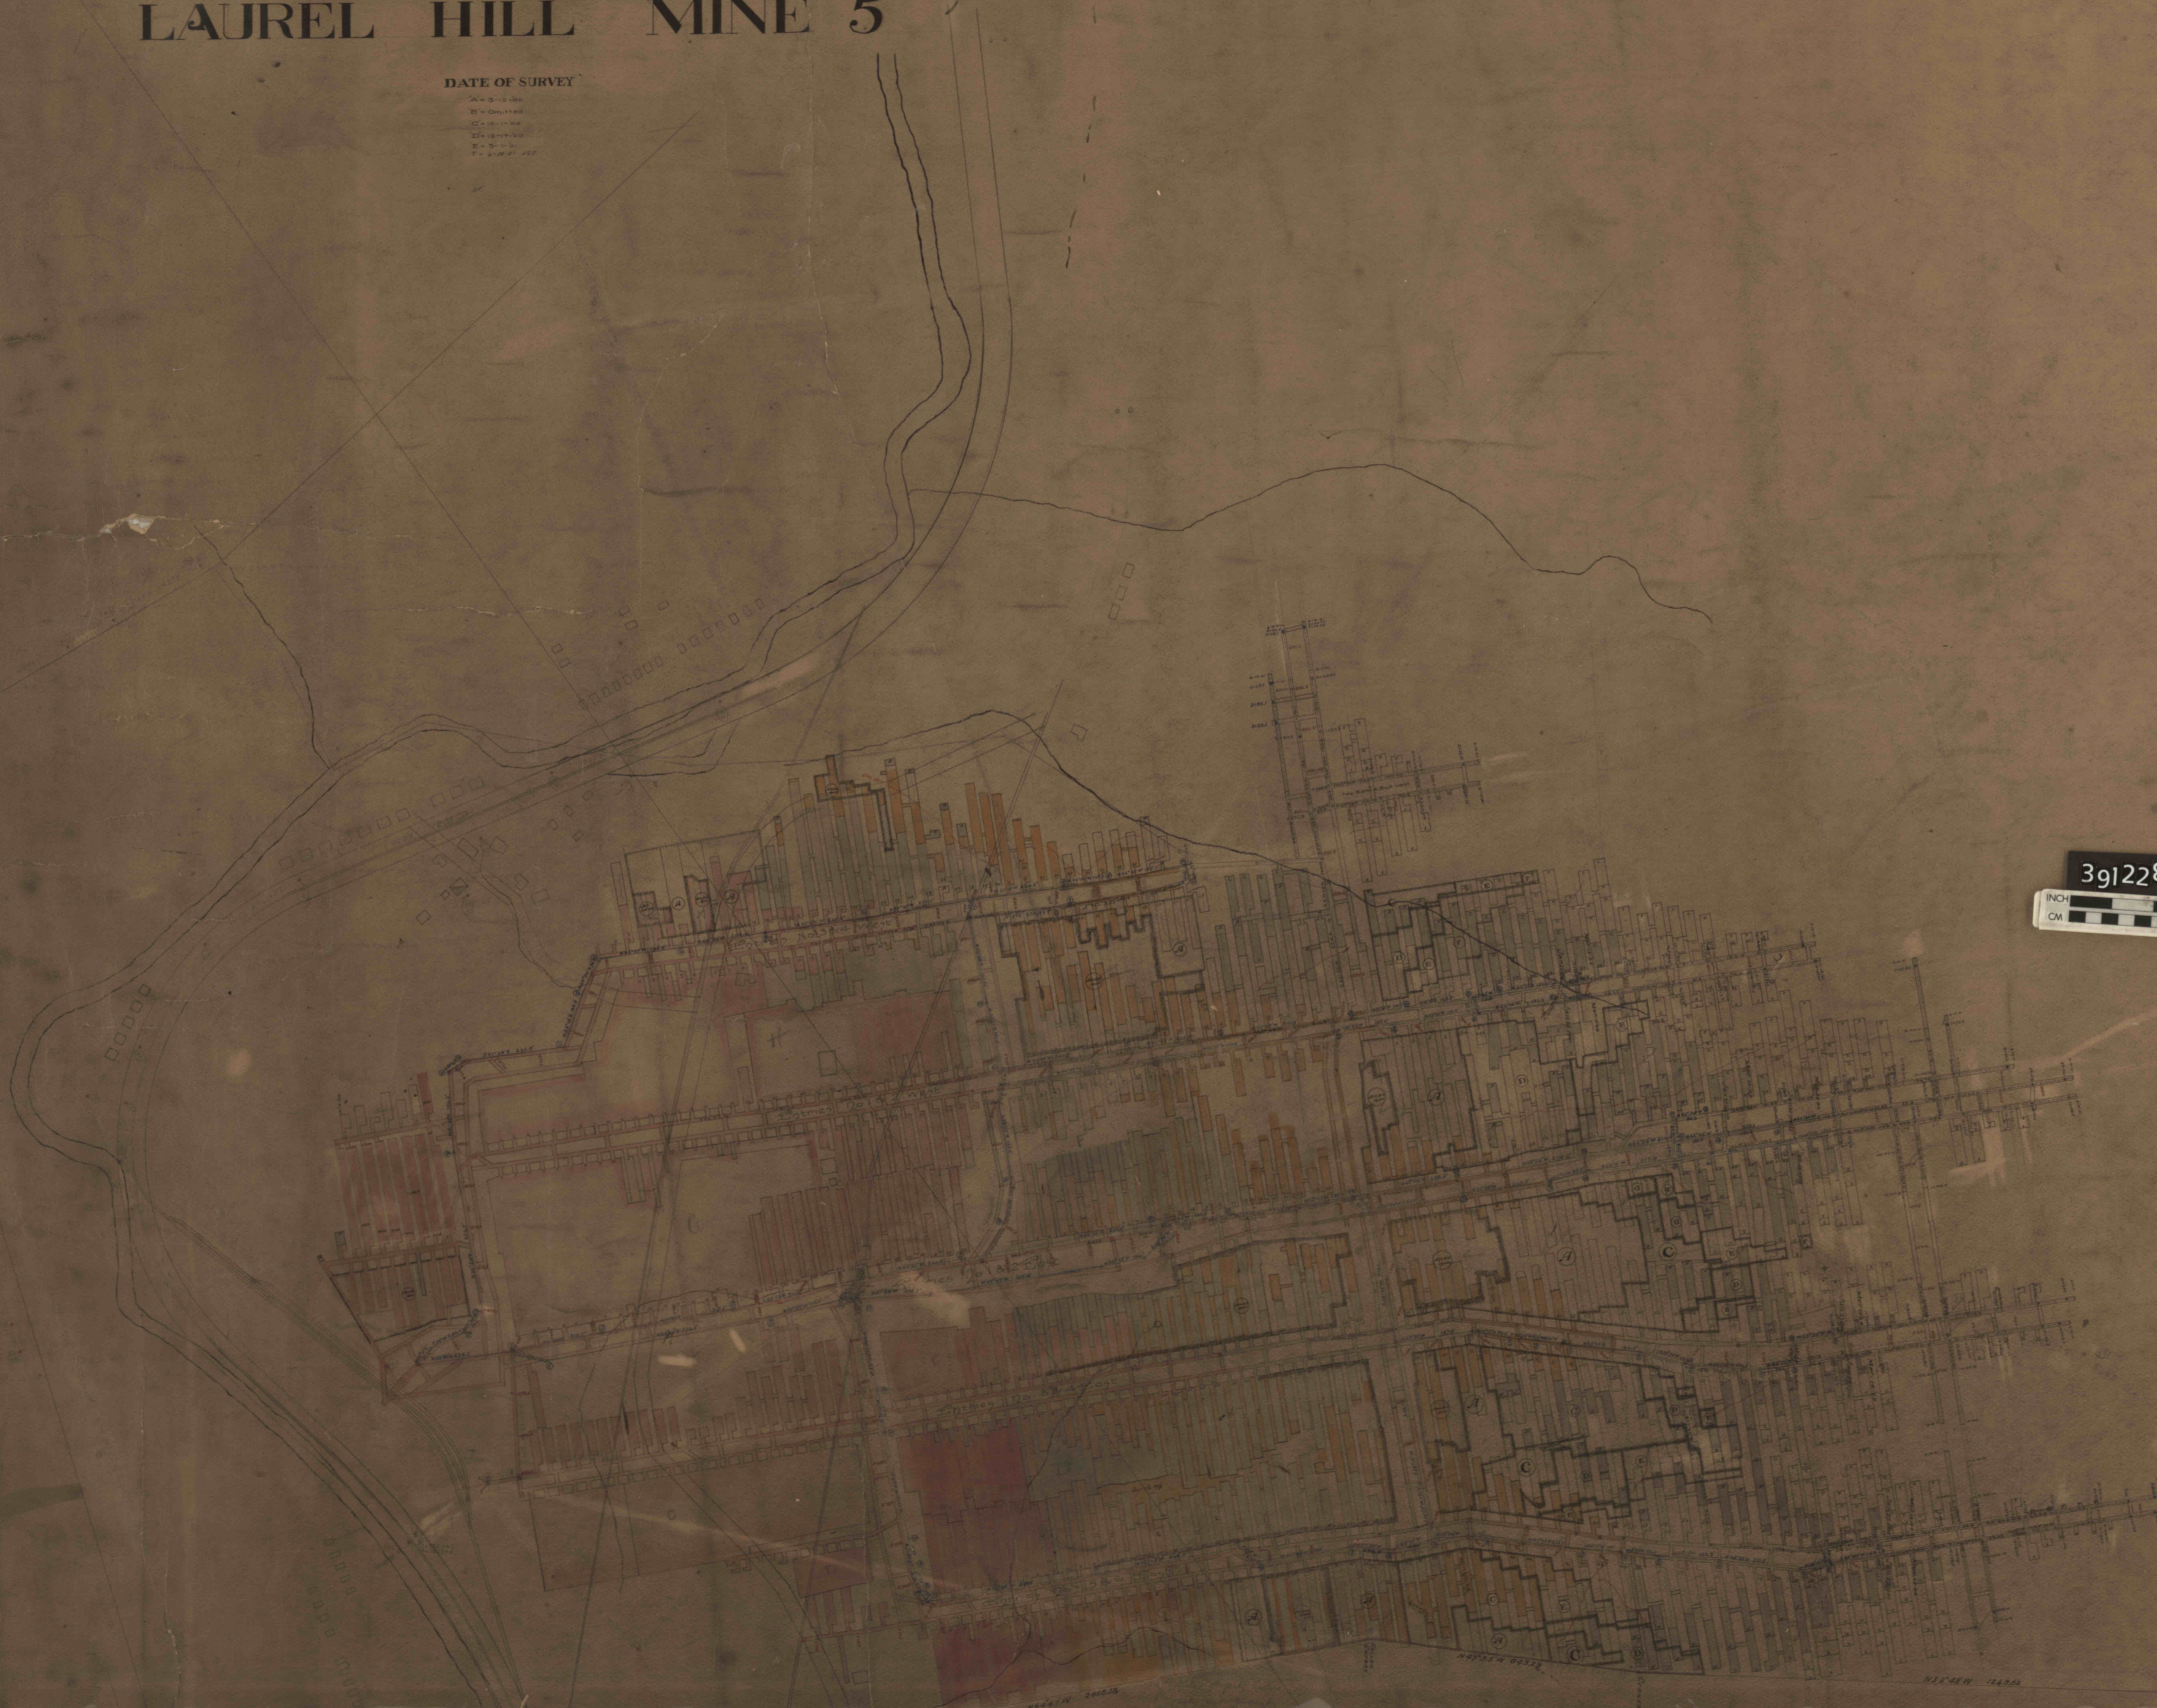

60
59

86
87
89

59
60