


50
49
47
46

84 82 80
11 11 11 11
85 83 81 79

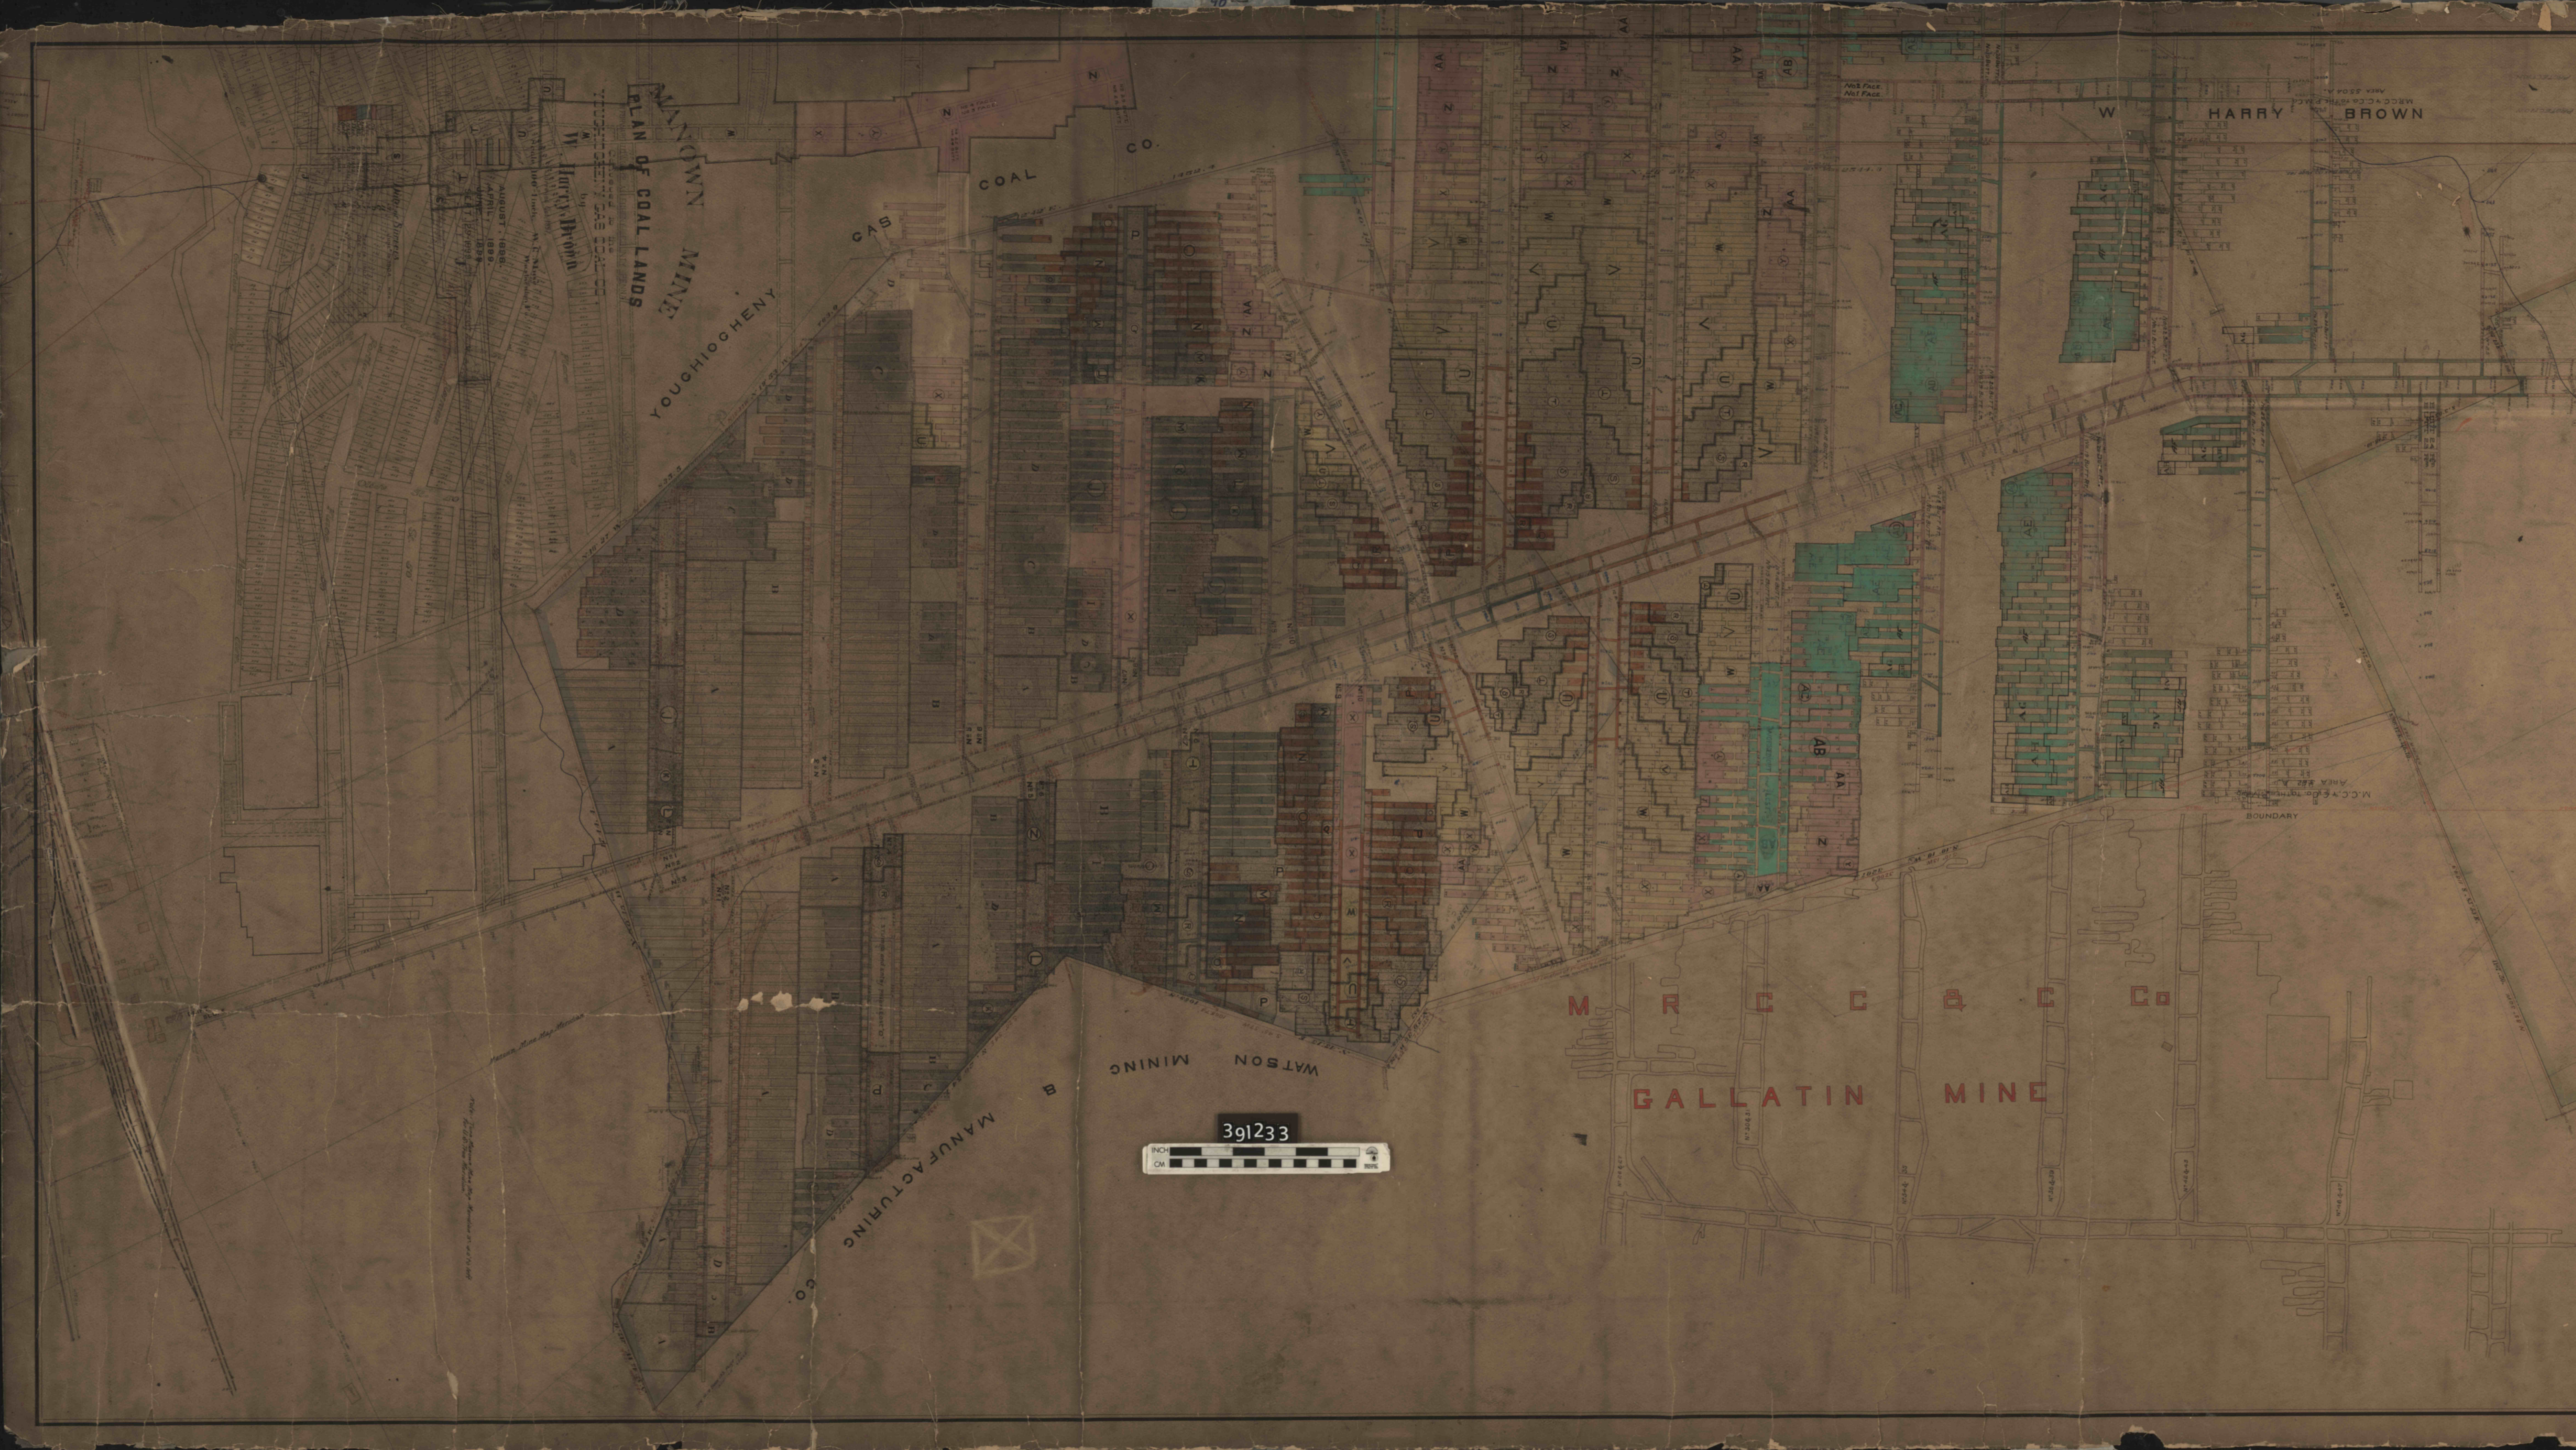

391233

46
47
48
49