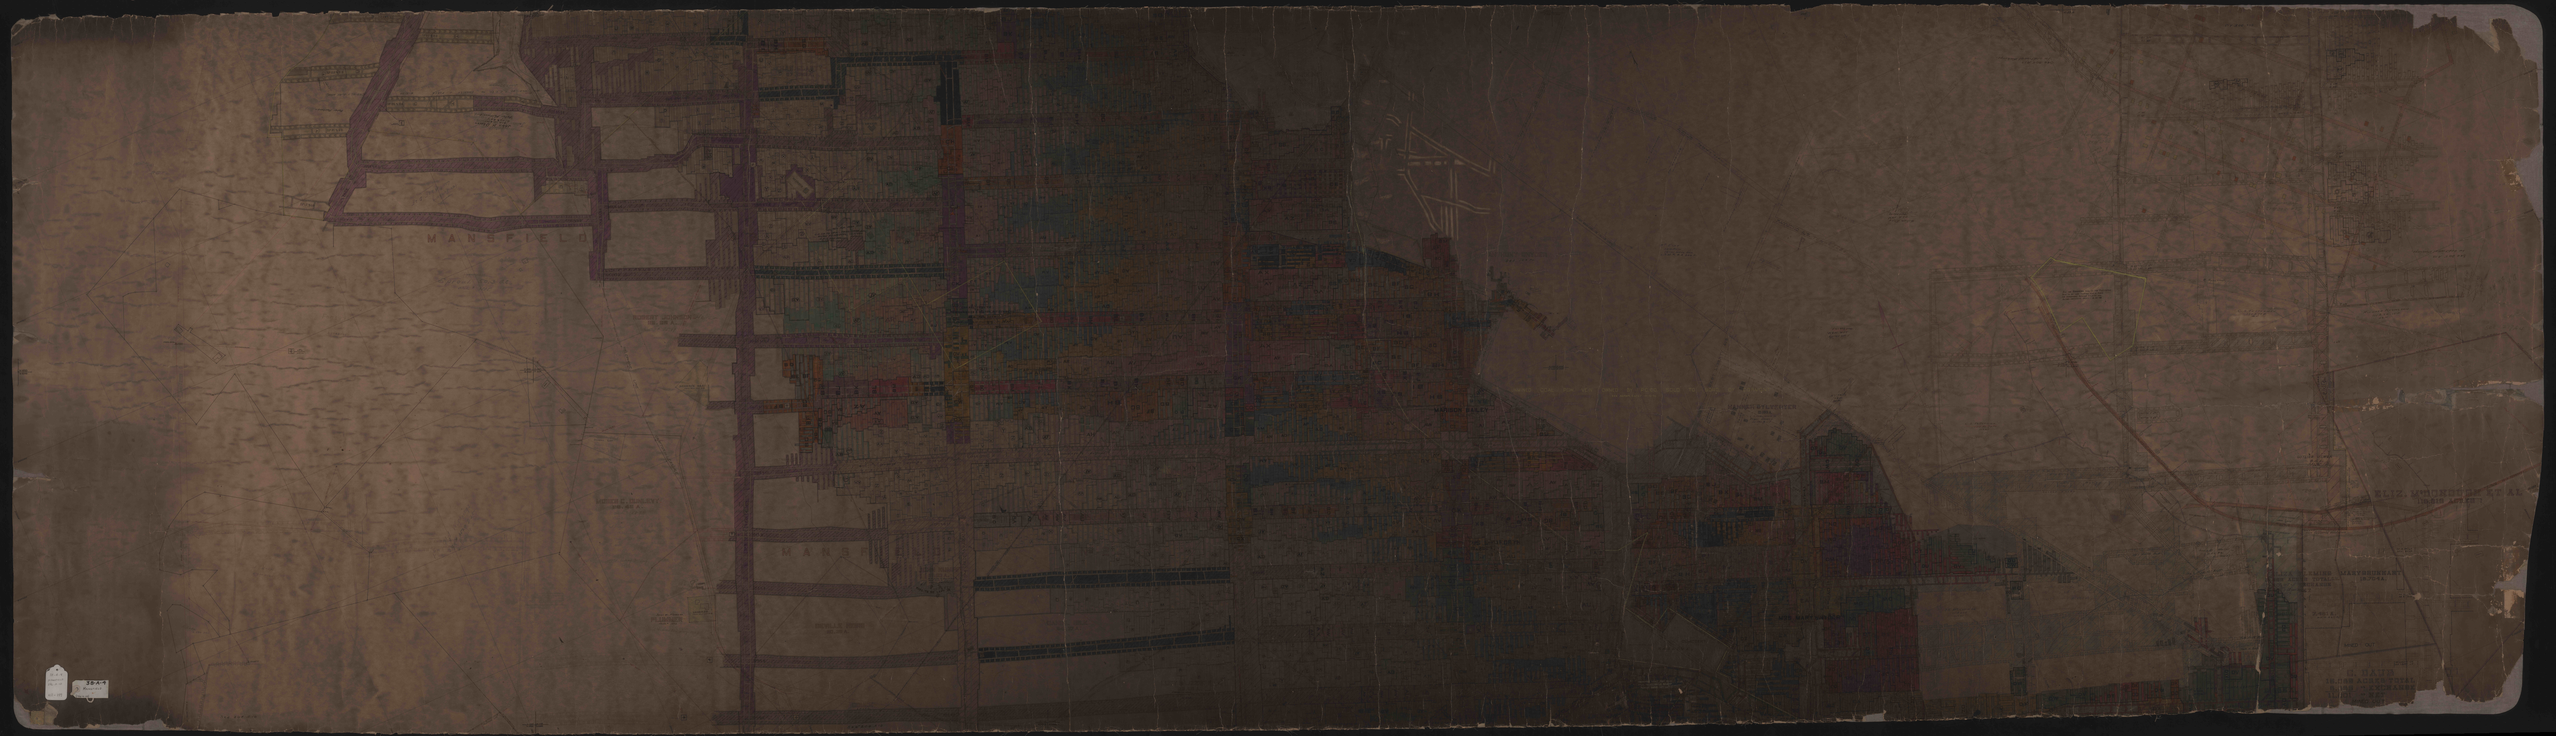
MANS
