


60
58

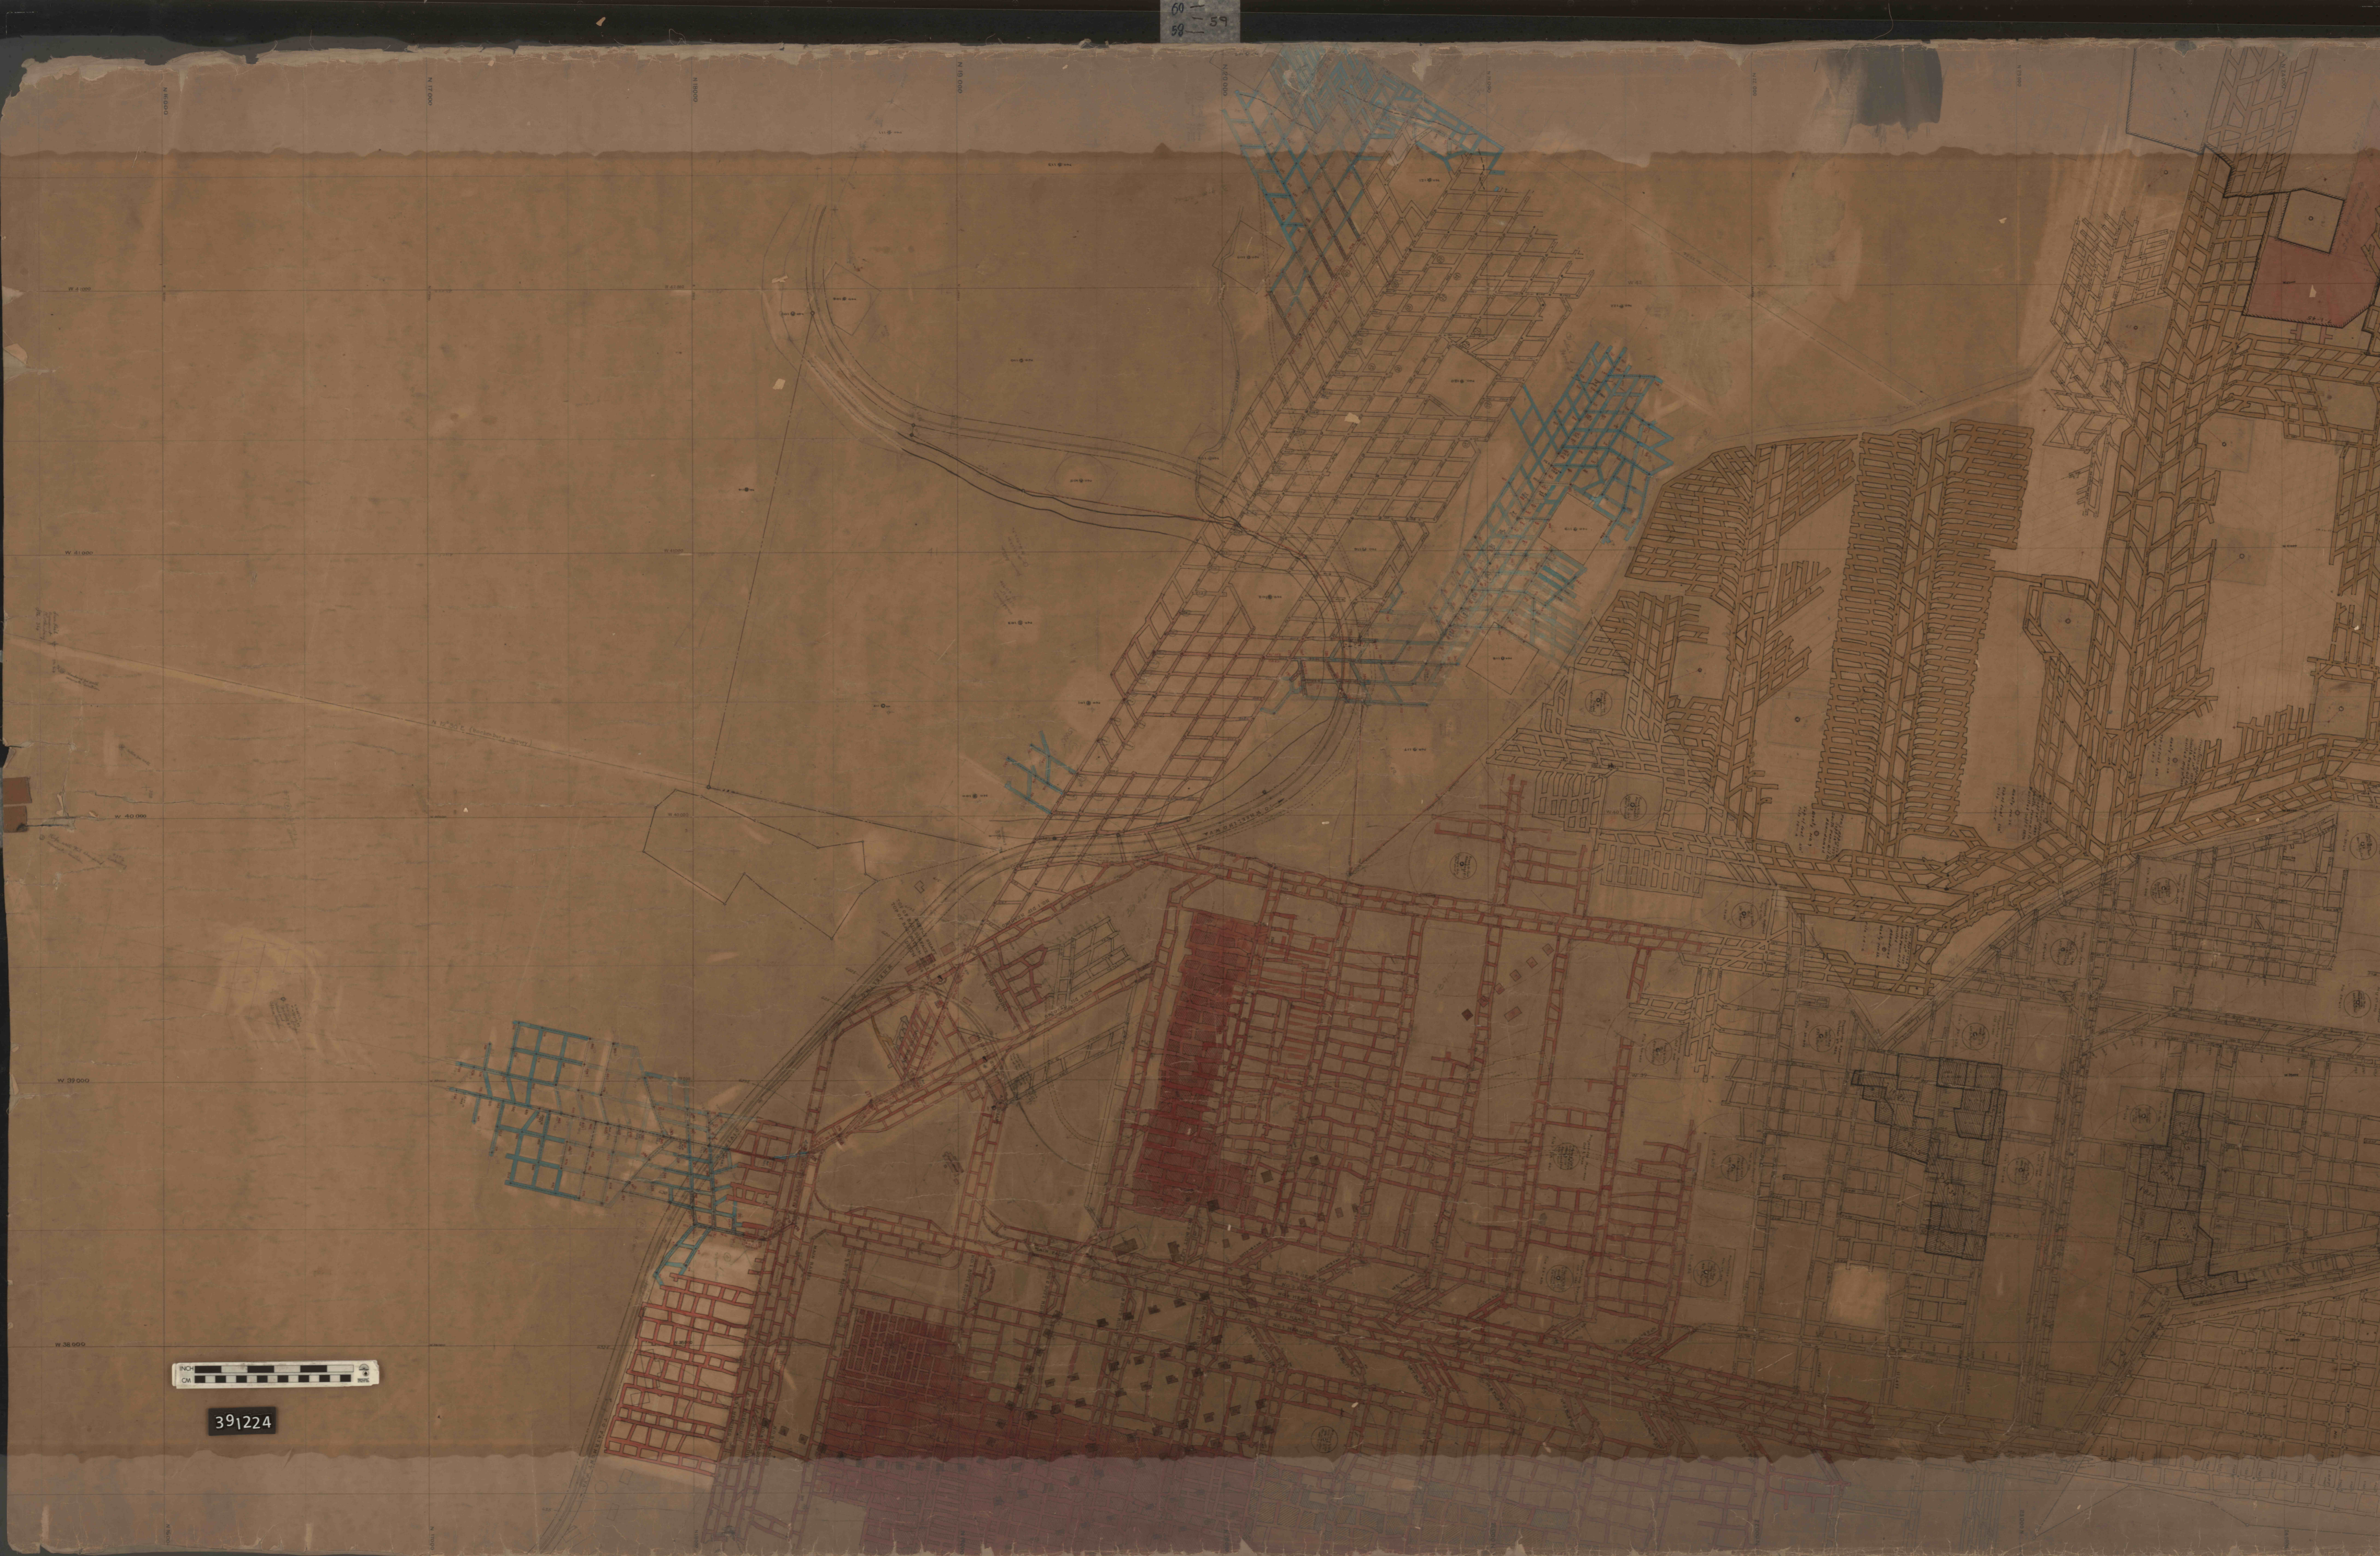

391224

58
59
60
61