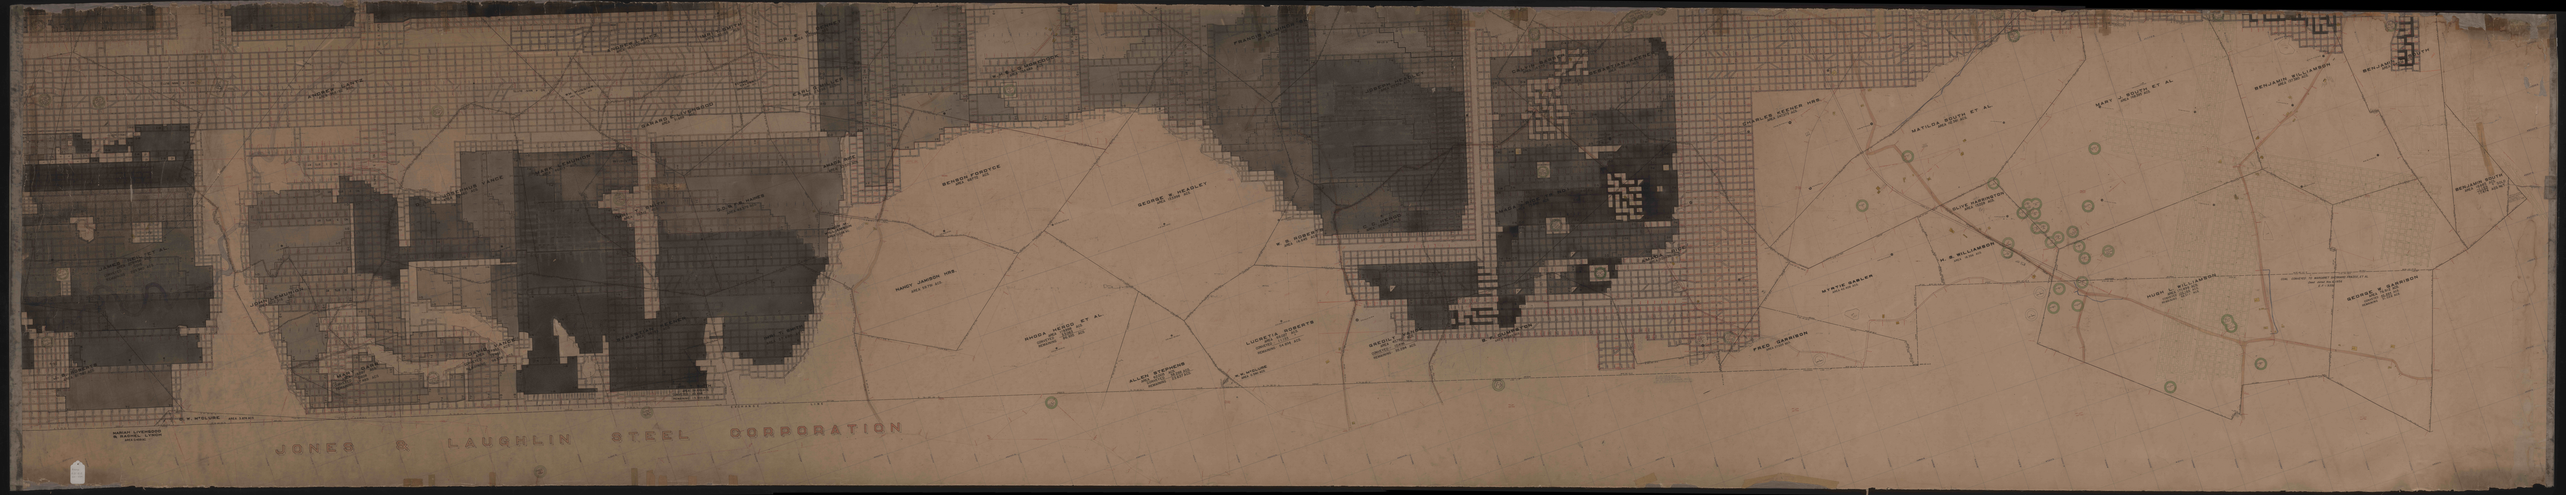
JONES & LAUGHLIN STEEL CORPORATION
ALLEN STEPHENS
LUCRETIA ROBERTS
FRED. HARRISON
HYATTE BARLEY
ELIZA JOHNSTON
W. R. WILLIAMSON
BENJAMIN WILLIAMSON
HUGH W. WILLIAMSON
GEORGE W. HARRISON