
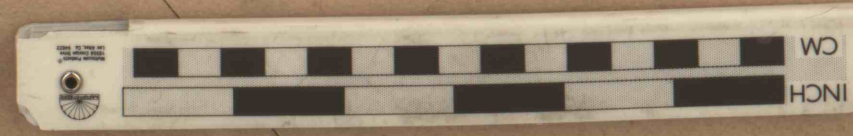


60-60  
60-59

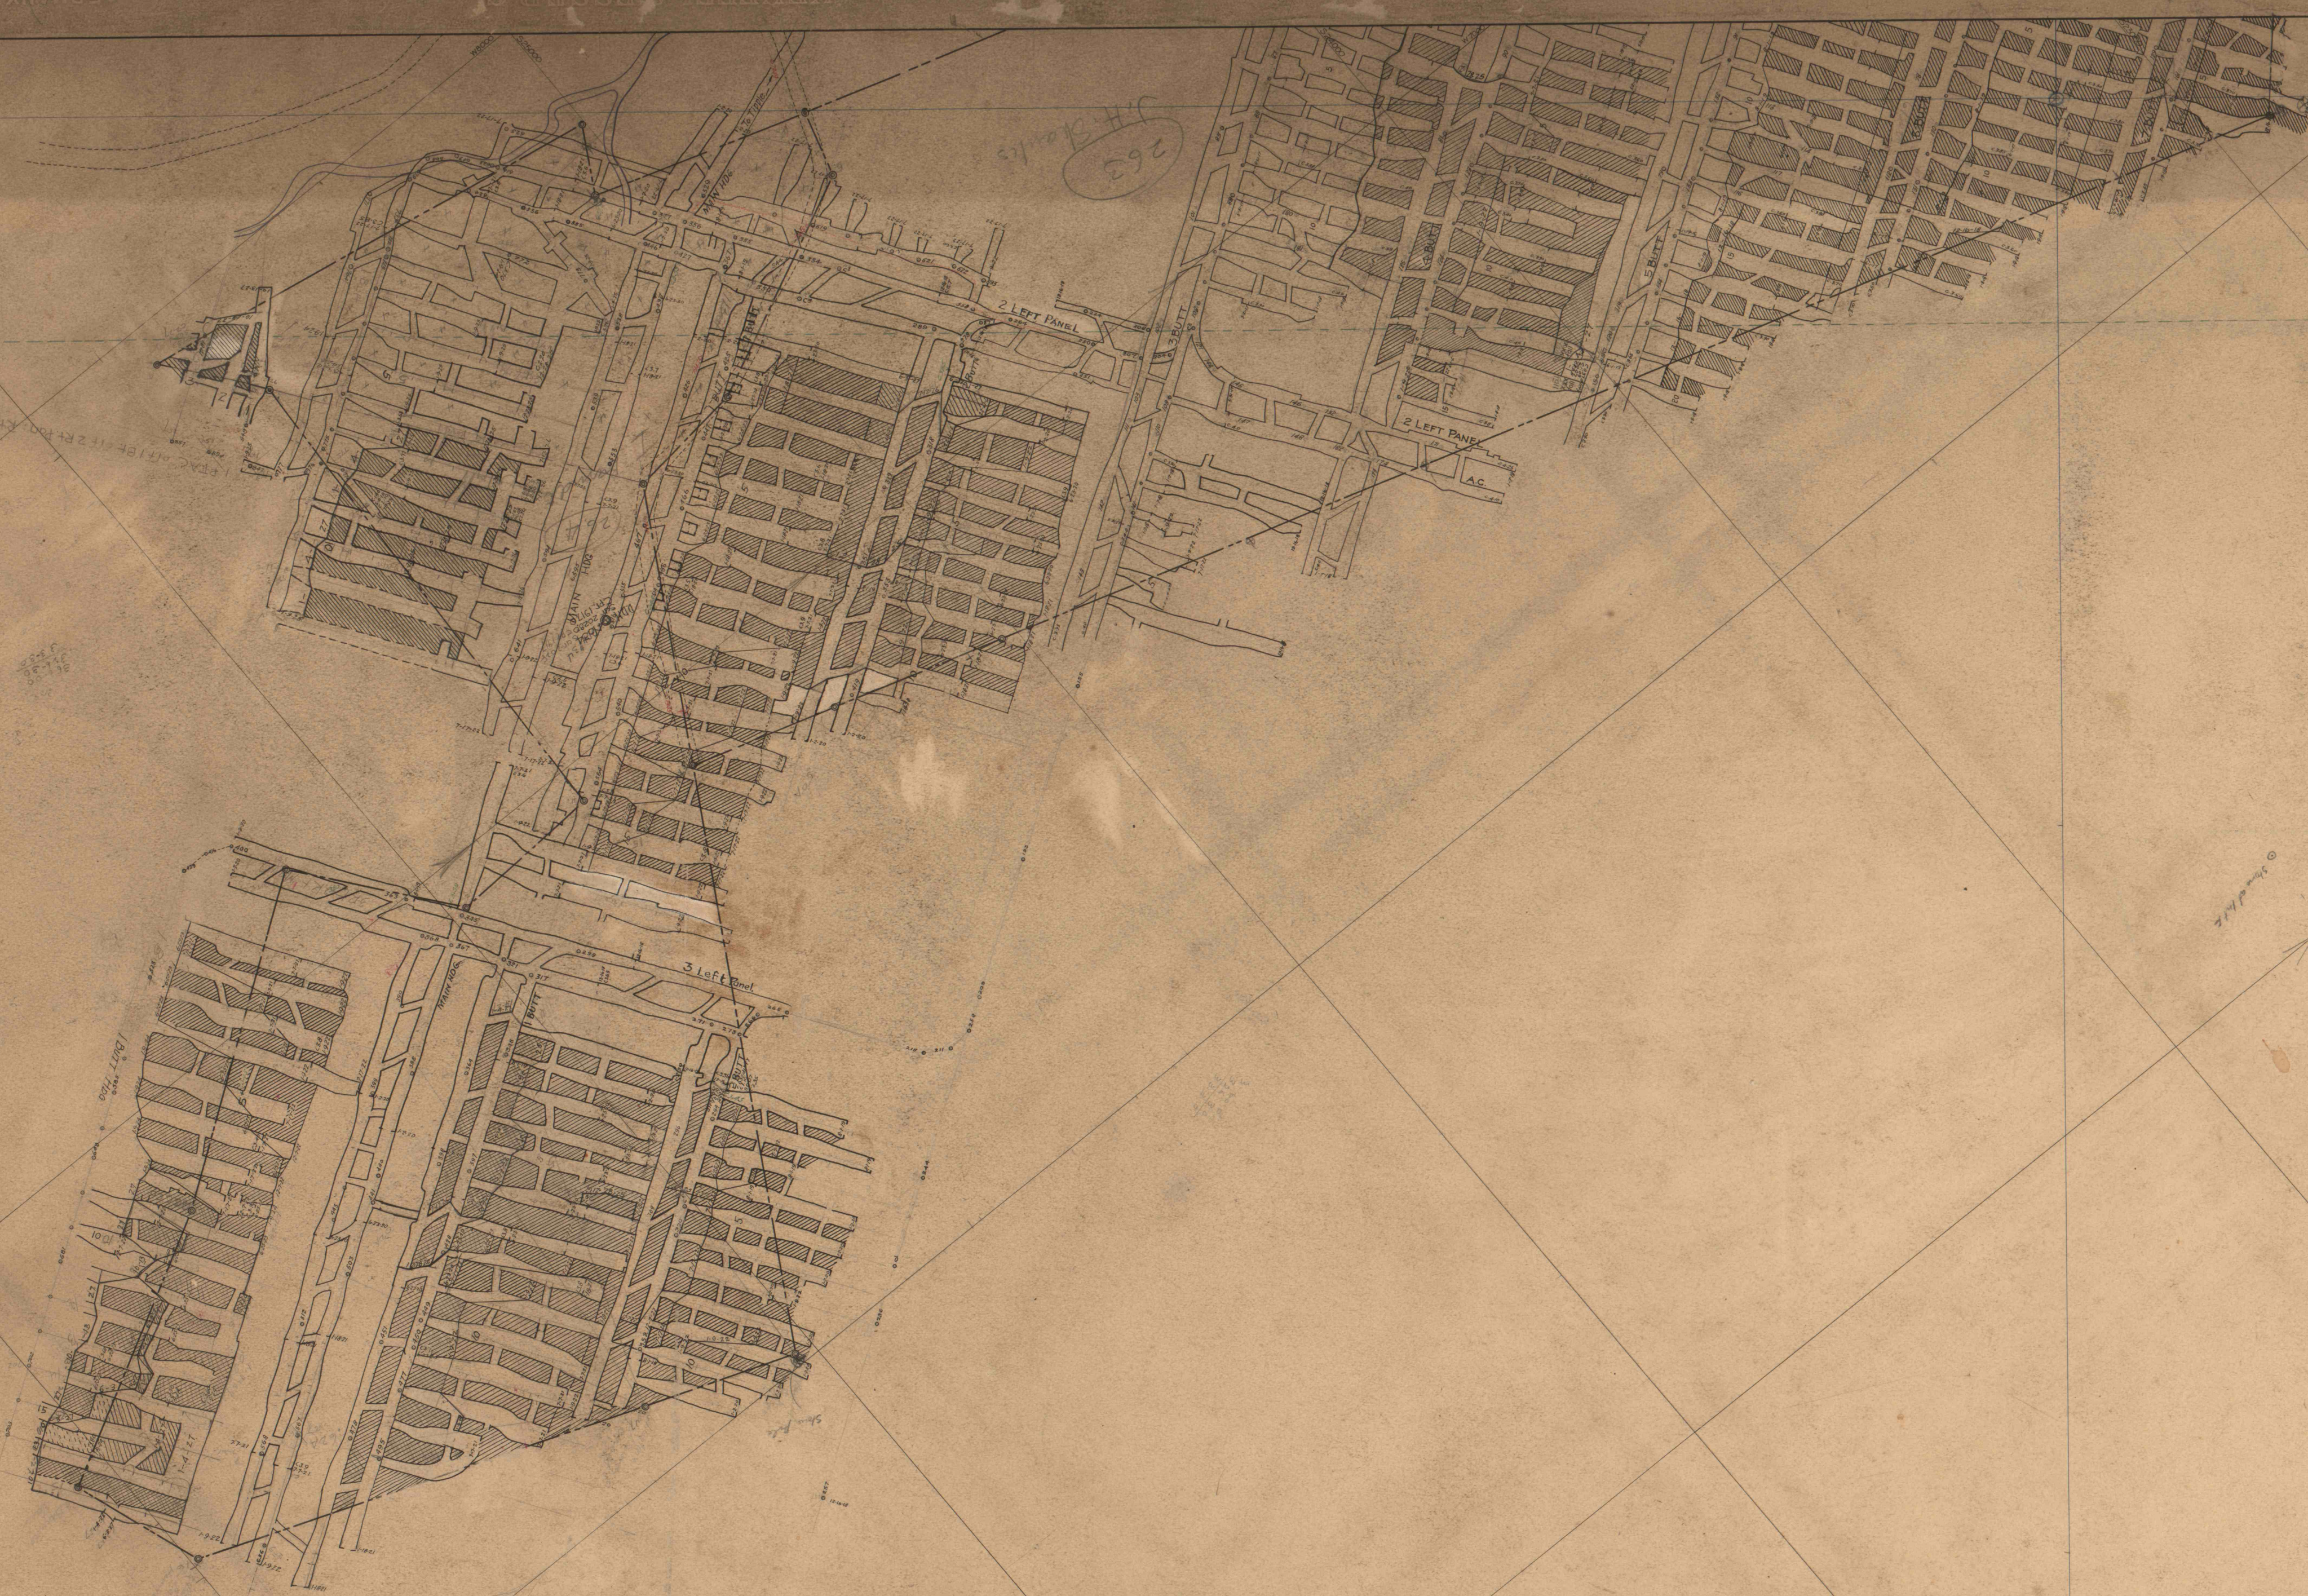

60-59  
60-11