
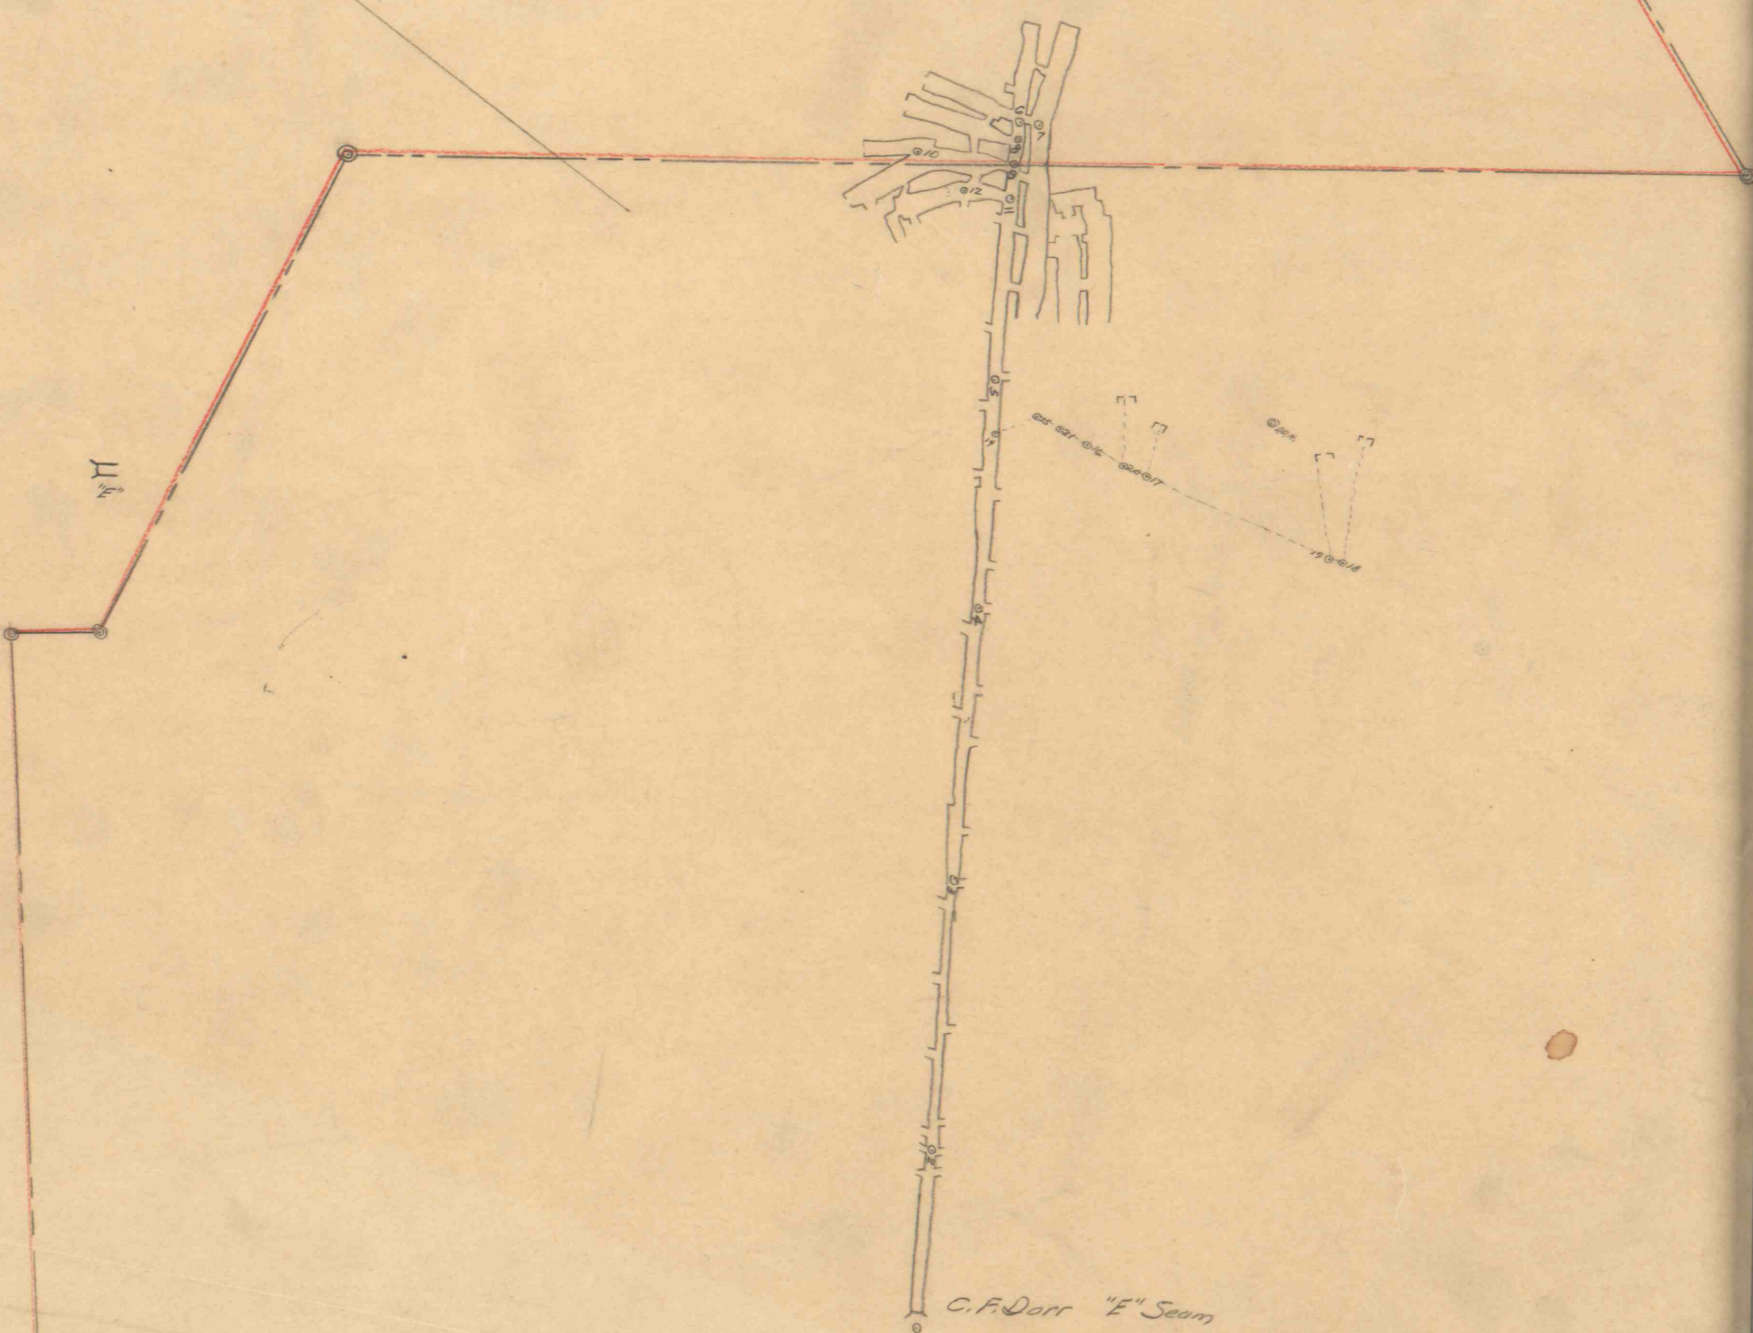


G. C. Co.  
Sold to C.F. Darr

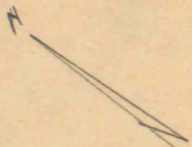

II  
"Cor"  
II

C.F. Darr "E" Seam

PLAT  
3/16" THICK  
BLANK  
2" X 36"  
1006  
100594443703