


60-61  
58-59

60 58 56  
59 57 55

60-61  
58-59

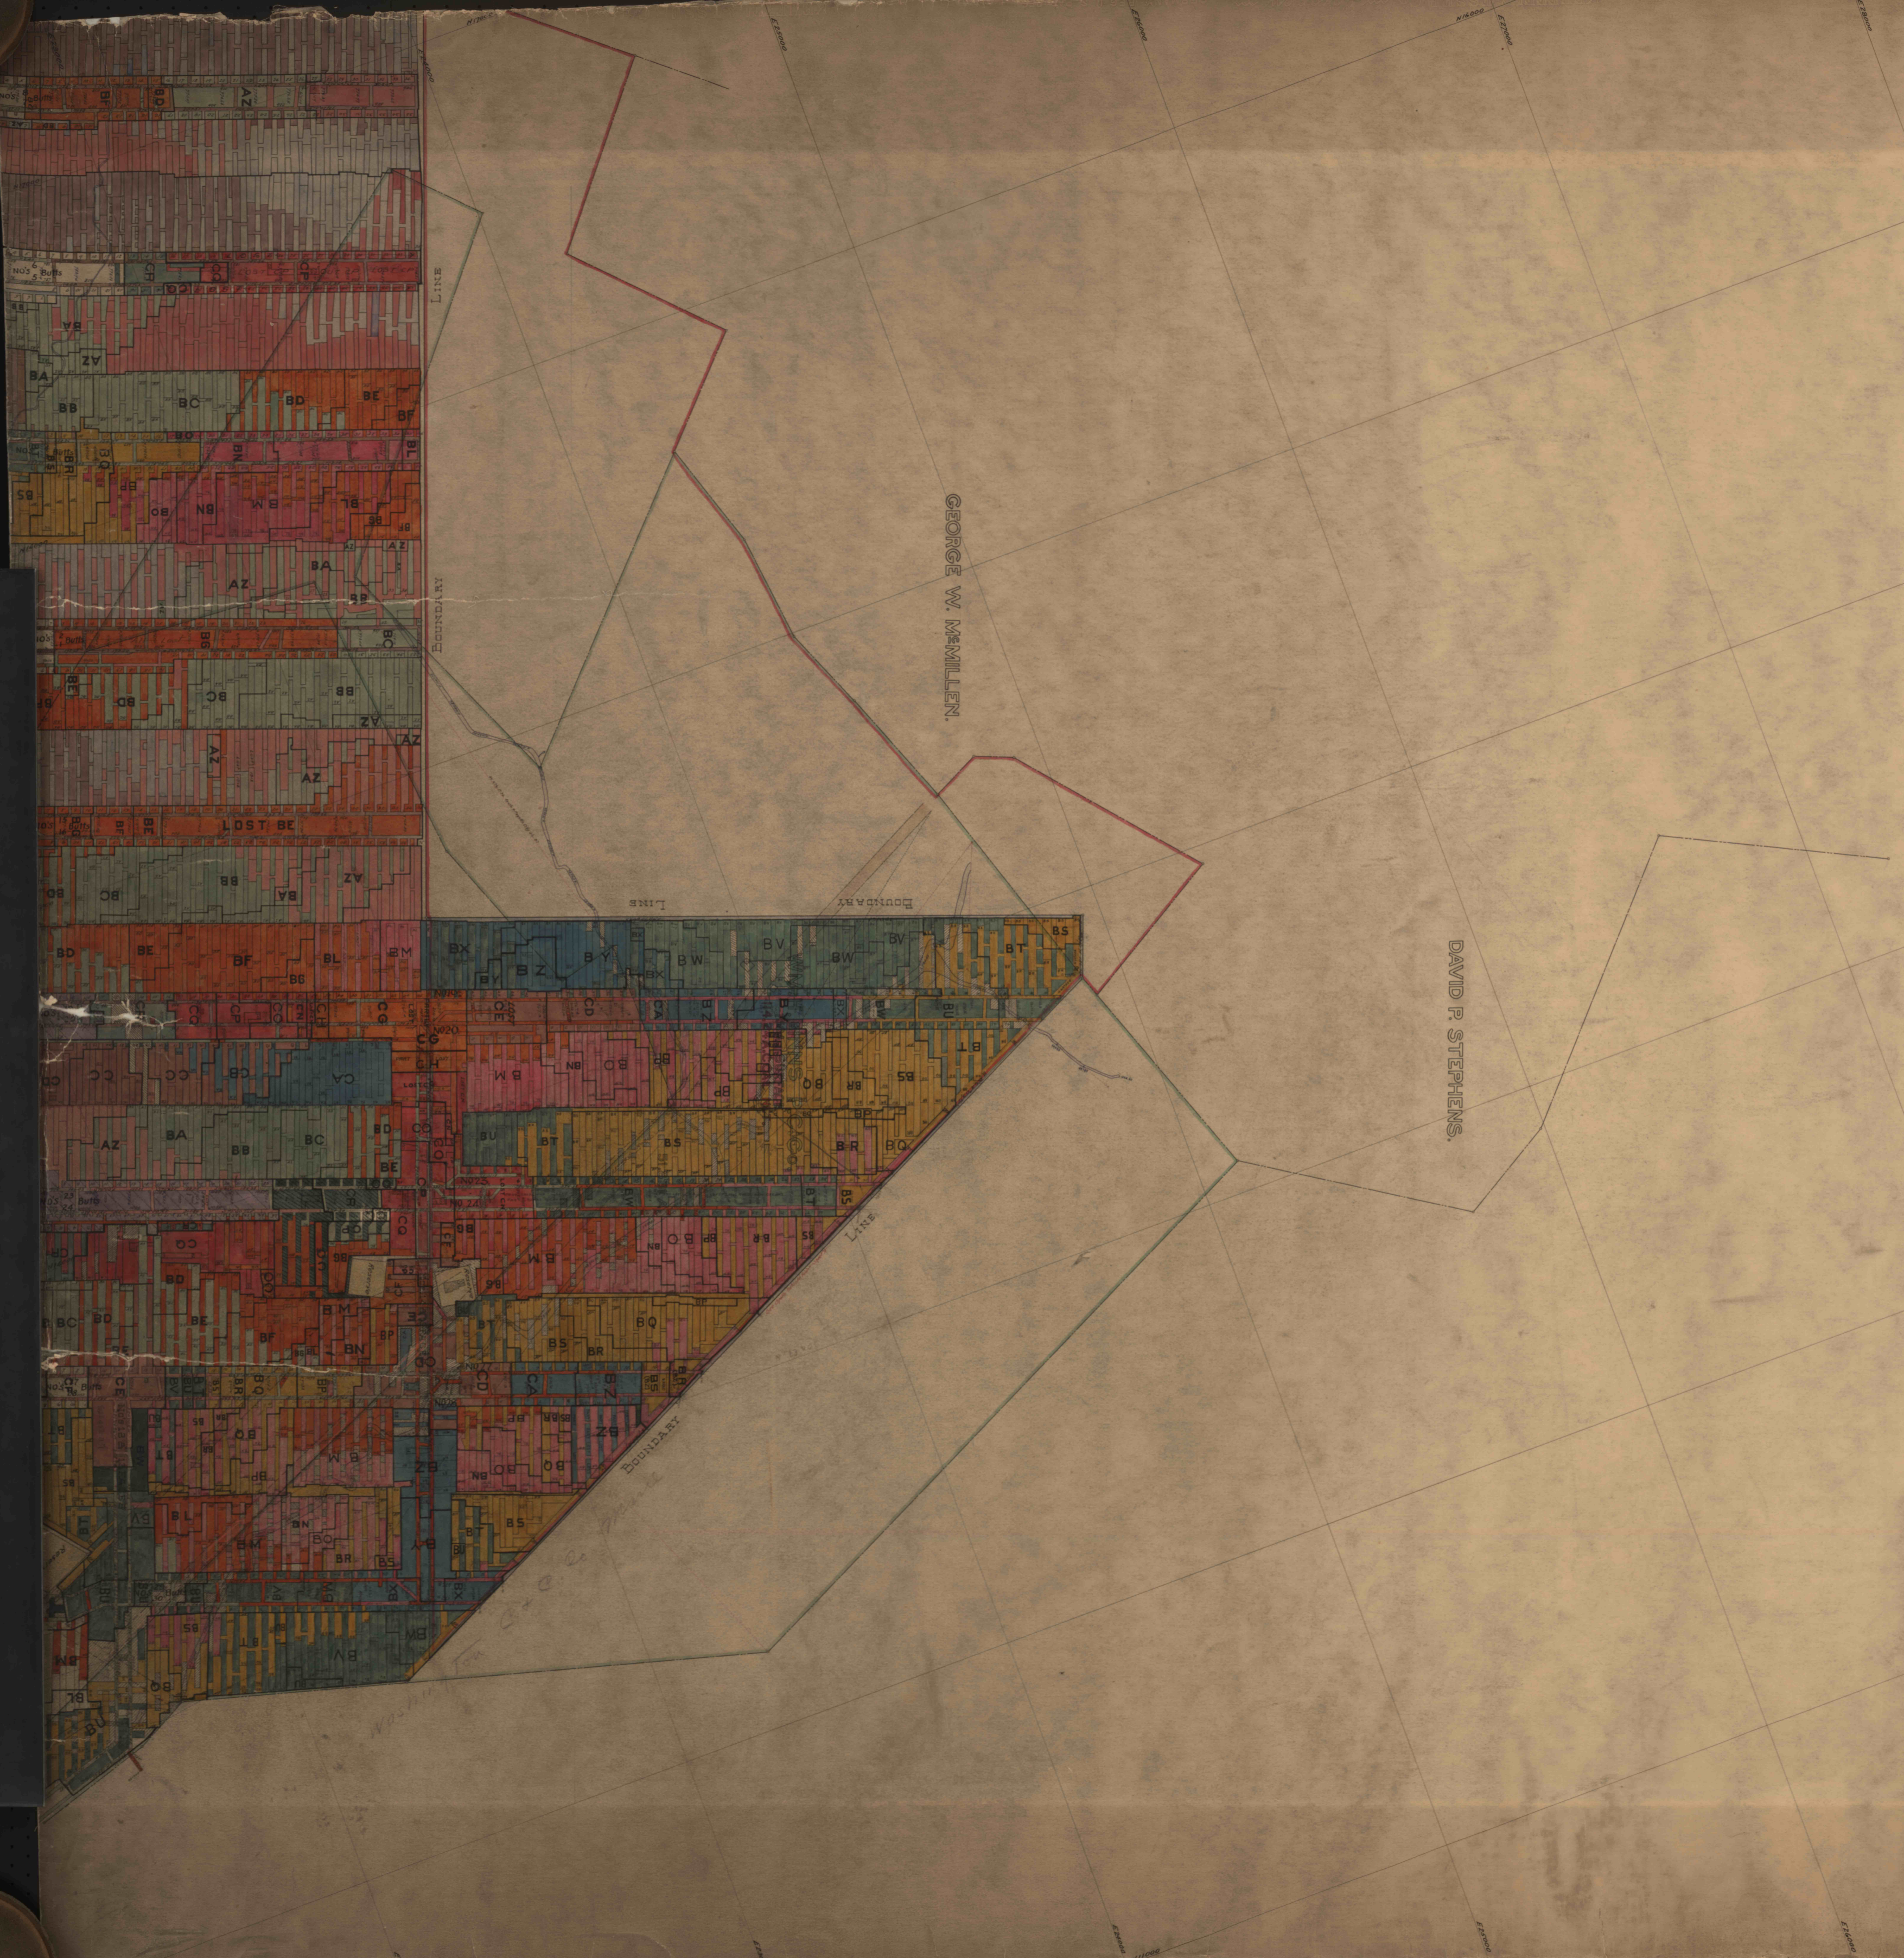

GEORGE W. MCMILLEN.

DAVID P STEPHENS.

BOUNDARY LINE

BOUNDARY LINE

BOUNDARY LINE

LINE