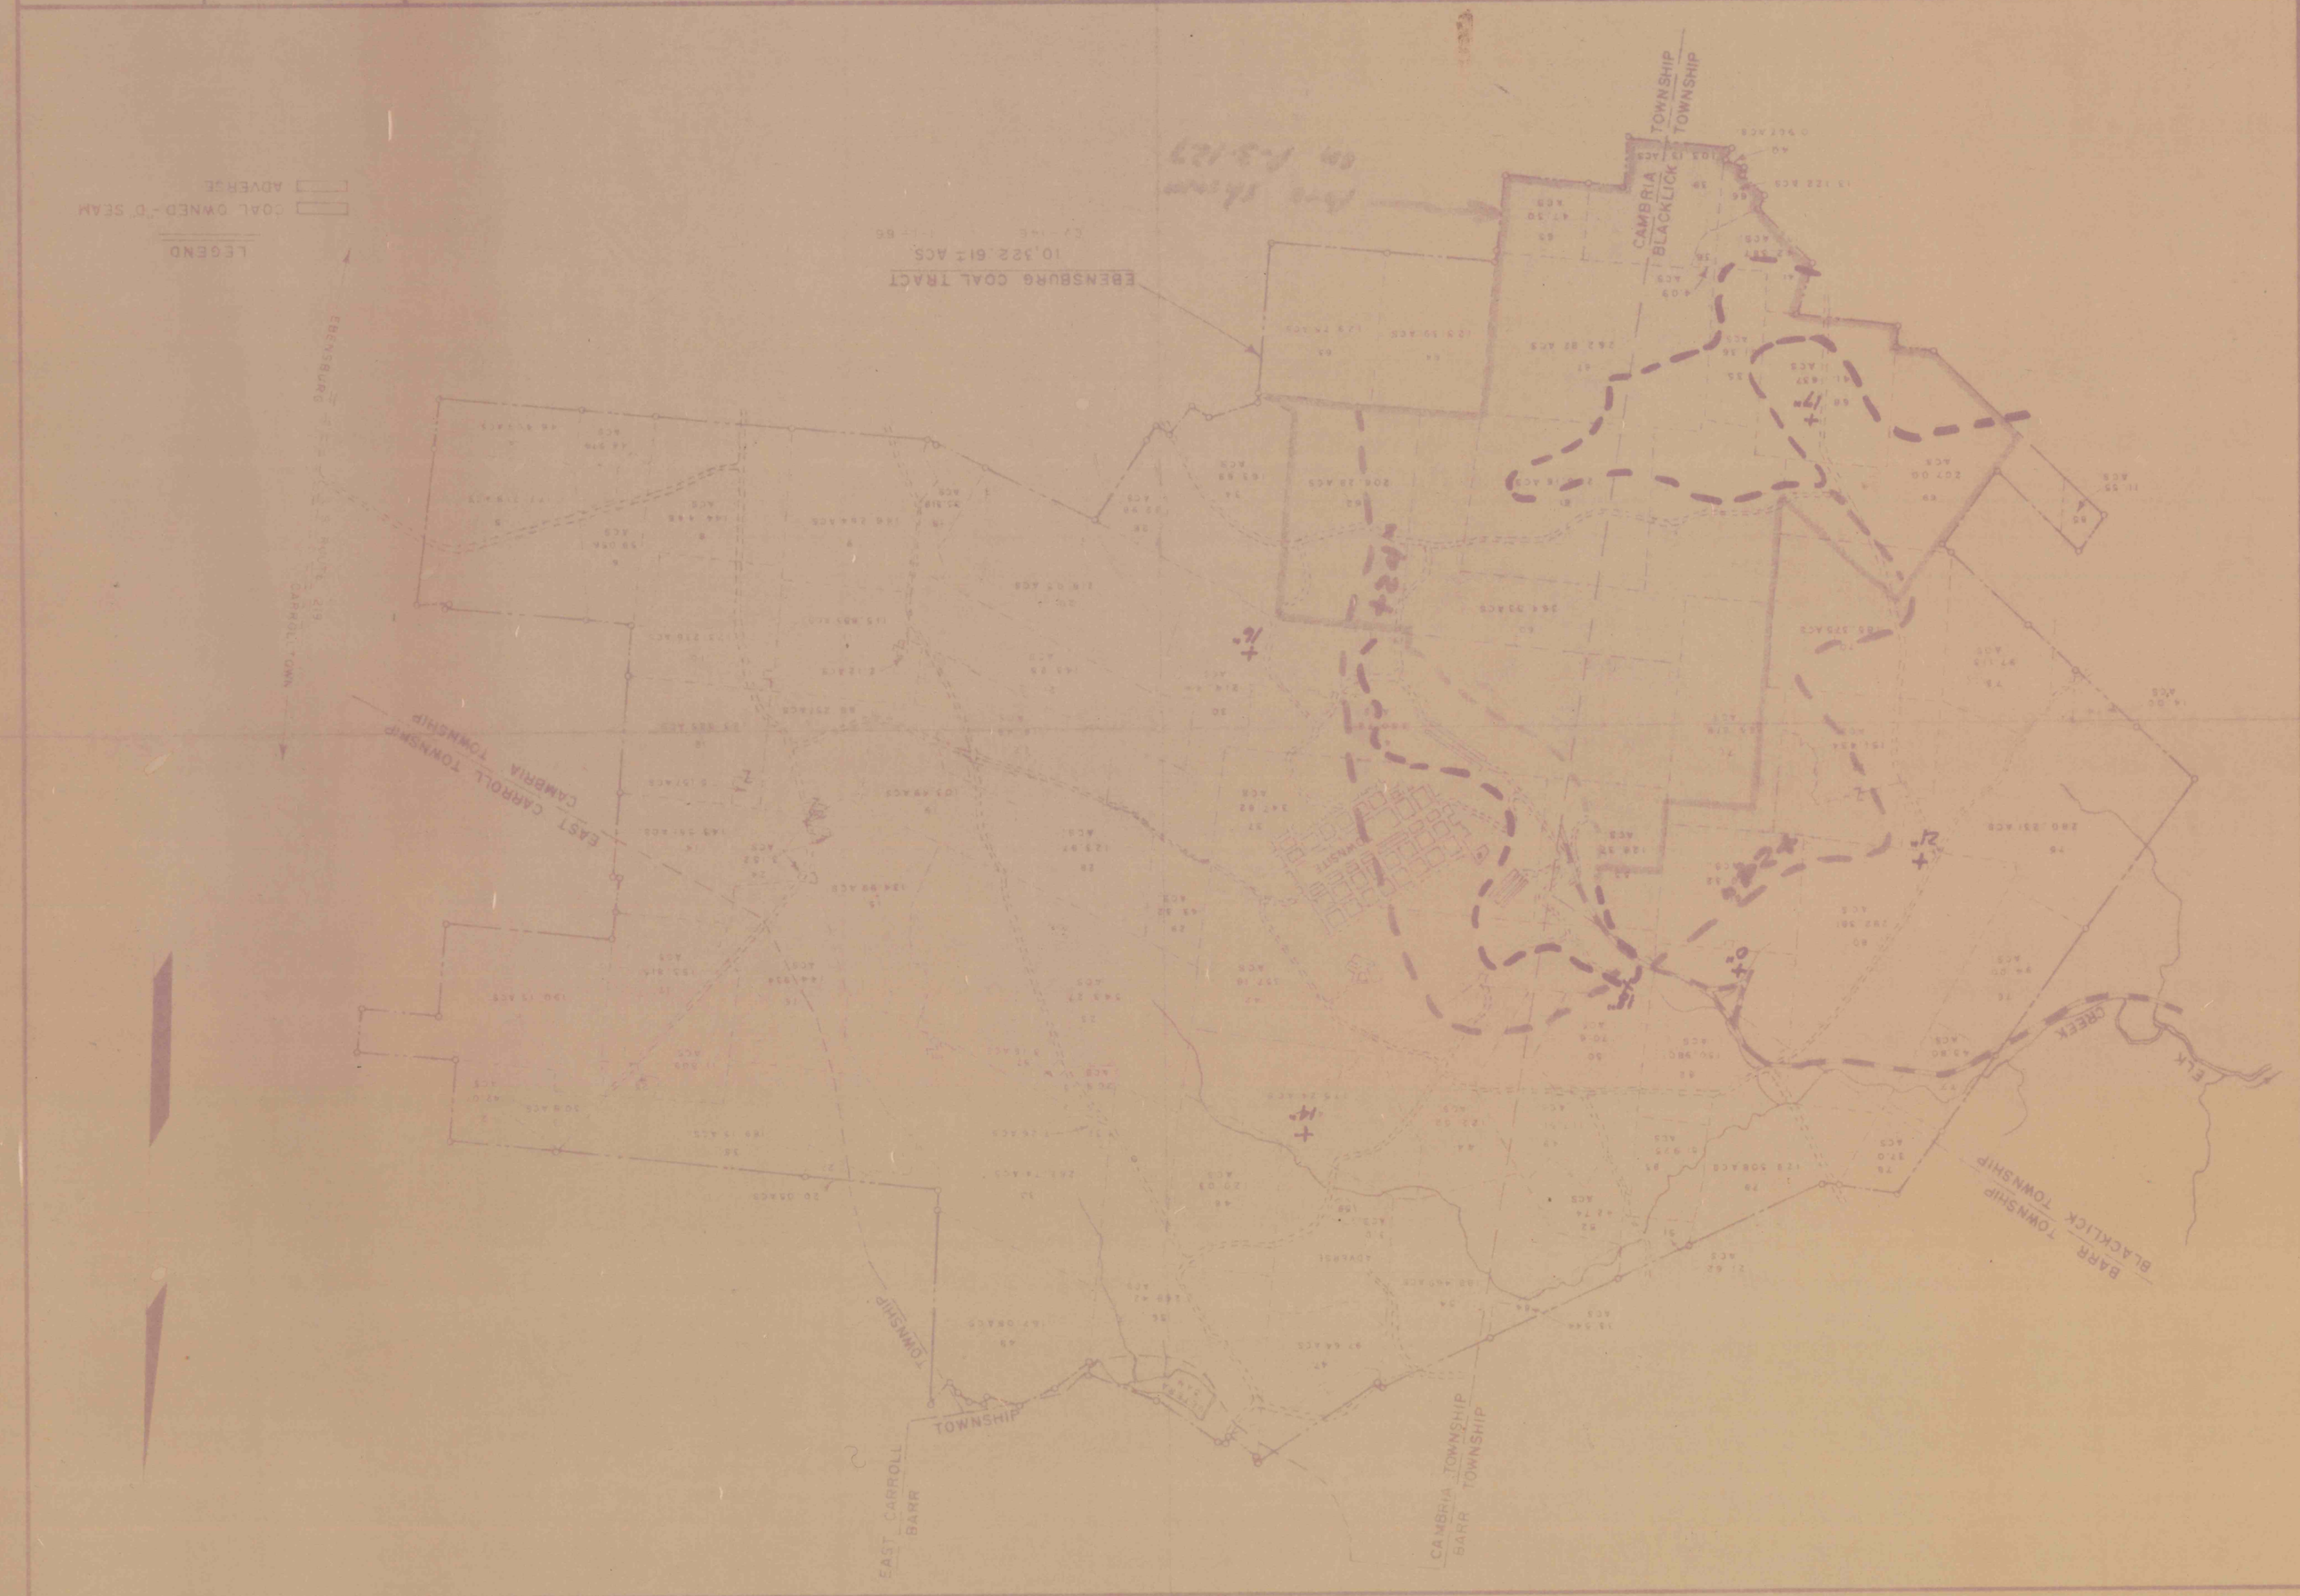REFERENCES	DWG. NO.	REVISED	DRAWN BY	NAME	DATE	EASTERN ASSOCIATED COAL CORP. PITTSBURGH, PA	COLVER MINE	"D" SEAM PROPERTY MAP	P-3-128
				W W H	8-3-79		SCALE 1"=2000'	B. M. NO.