
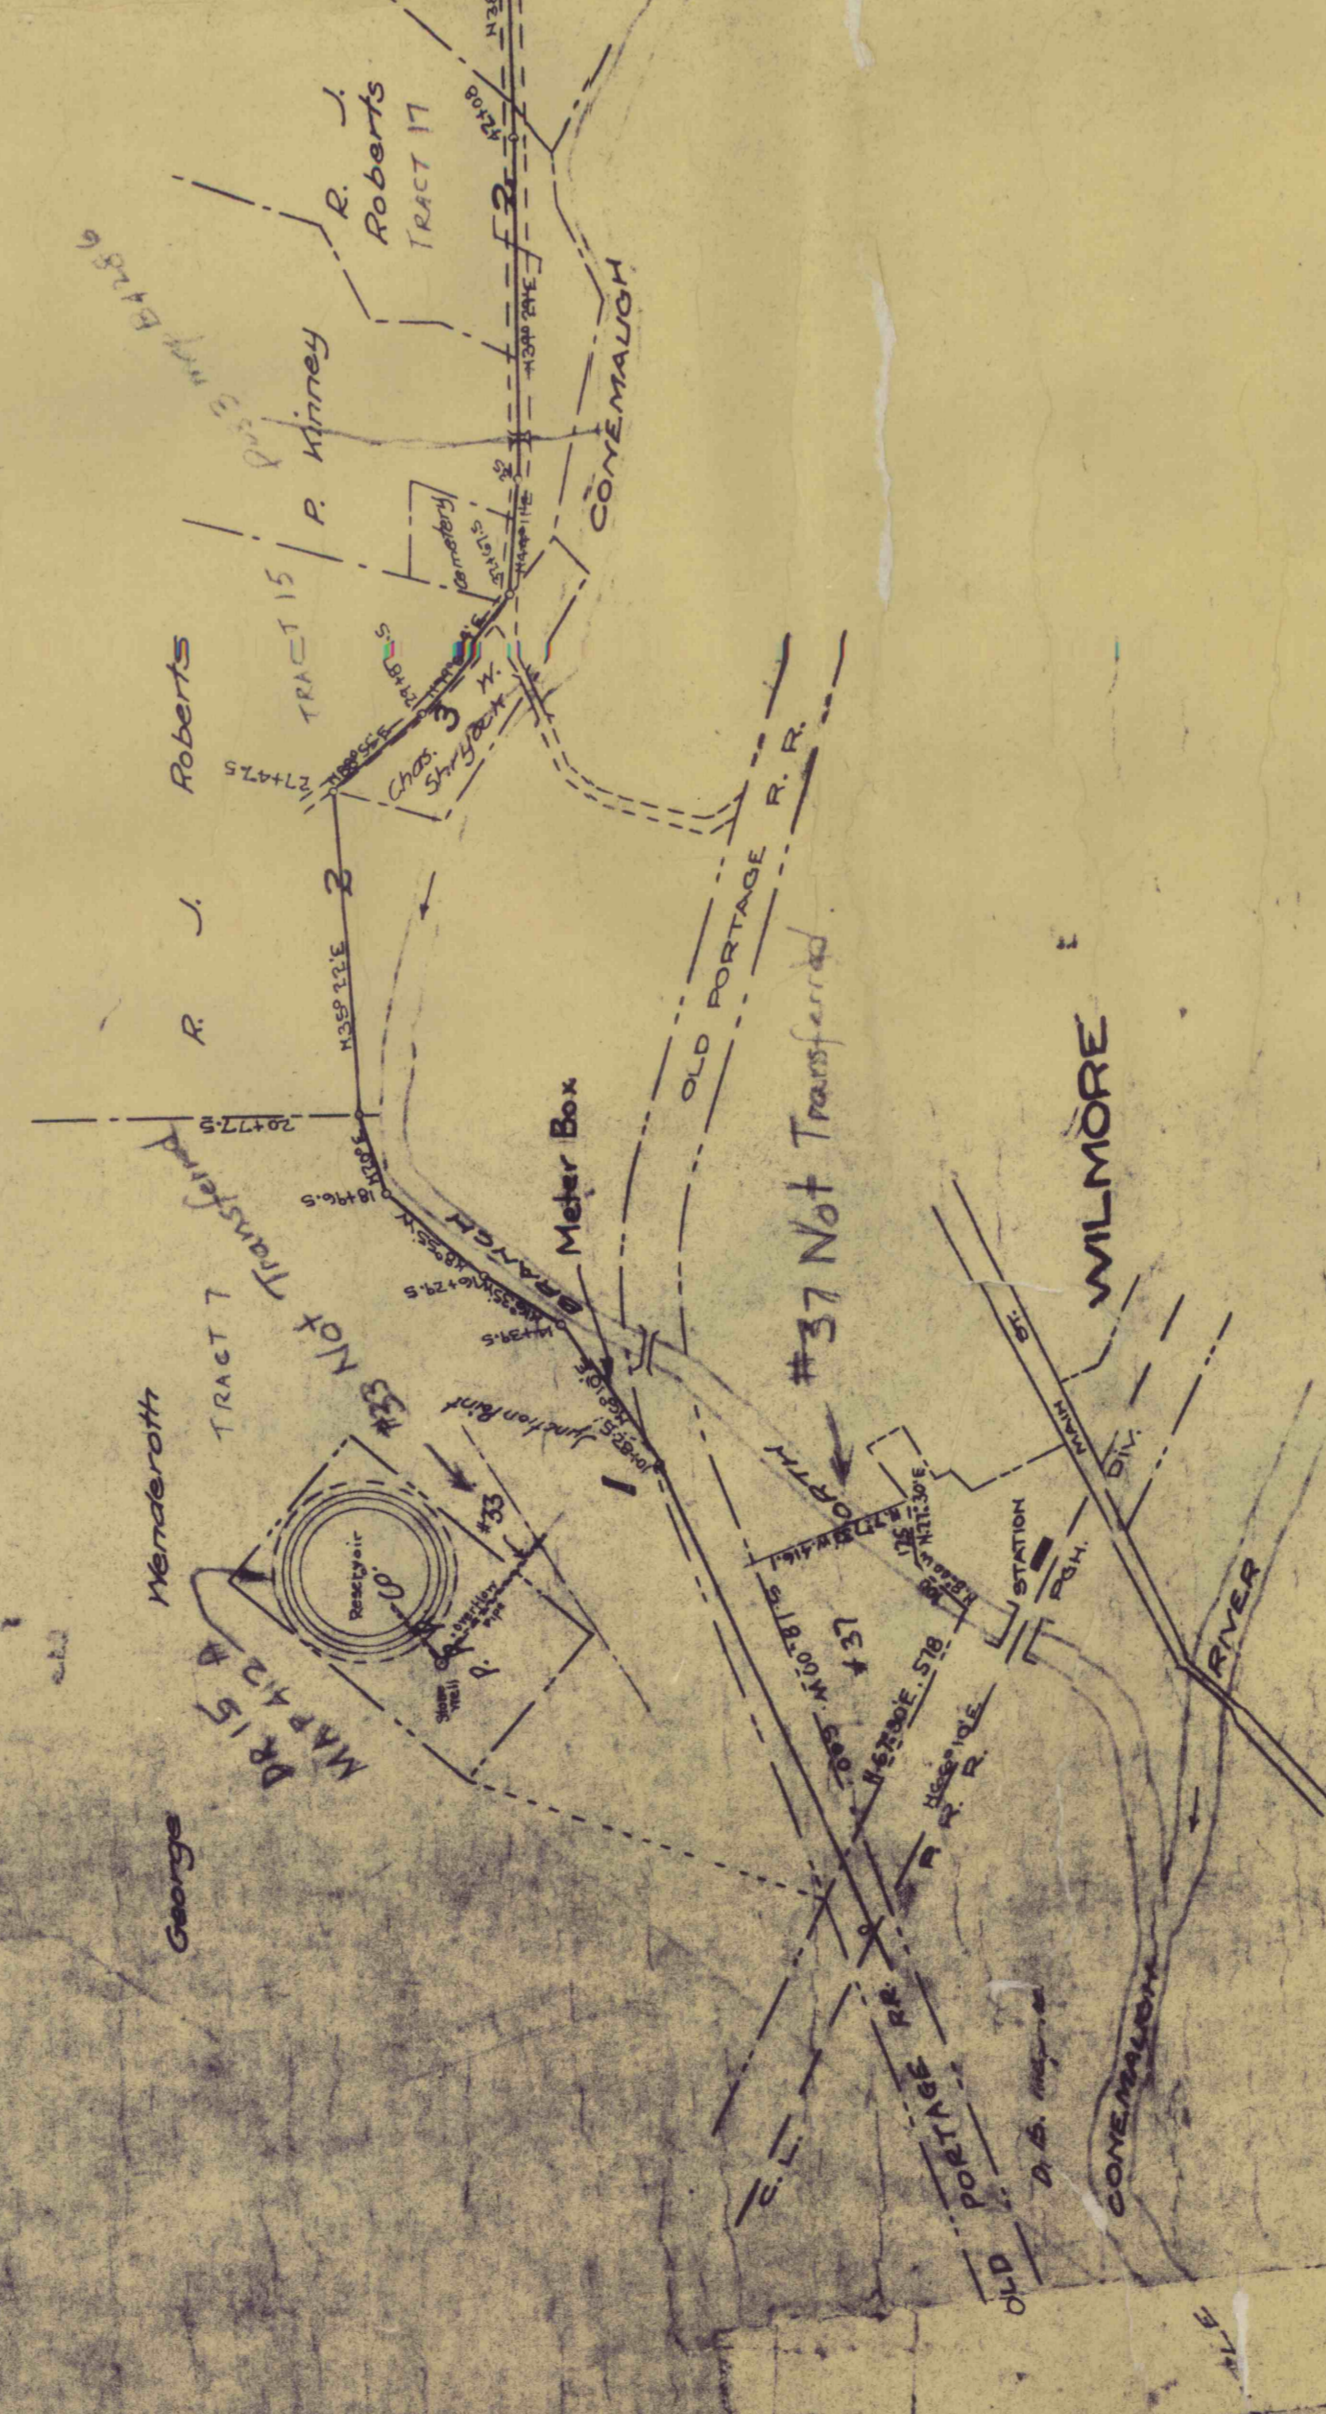


57304  
29706  
106470

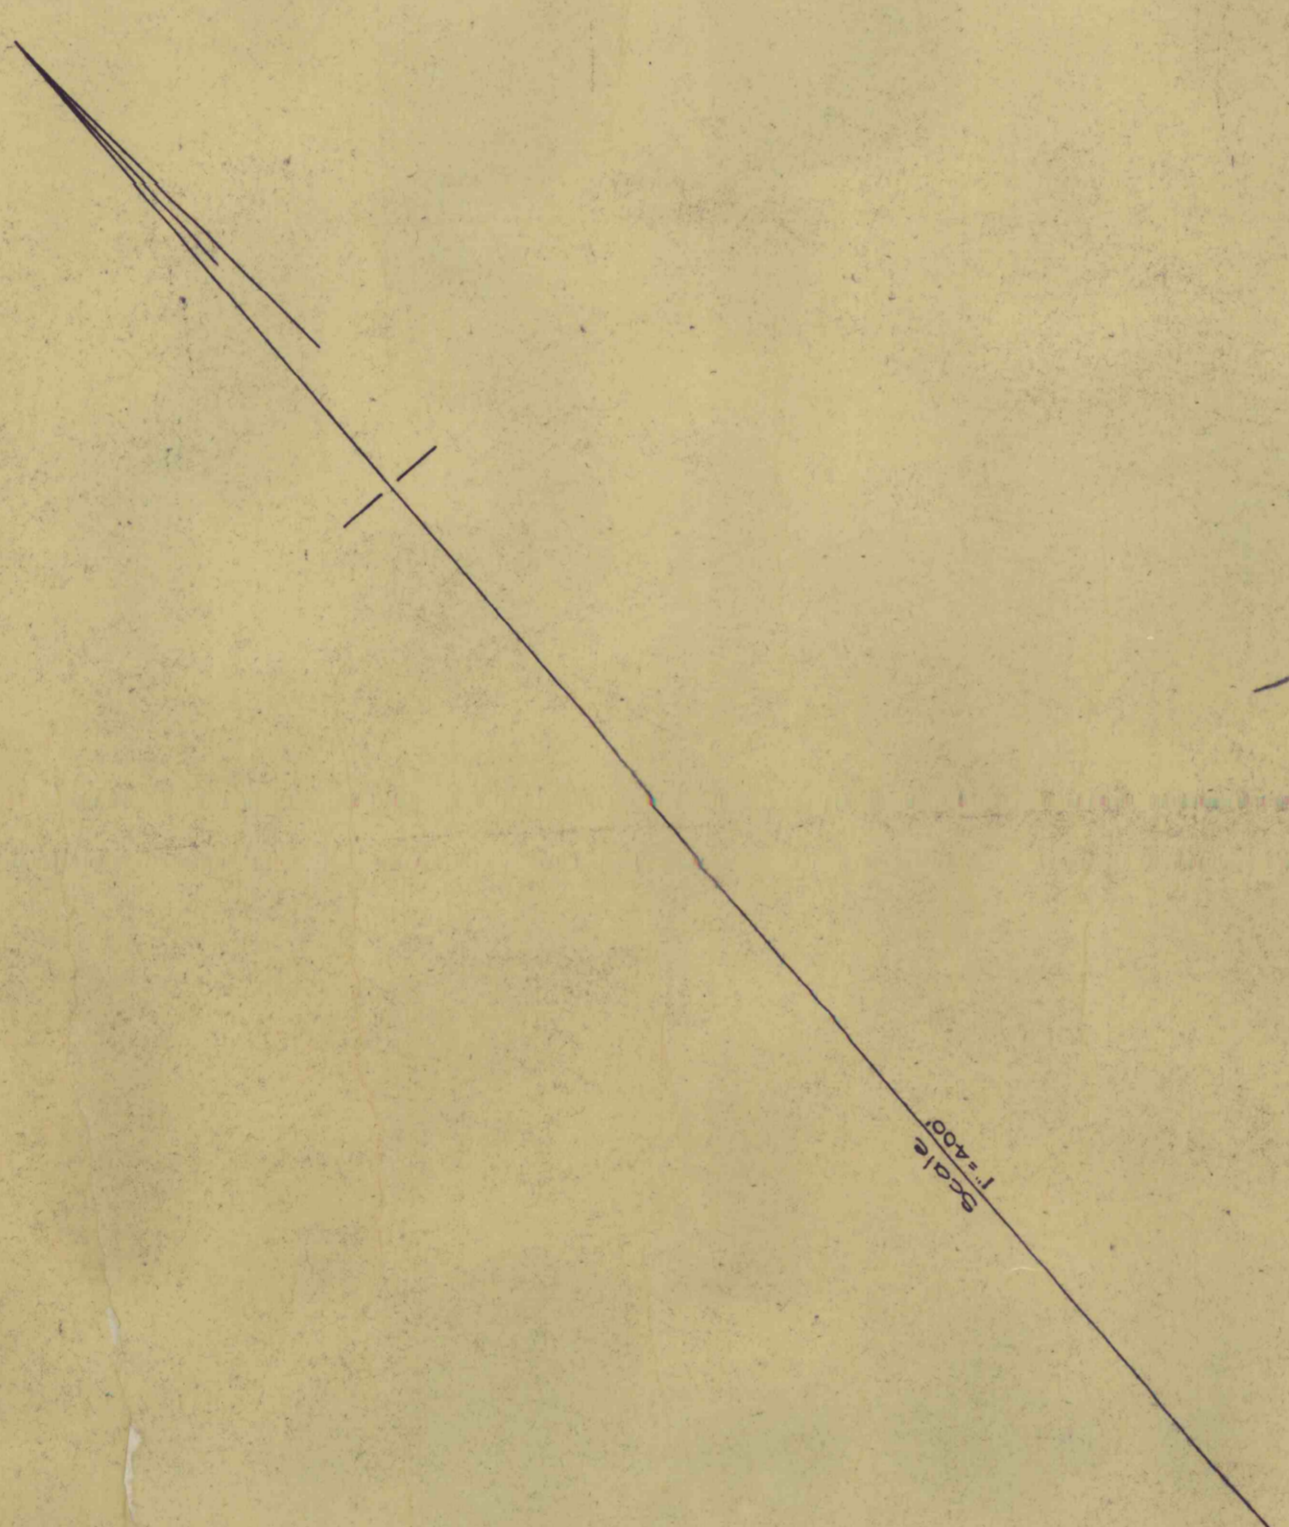

SUMMIT WATER SUPPLY CO.

See other tracing for Girardale Water Co.

B-2263