


JOHN HOLLEN

E. SHOEMAKER

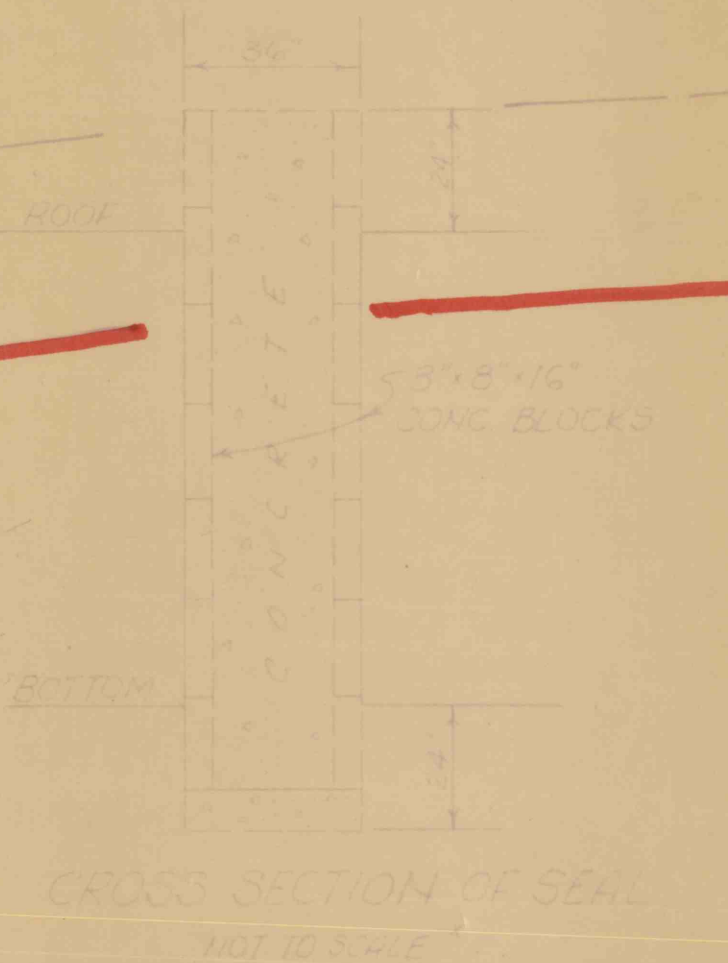

ANNIE POWELL

ANNIE

POWELL

Fee

G R C

G R C

COAL

CO.

CO.

NOW

STATE GAME LANDS

Nº 108

READE MINING CO., INC.

READE Nº 1 MINE

READE TWP, CAMBRIA CO., PA.

SCALE: 1"=200'

PLANS PREPARED BY WALTER W. GWIN, DODSON & SHAW CONSULTING ENGINEERS



122

REVISIONS

MARCH 20, 1971

SEPT 26, 1971

MAR 22, 1972

SEPT 25, 1972

MAY 15, 1973

OCTOBER 11, 1973

SEPT 16, 1975

MARCH 15, 1976

SEPT 27, 1976

MARCH 21, 1977

MINING LIMITS DETERMINED BY FAULT

HIGHEST ELEV. REACHED 1900

PROPOSED TREATMENT FACILITIES

OLD STRIP MINE

OLD STRIP MINE

OLD STRIP MINE

OLD STRIP MINE E SEAM

OLD STRIP MINE E SEAM

D SEAM

DH3 faulted

DH7

DH1

DH4

DH5 faulted

DH2 faulted

DIPSEPT B SEAM

DEVELOP STRIP

RUN

POWELL

TS

HW B

HW C

HW D

HW BV

HW BV

