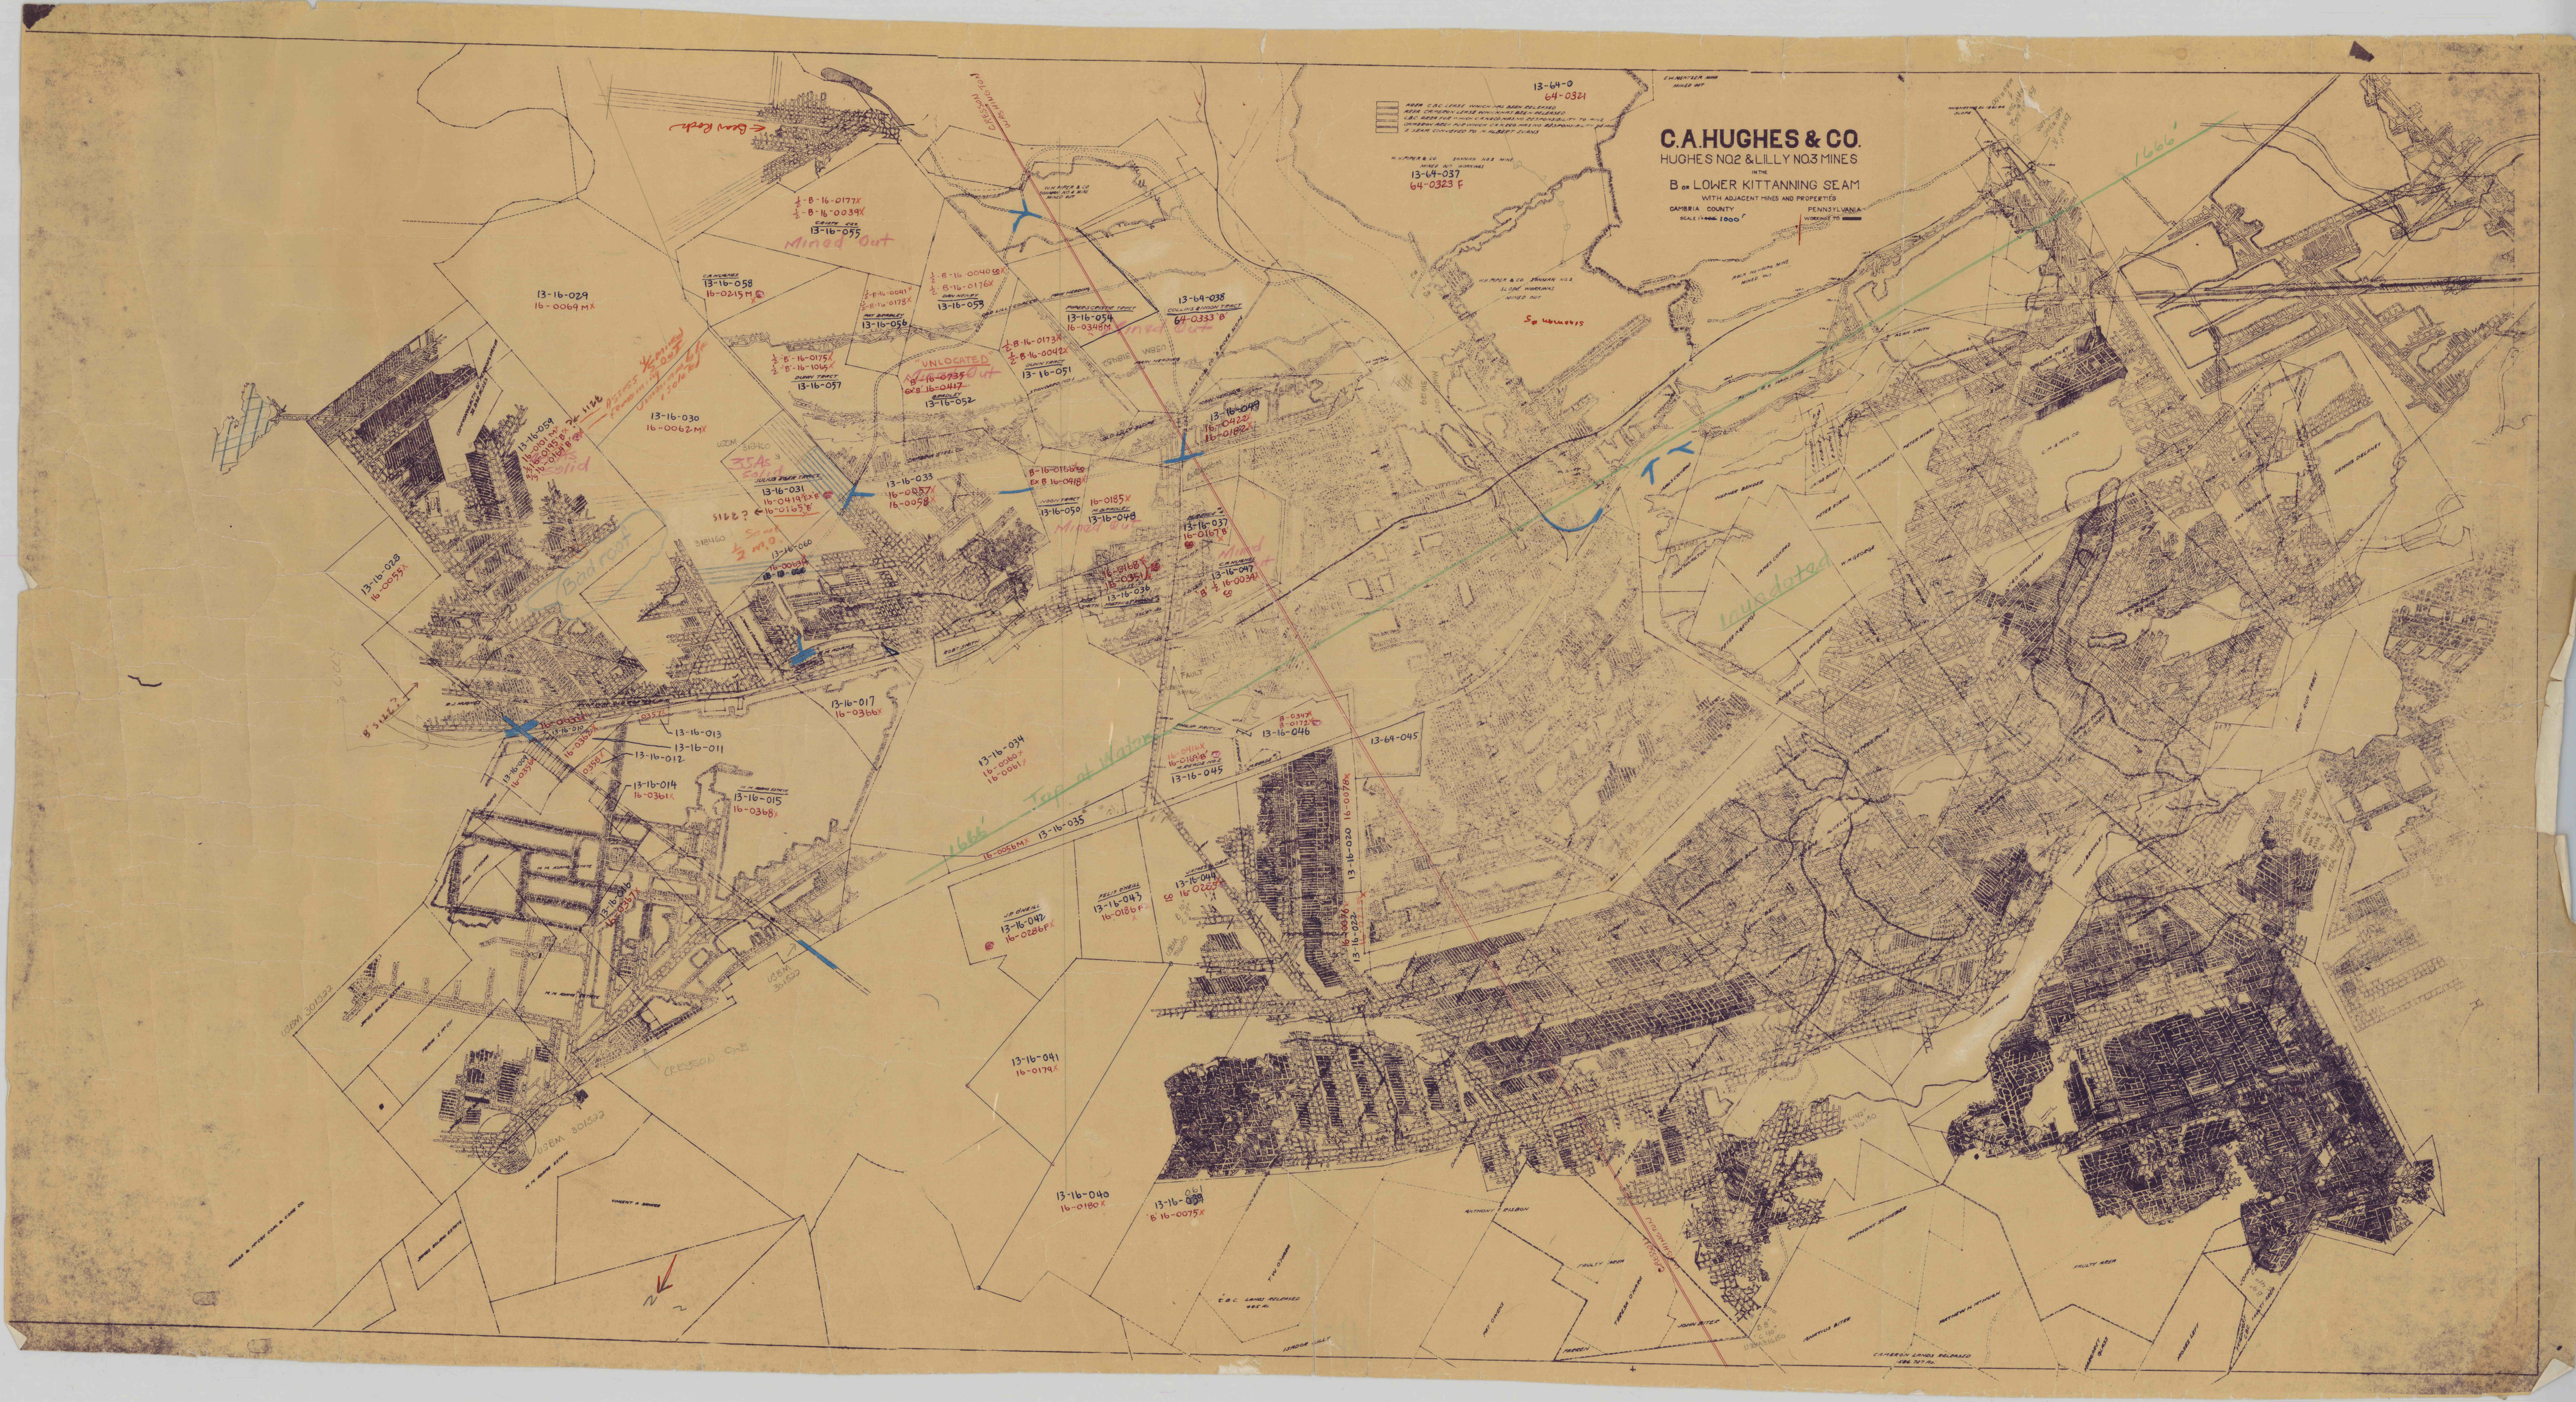
C.A. HUGHES & CO.
HUGHES NO2 & LILLY NO3 MINES
IN THE
B or LOWER KITTANNING SEAM
WITH ADJACENT MINES AND PROPERTIES
CAMBRIA COUNTY
PENNSYLVANIA
SCALE 1"=1000'
Mined Out
Unlocated
Barrier
Top of Water
1666'
13-16-029
16-0064 MX
13-16-030
16-0062 MX
13-16-028
16-0059 X
13-16-058
16-0219 M
13-16-055
13-16-056
13-16-057
13-16-052
13-16-053
13-16-054
16-0345 M
13-16-051
13-16-049
16-0422
16-0188 X
13-16-033
16-0057
16-0058
13-16-031
16-0419 X
16-0193 X
13-16-050
13-16-048
16-0185 X
13-16-037
16-0167 B
13-16-039
16-0351 X
13-16-097
16-0034
13-16-017
16-0366 X
13-16-013
13-16-011
13-16-012
13-16-014
16-0361 X
13-16-015
16-0368 X
13-16-034
16-0067
16-0091 X
13-16-046
13-64-045
13-16-045
13-16-035
16-0065 MX
13-16-020
16-0178 X
13-16-044
16-0223
13-16-043
16-0186 X
13-16-042
16-0286 X
13-16-041
16-0179 X
13-16-040
16-0180 X
13-16-061
16-0075 X
13-64-0
64-0321
13-64-037
64-0323 F
13-64-038
64-0333 B
Sq 4644 0515
CAMBRIA LANDS RELEASED
186 NET AC.