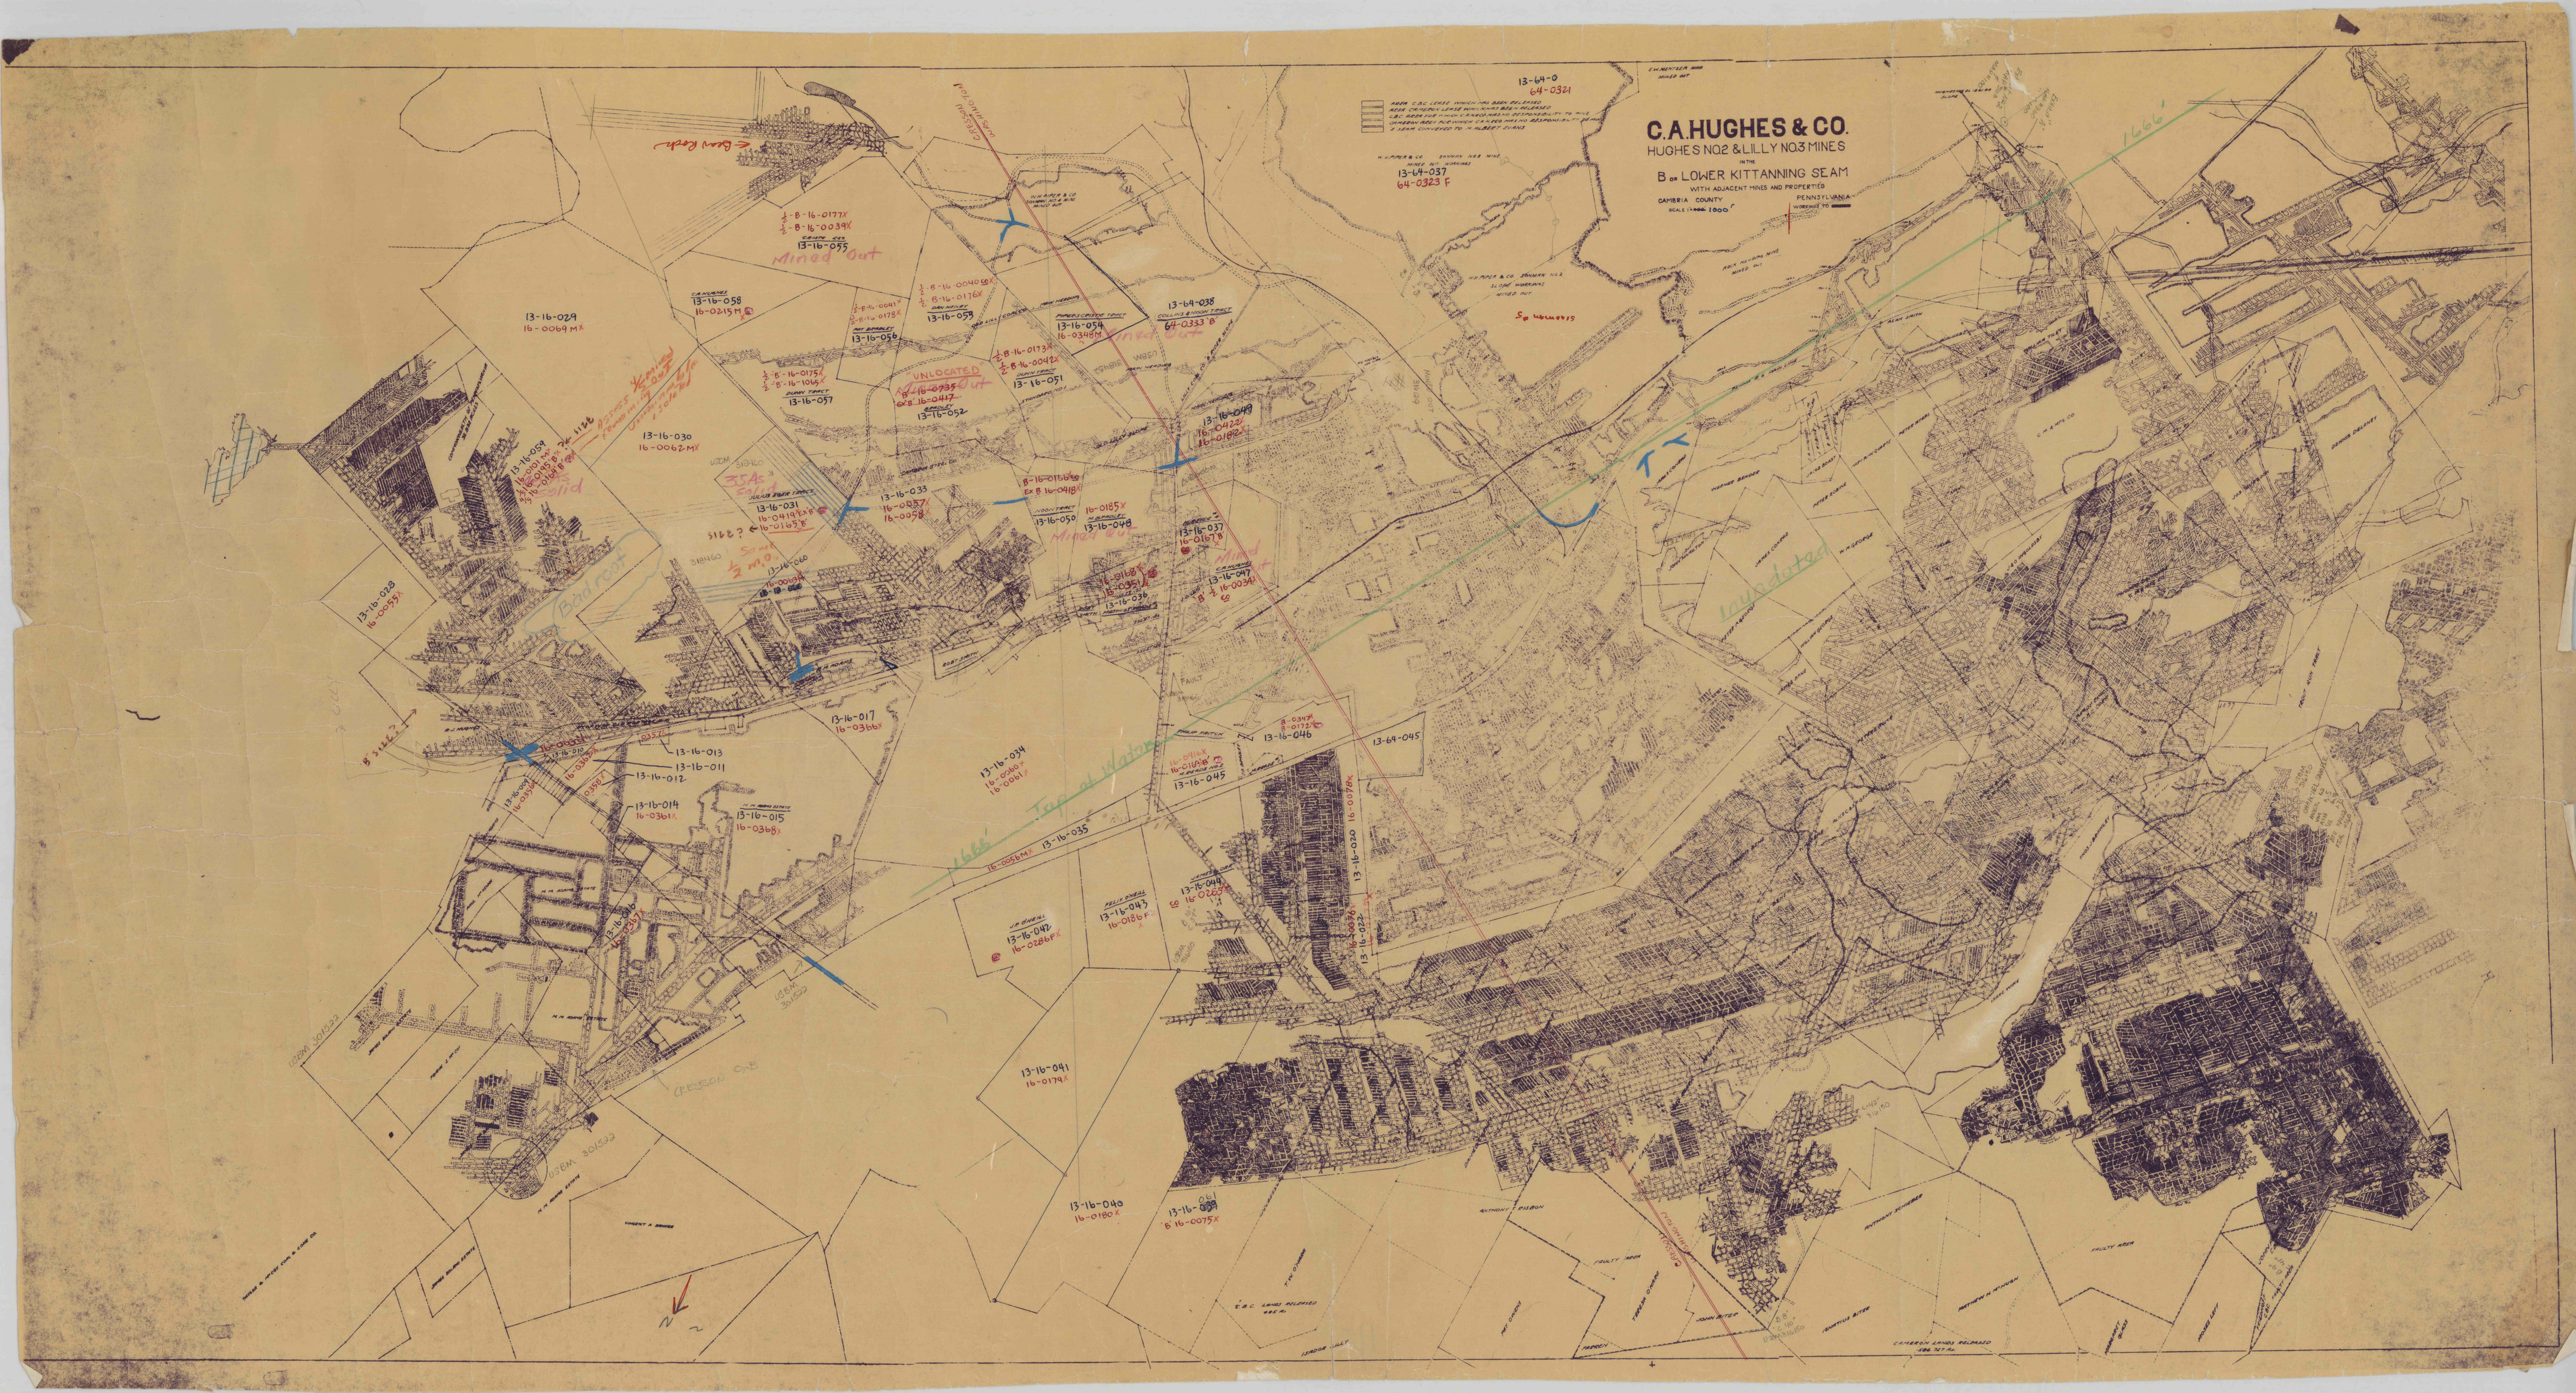
C.A. HUGHES & CO.
HUGHES NO2 & LILLY NO3 MINES
IN THE
B OR LOWER KITTANNING SEAM
WITH ADJACENT MINES AND PROPERTIES
CAMBRIA COUNTY
PENNSYLVANIA
SCALE 1" = 1000'
Mined Out
Flooded
Barrier
Top of Water
1666'
13-16-029
16-0069 M
13-16-030
16-0062 M
13-16-031
13-16-033
13-16-037
13-16-039
13-16-040
13-16-011
13-16-012
13-16-013
13-16-014
13-16-015
13-16-017
13-16-020
13-16-022
13-16-034
13-16-035
13-16-036
13-16-038
13-16-040
13-16-041
13-64-045
13-64-0
64-0321
13-64-037
64-0323 F
13-64-038
64-0333 B