


















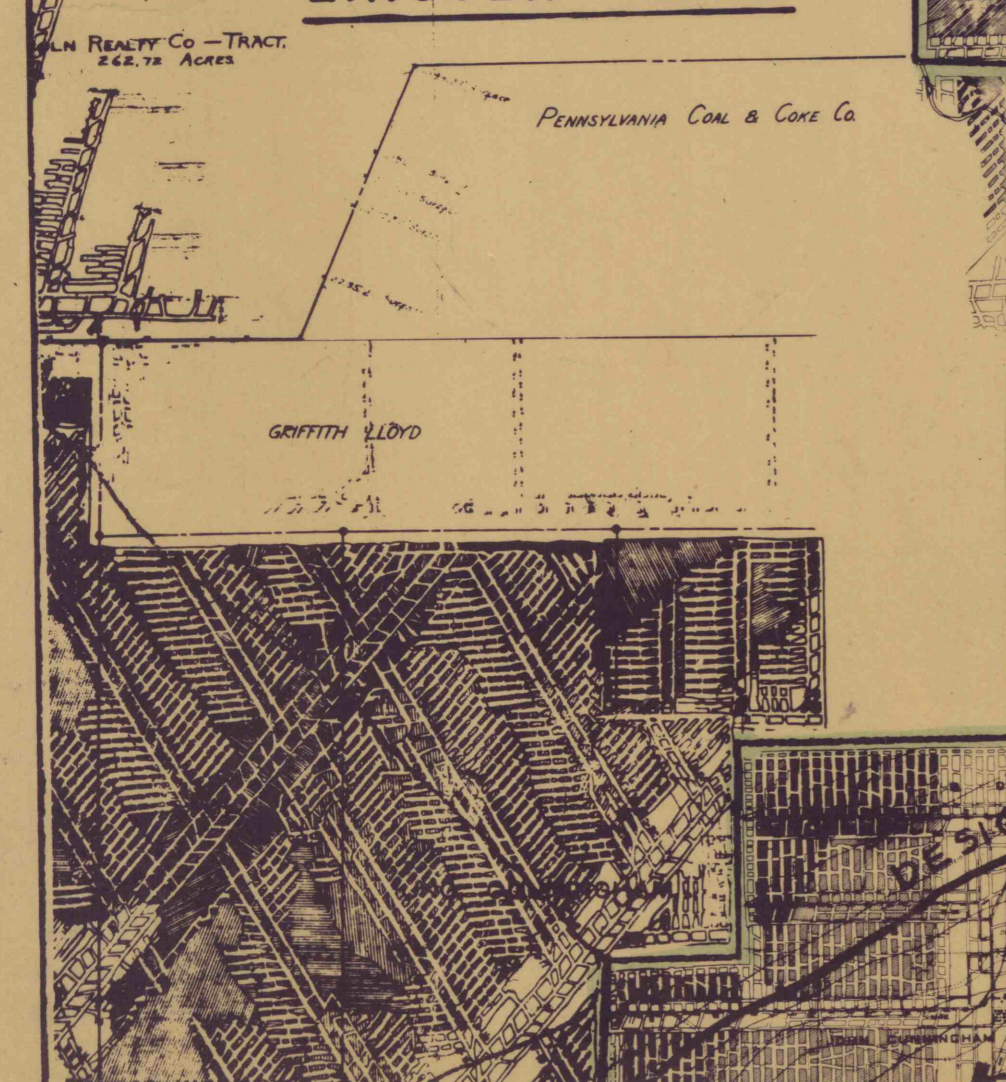

1" = 100'