


JOHNSTOWN COAL & COKE CO
 "D" SEAM PROPERTY

SCALE 1" = 1000'

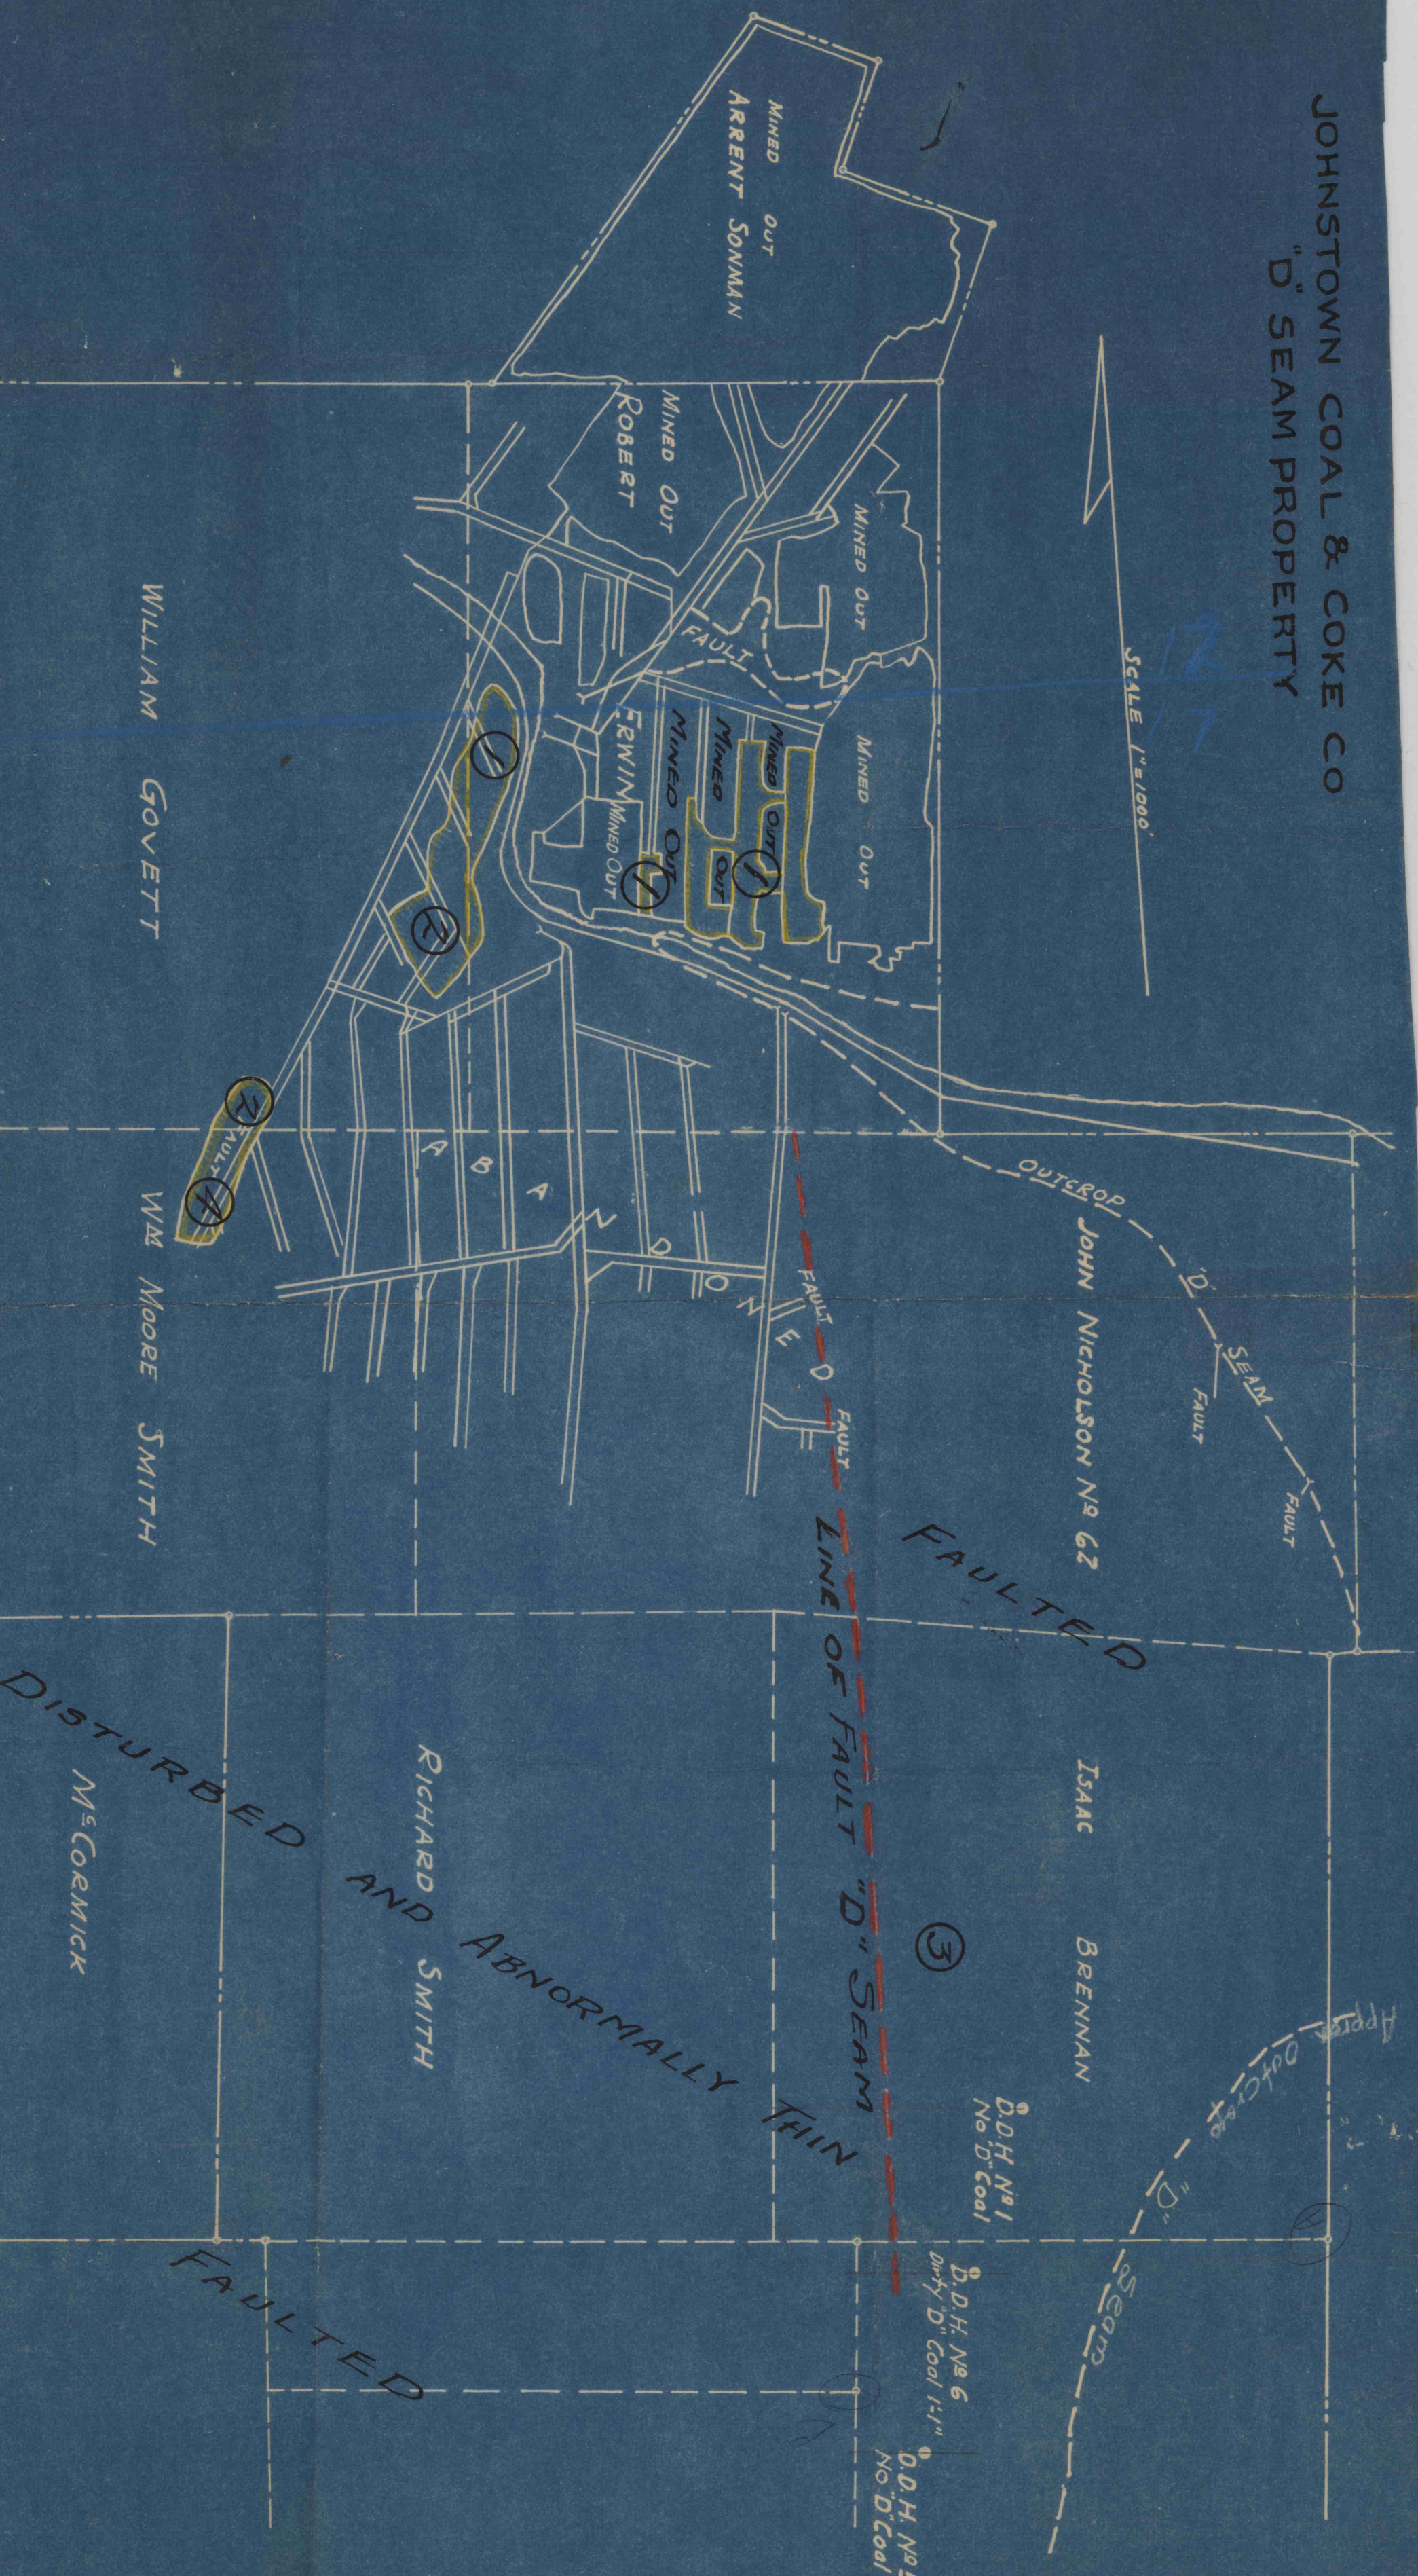

WILLIAM GOVETT

WM MOORE SMITH

RICHARD AND SMITH

ISAAC BRENNAN

DISTURBED
 M^cCORMICK

③

D.D.H. No 1
 No D. Coal

D.D.H. No 6
 Dirty D. Coal 1 1/2"

D.D.H. No 5
 No D. Coal

Approx outcrop

FAULTED

FAULTED

LINE OF FAULT "D" SEAM

JOHN NICHOLSON No 62

OUTCROP

SEAM

FAULT

FAULT

FAULT

FAULT

MINED OUT

ROBERT

MINED OUT

MINED OUT

FAULT

MINED OUT

MINED

MINED

ERWIN

MINED OUT



















 ARRENT SONMAN