


⑤ Jones and Williams 279±

① Carroll Land 54.95, 110.8±


③ Michael Bradley 60.95±


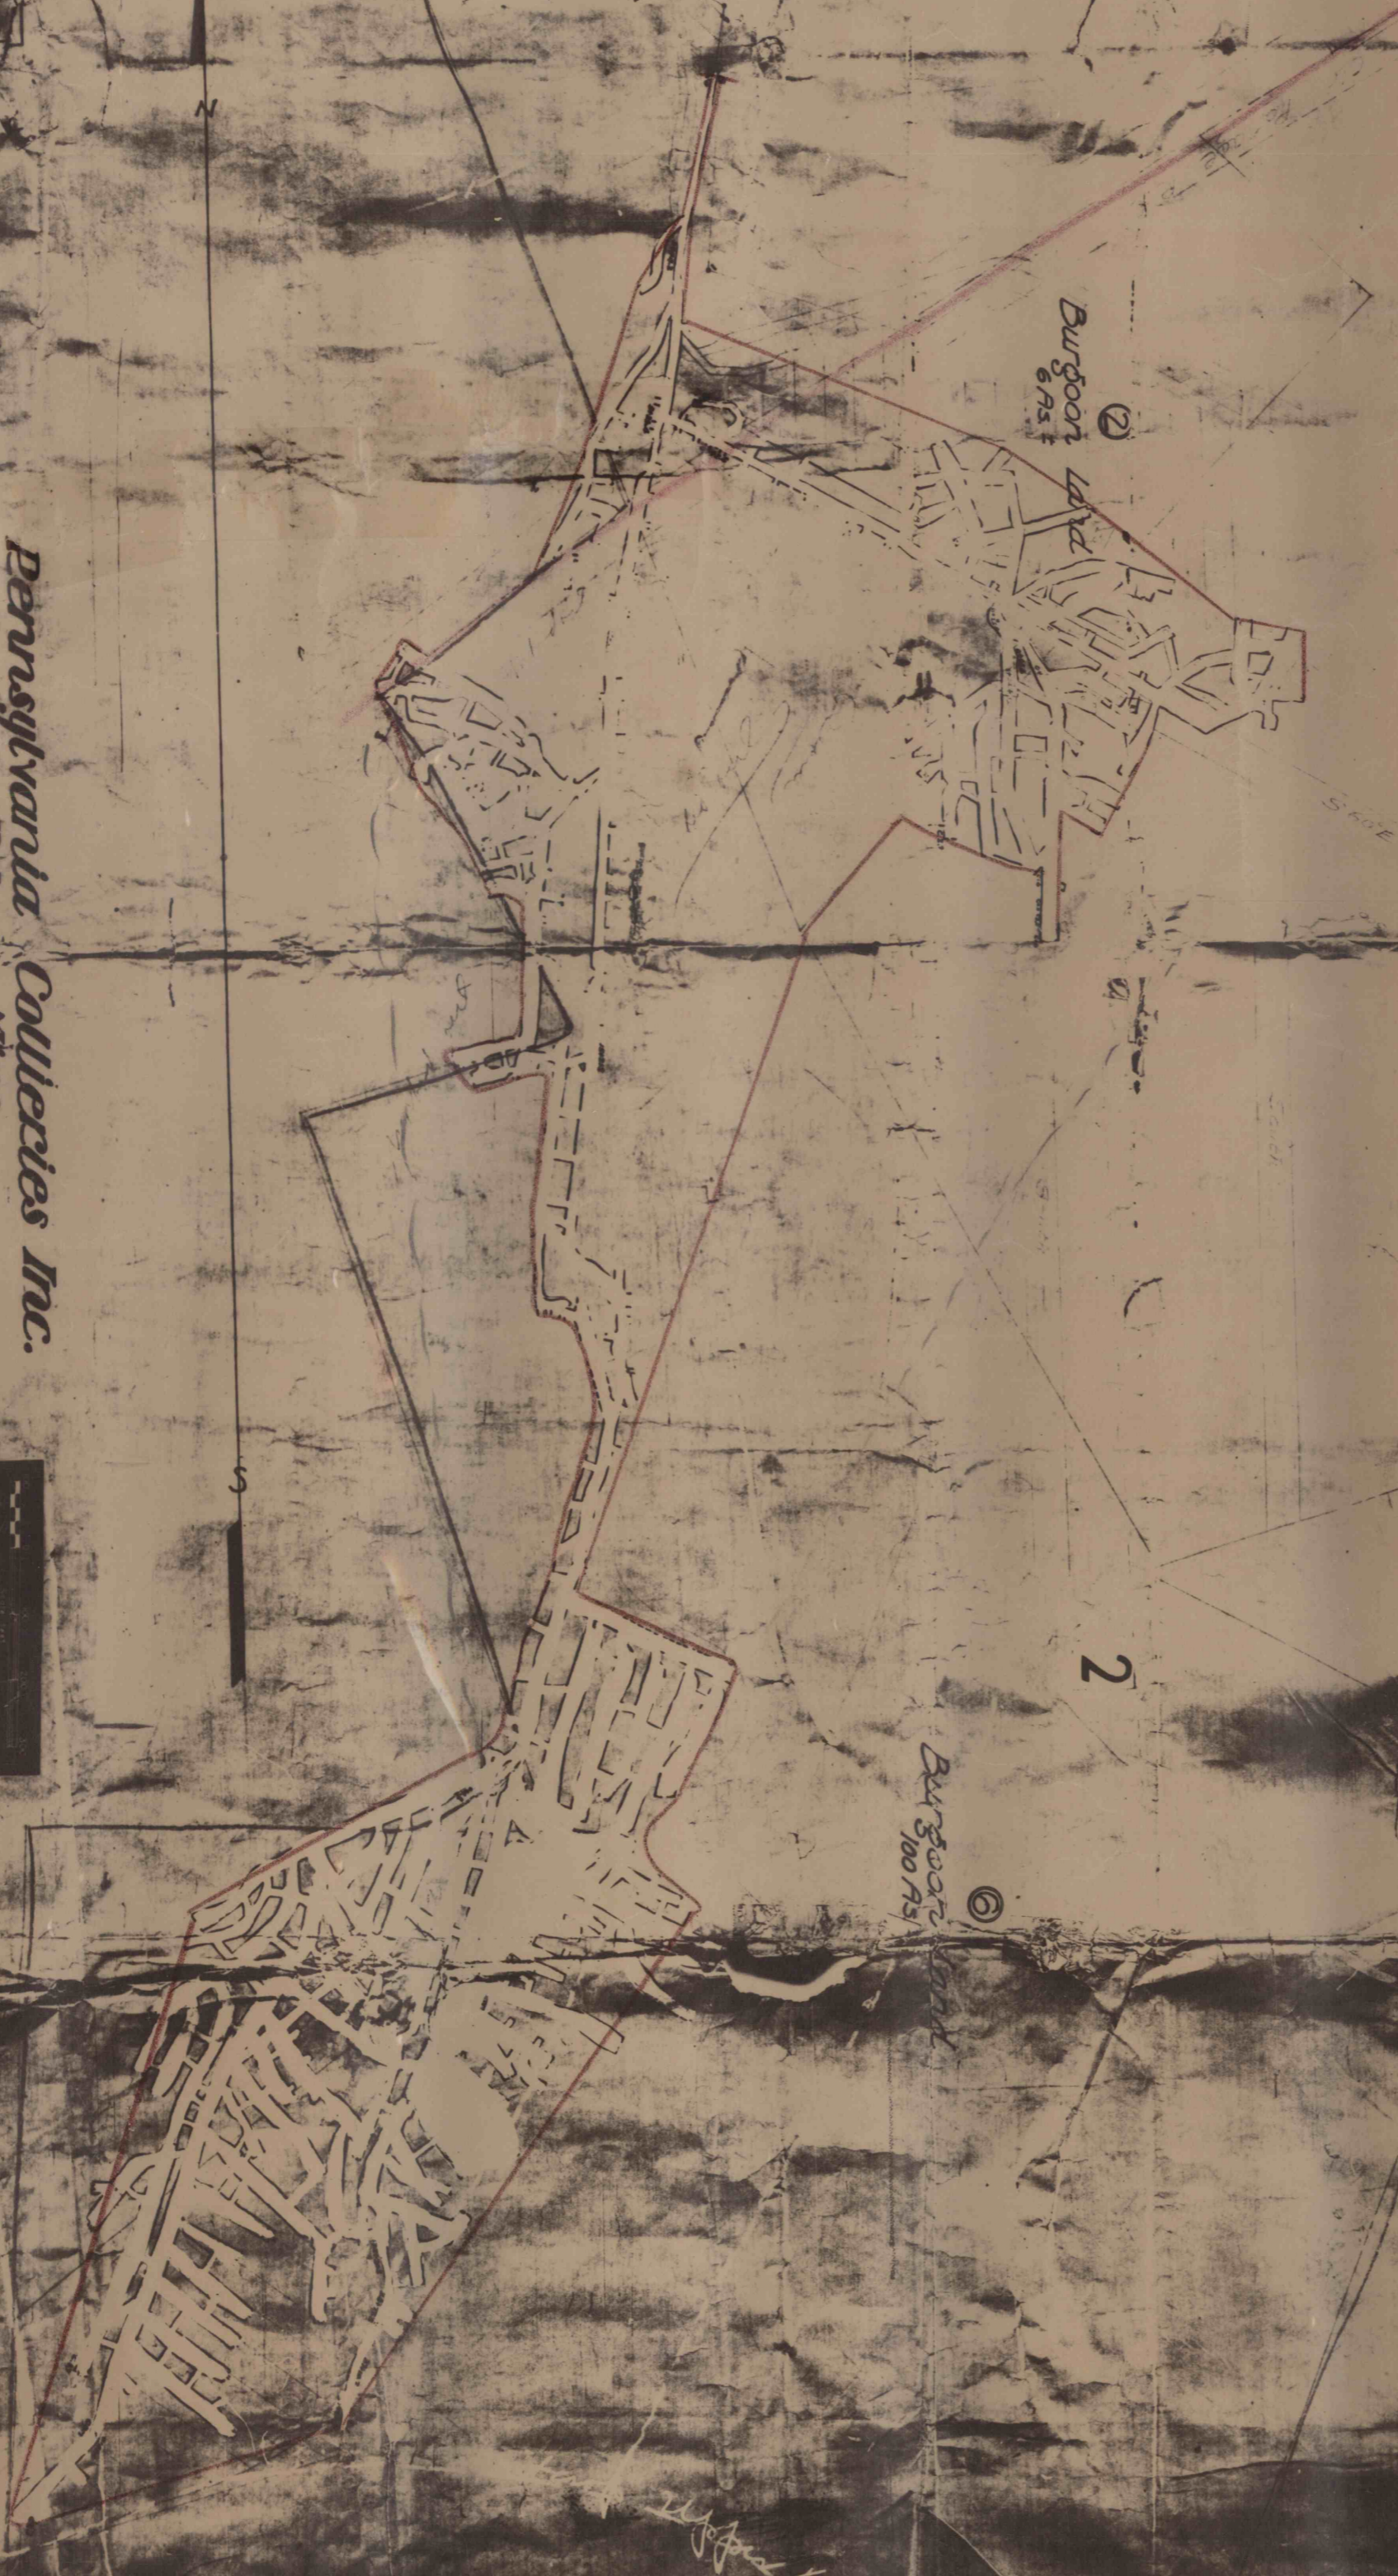

Pennsylvania Collecties Inc.

Kokomo Mine

subdivided by
Cresson Township, Cambria Co., Penna.

Scale 1"=100'
J. E. Dillingham & Co.
Engineering Service Co. Inc.
Nov. 1919.

03007

309

35X 302568

Original Mine Book